
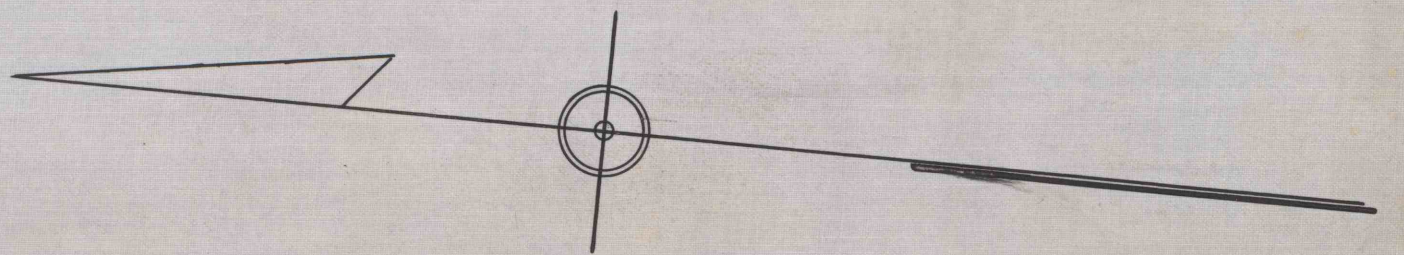


RUTH COAL CO.

ROCK HILL COAL & IRON CO.

J.C. DIEHL

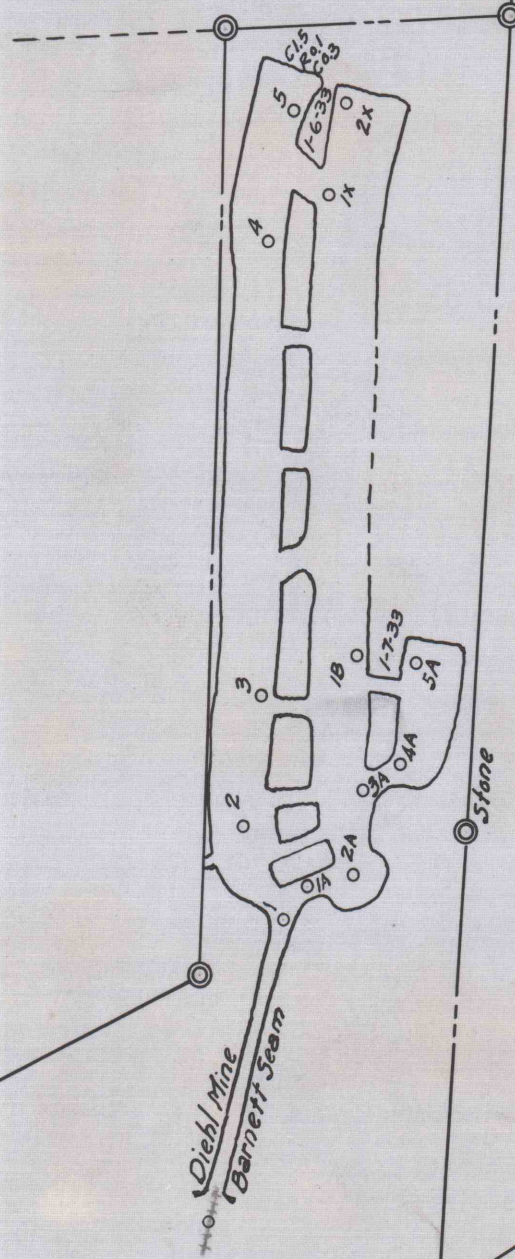

MAP  
of  
**DIEHL MINE**

OWNED AND OPERATED BY J.C. DIEHL  
BROAD TOP CITY - HUNTINGDON CO.

Scale 1"=100'

1933

Guy C. Askey Min. Eng.  
Bedford, Pa.