


**BROWN MINE WORKINGS
ALONG LINE OF JOHN LANGDON**
BROAD TOP TOWNSHIP — BEDFORD COUNTY
Scale: 1" = 100'

KELLY SEAM
Revised to 1914

Guy C. Askey Min. Engr.
Bedford, Pa.

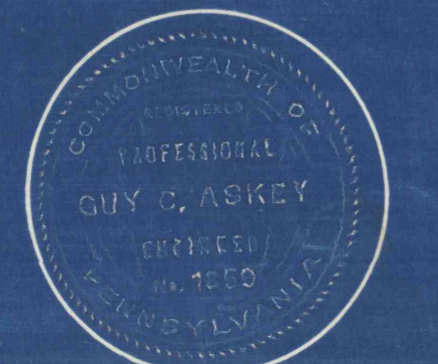

*Face of Duvall Shaft Workings,
from map by John Fulton, Min. Engr.
Dated Nov. 5-1873.*