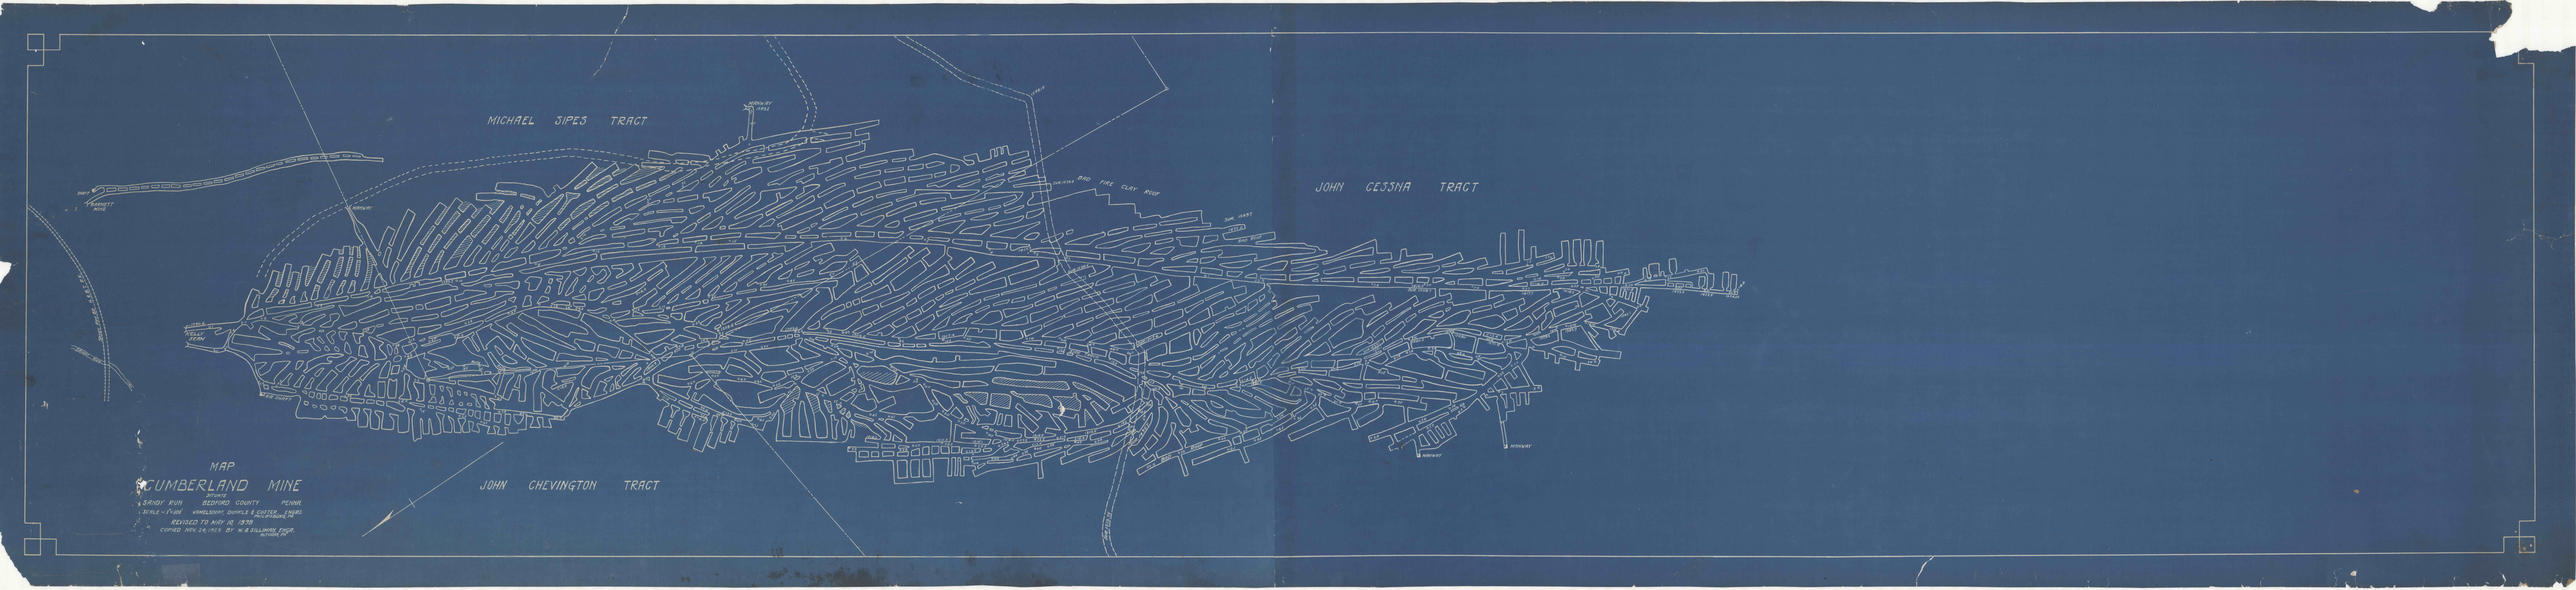
MICHAEL SIPES TRACT
JOHN CESSNA TRACT
JOHN CHEVINGTON TRACT
BAD FIRE CLAY RIDGE
MAP
CUMBERLAND MINE
SANDY RUN BEDFORD COUNTY PENNA
SCALE - 1" = 100'
REVISED TO MAY 18 1978