


BENJAMIN PENN TRACT
BROAD TOP ^{NOW} FUEL COMPANY


JOSEPH E. THORPE
WEBB & PILLING

JOHN HAMILTON

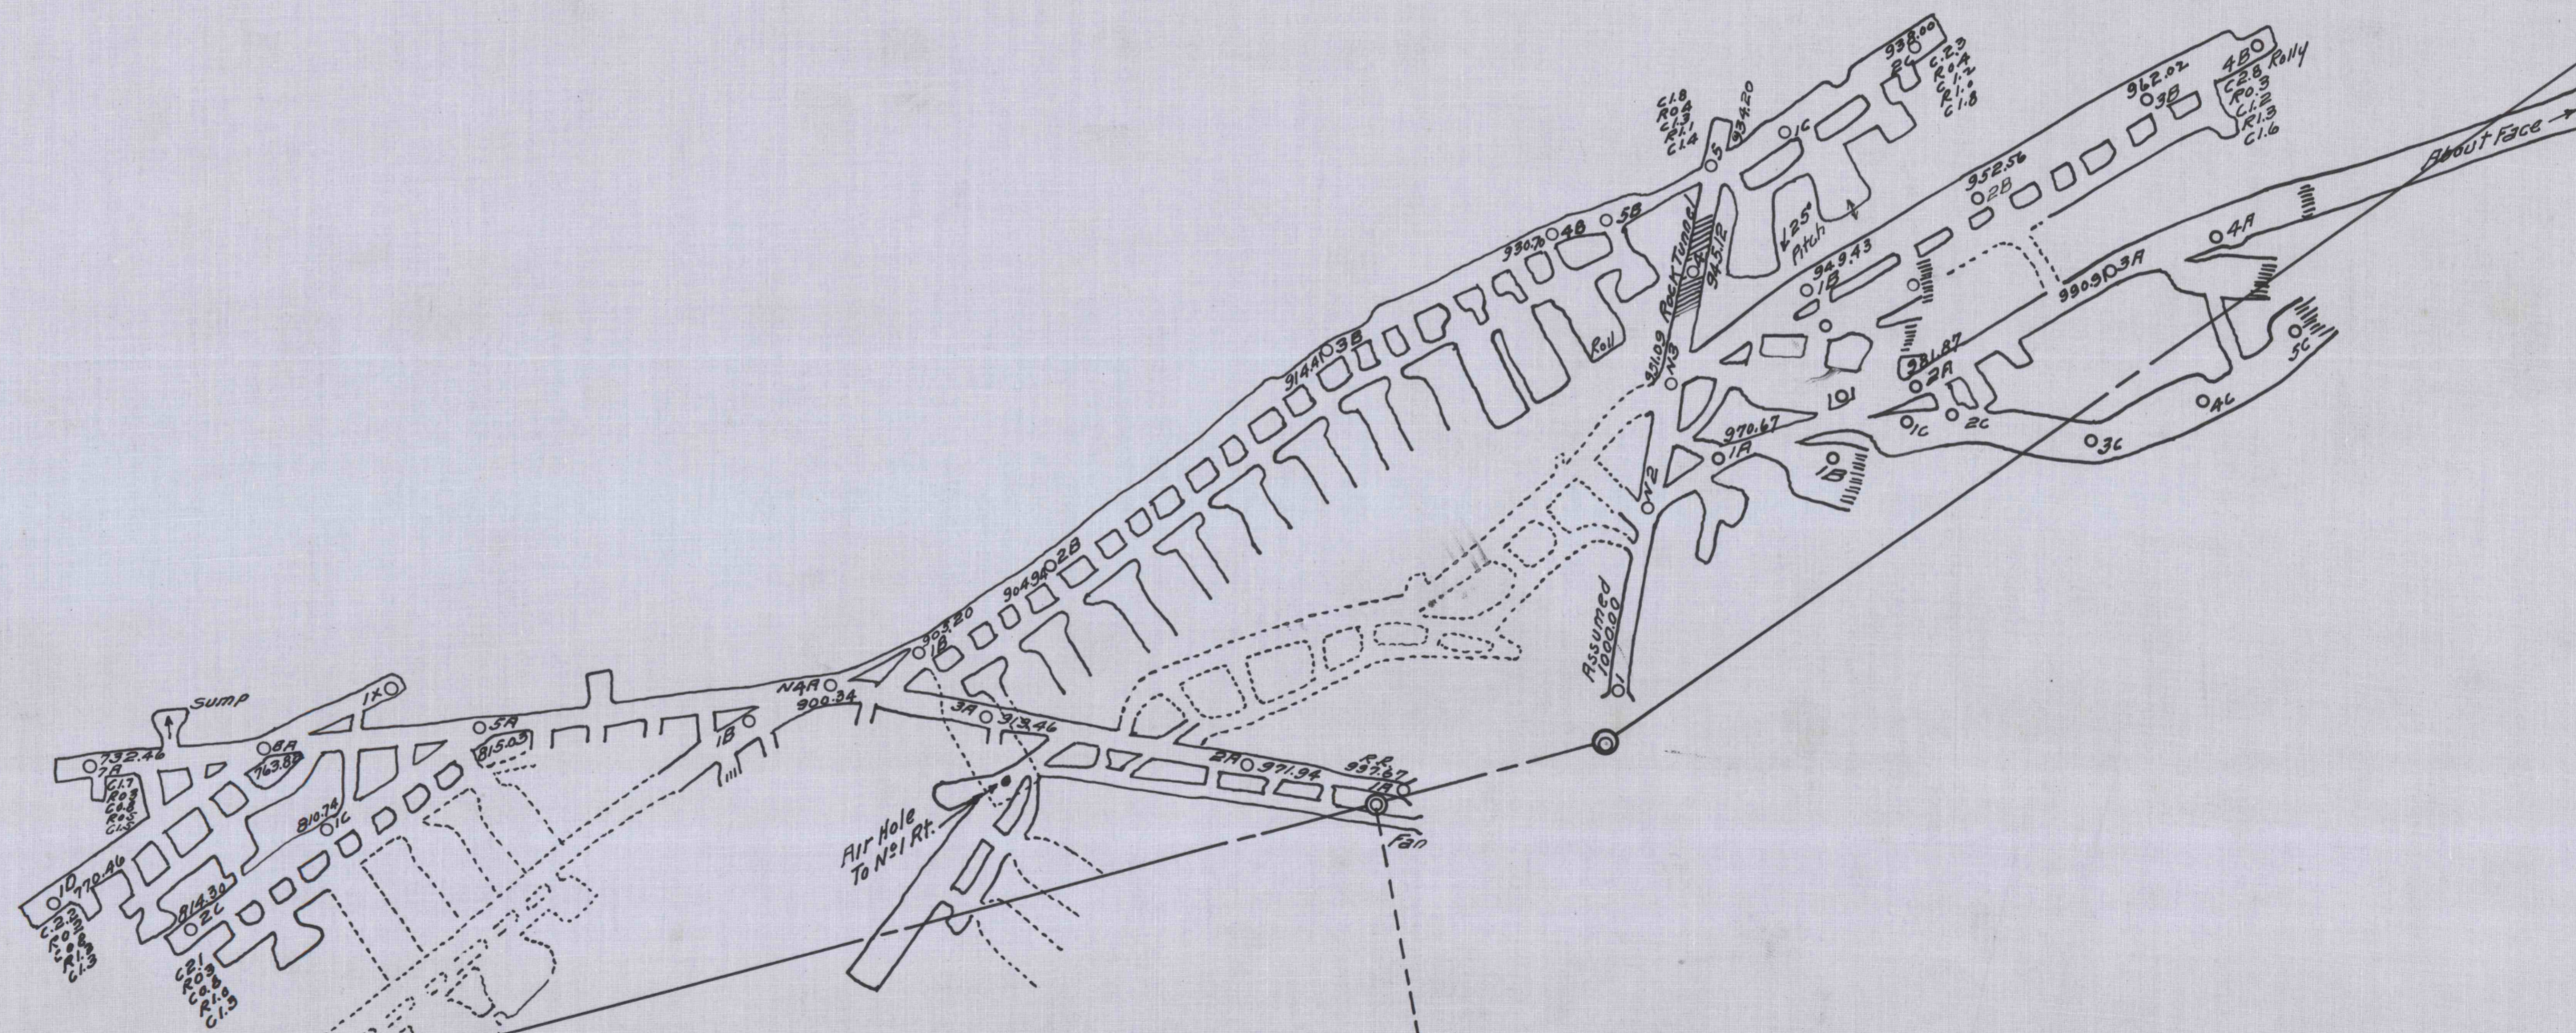

GEORGE HIKES

Lower Level
OLD WORKINGS
LENORE MINE

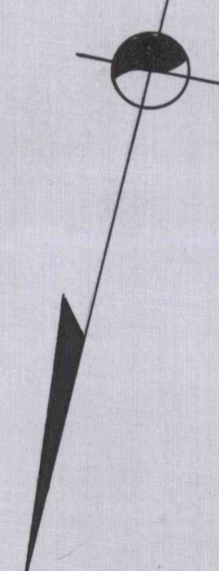

MAP OF LOUISE MINES

situated in
Broad Top Twp. Bedford County Pa.

Scale 1"=100'

Guy C. Askey M.E.
Bedford
Pa.

Property Lines shown
on this Map were taken
from old Maps