



P.H. Seary  
Thomas Drift.

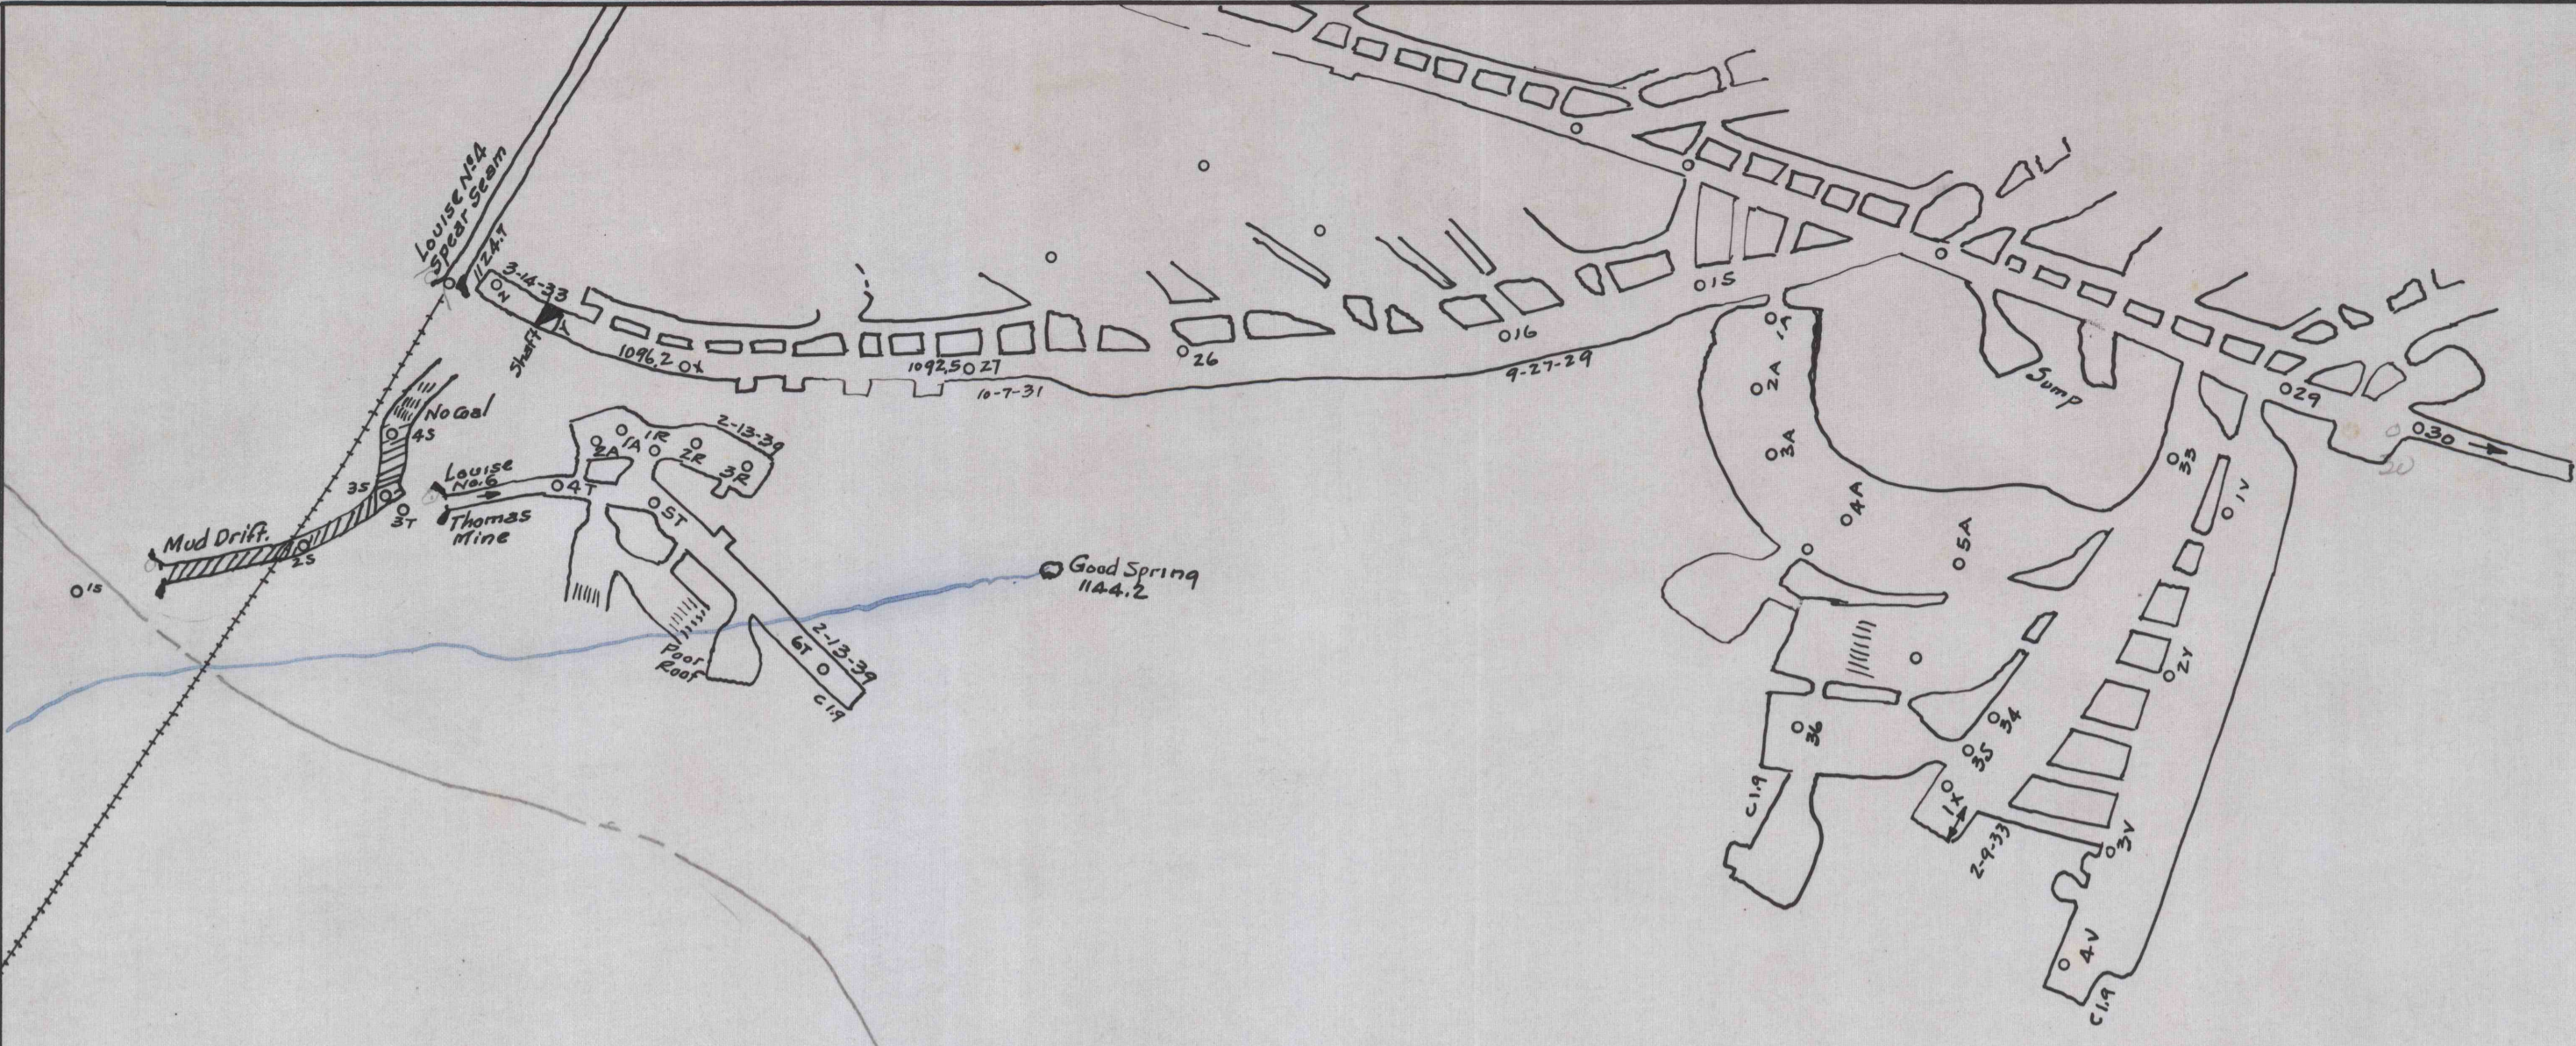

Approx. Outerop Spear Seam

BROADTOP FUEL CO.  
W.H. SPEER & SON

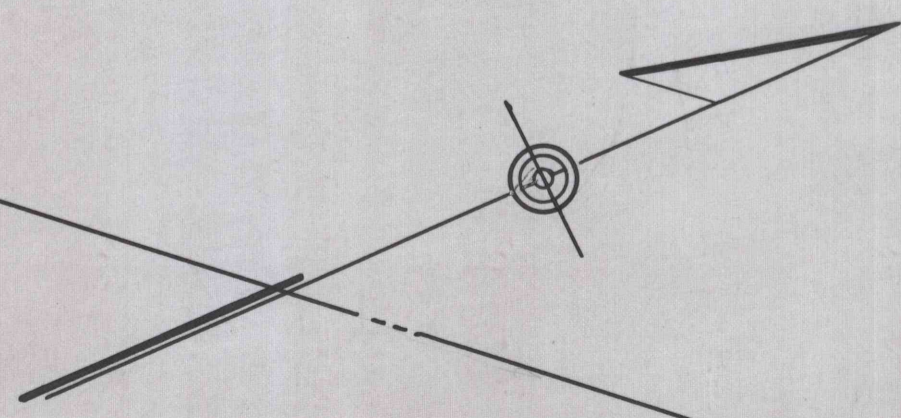

LOUISE No. 6 MINE  
OPERATED BY RUSSELL THOMAS  
BROADTOP TOWNSHIP - BEDFORD CO.  
Scale 1" = 100'

Guy C. Askey  
Bedford, Pa.

SMR-N4.