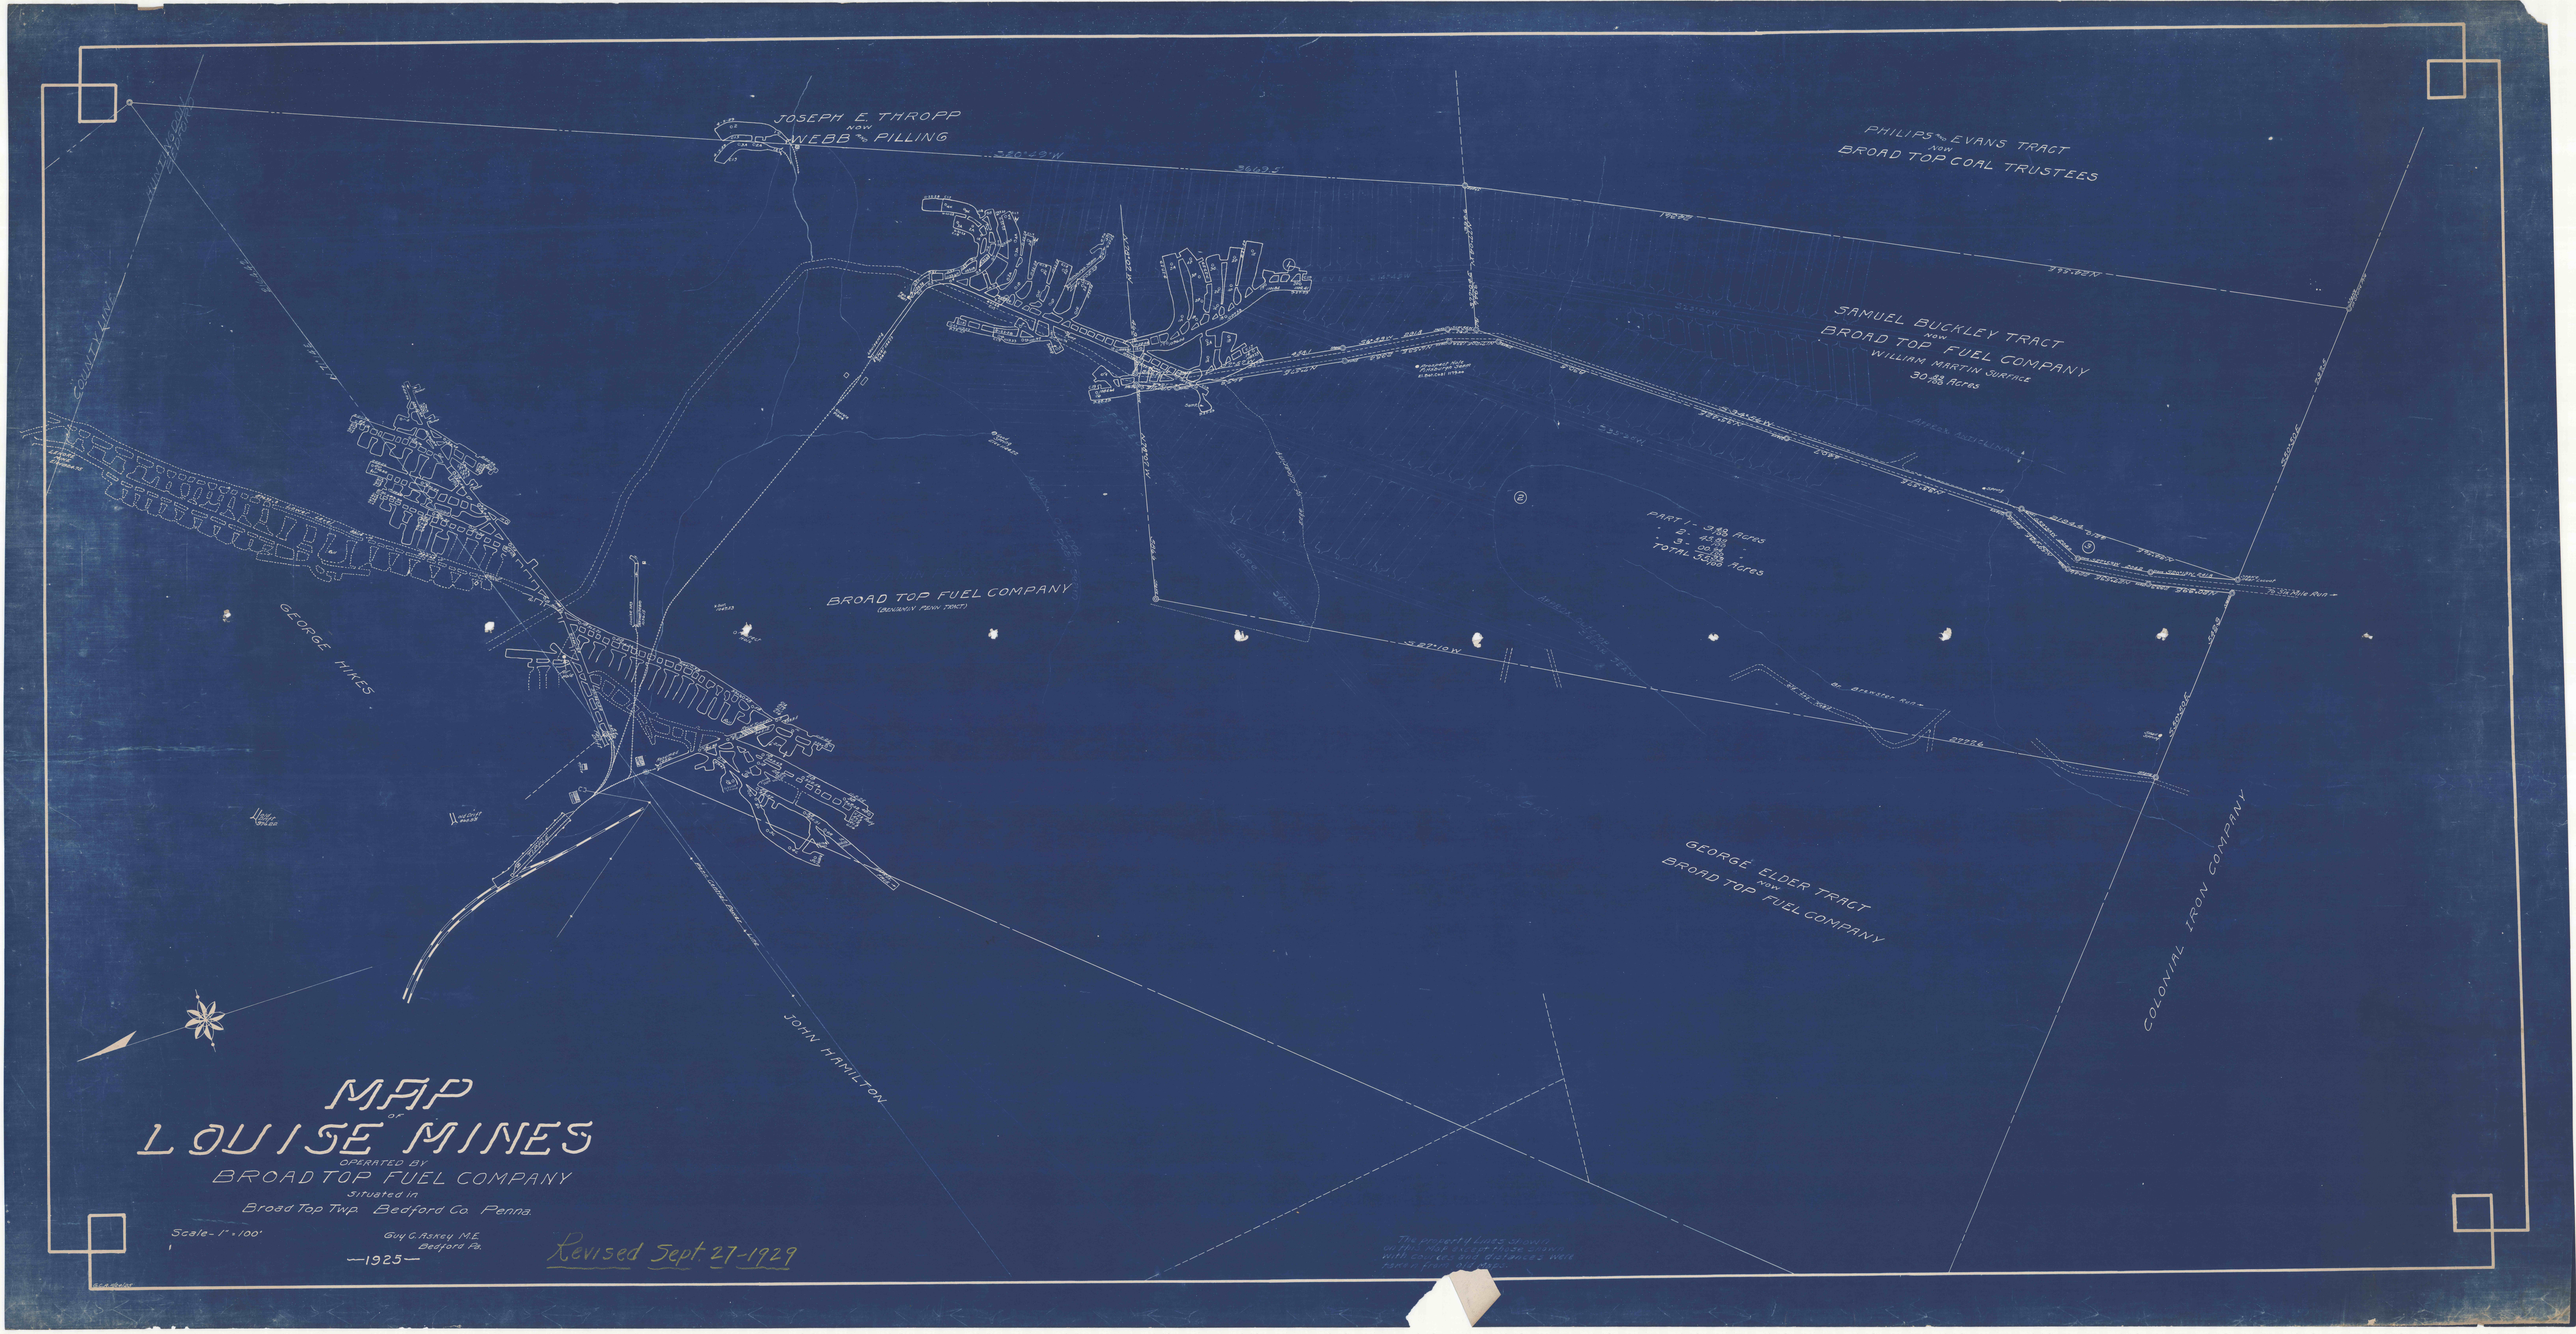
JOSEPH E. THROPP
now
WEBB & PILLING
PHILIPS & EVANS TRACT
now
BROAD TOP COAL TRUSTEES
SAMUEL BUCKLEY TRACT
now
BROAD TOP FUEL COMPANY
WILLIAM MARTIN SURFACE
30 3/8 Acres
PART 1 - 3 3/8 Acres
" 2 - 45 3/8 "
" 3 - 90 3/8 "
TOTAL 139 1/8 Acres
BROAD TOP FUEL COMPANY
(BOUGHT FROM TRACT)
GEORGE HINES
GEORGE ELDER TRACT
now
BROAD TOP FUEL COMPANY
COLONIAL IRON COMPANY
JOHN HAMILTON
MAP
OF
LOUISE MINES
OPERATED BY
BROAD TOP FUEL COMPANY
Situated in
Broad Top Twp. Bedford Co. Penna.
Scale - 1" = 100'
Guy C. Askey M.E.
Bedford Pa.
—1925—
Revised Sept 27-1929