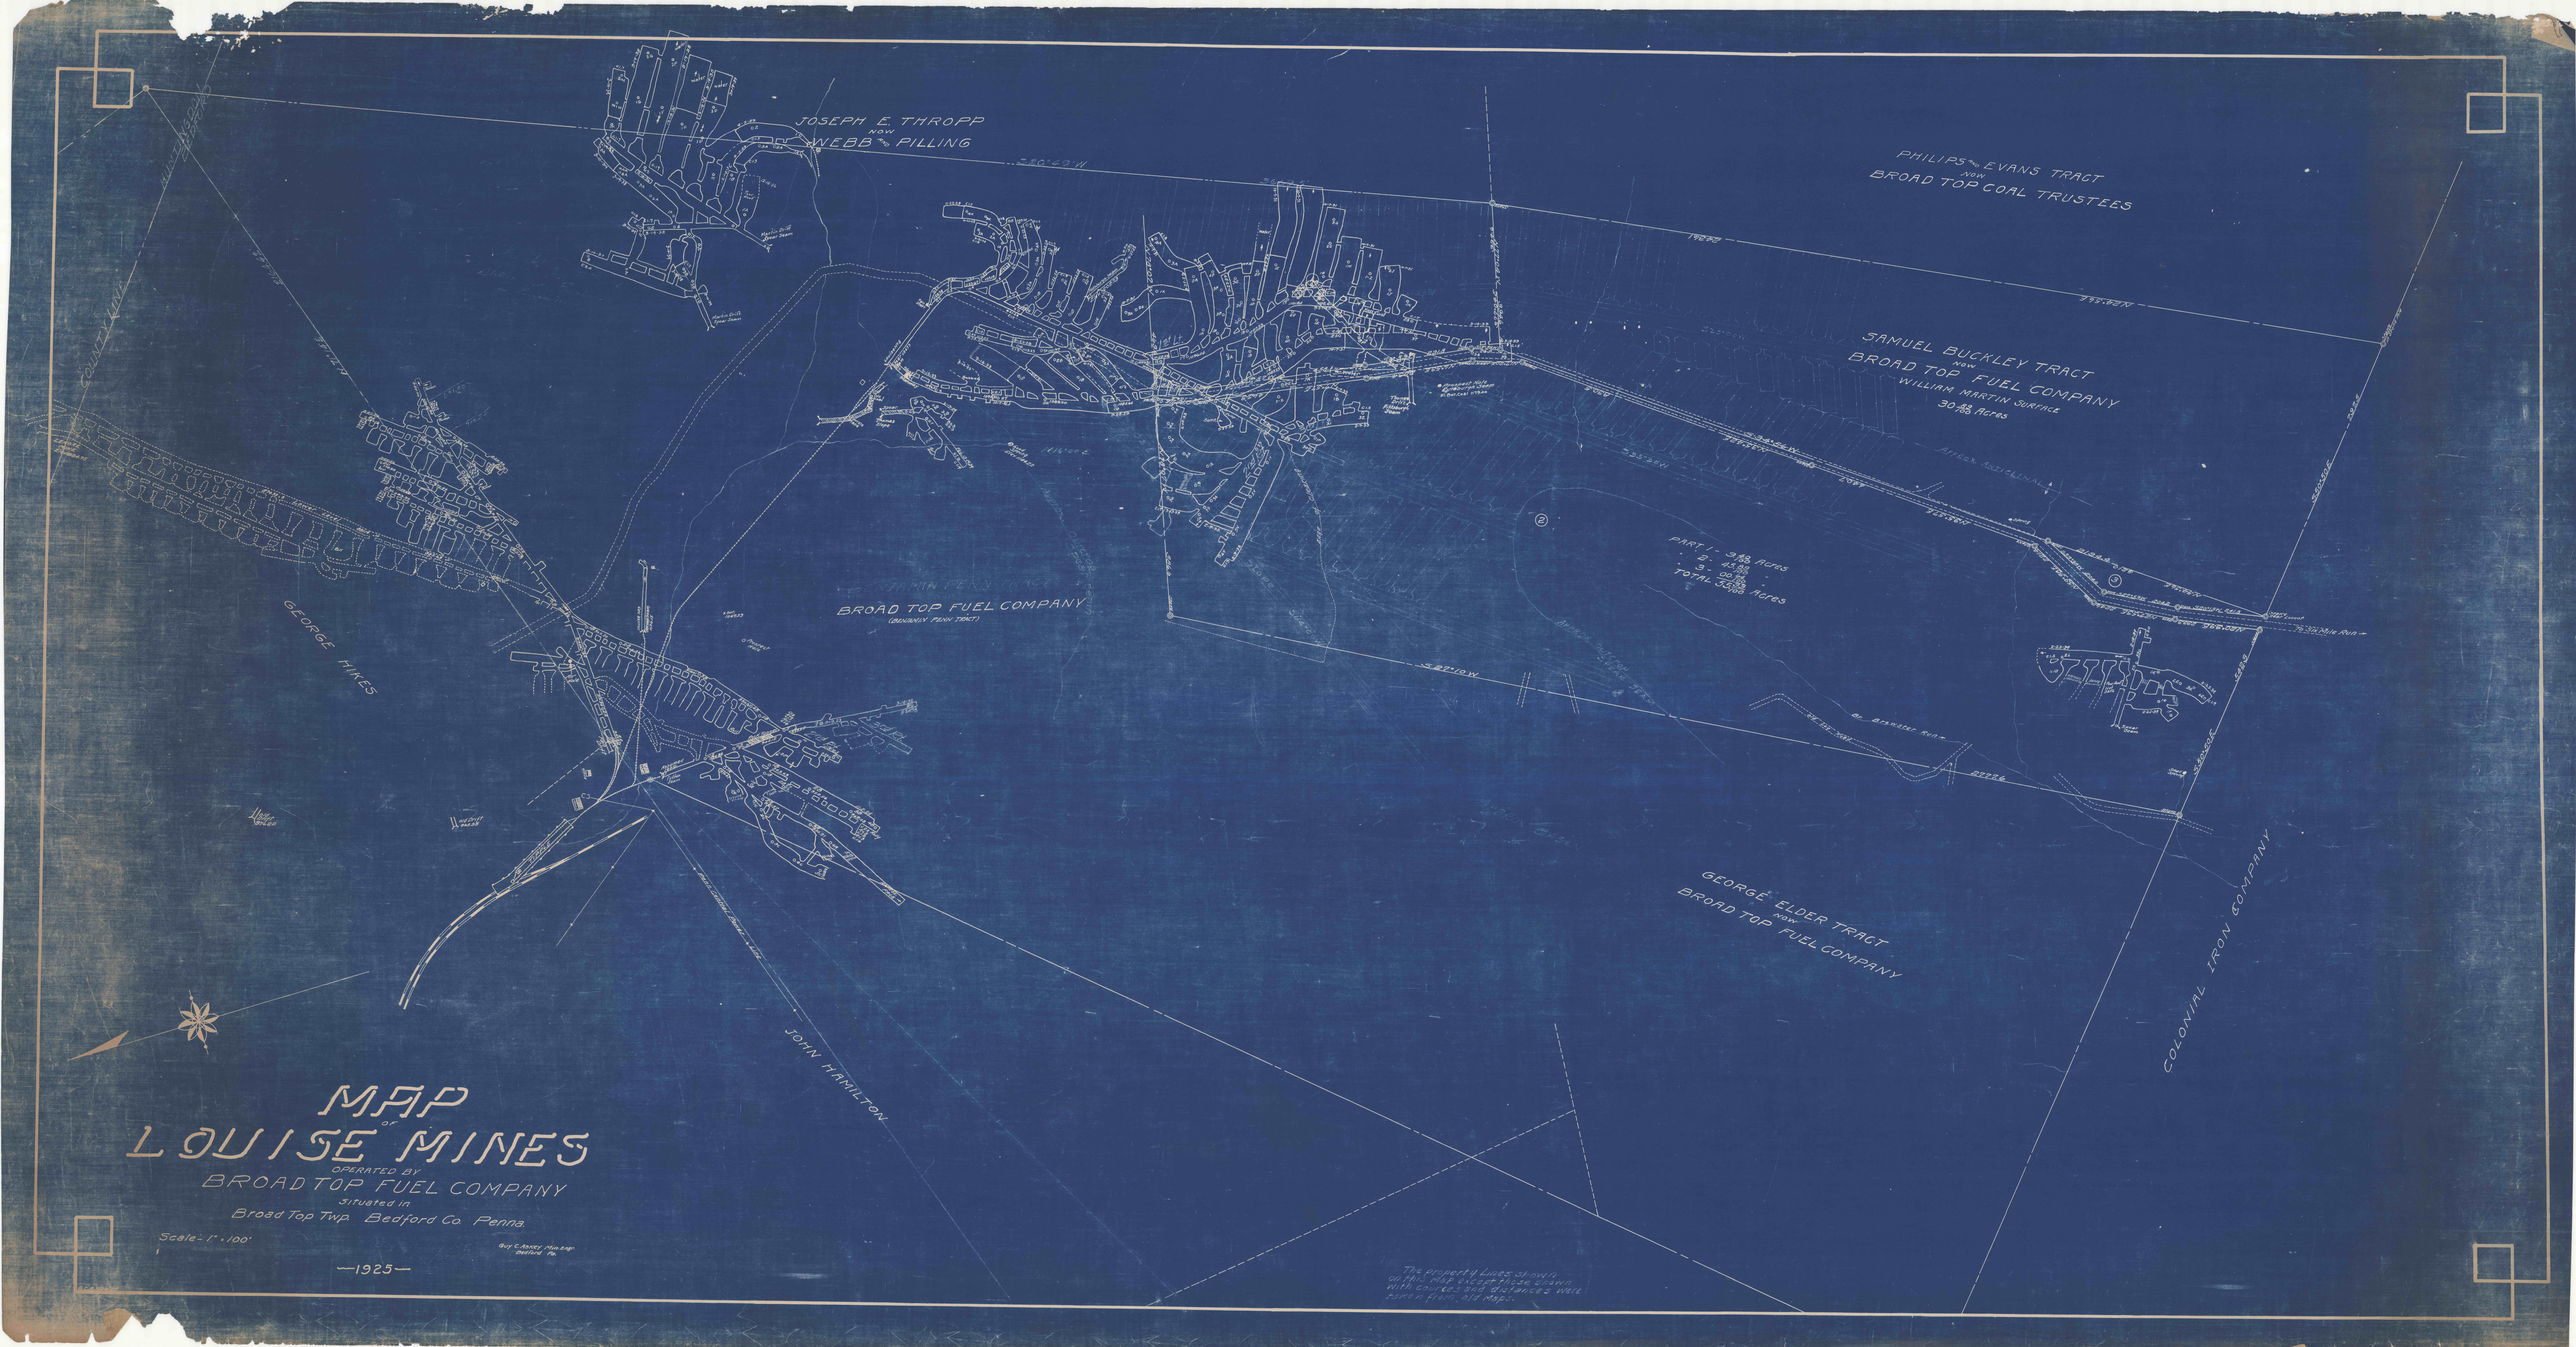
JOSEPH E. THROPP
now
WEBB & PILLING
PHILIPS & EVANS TRACT
now
BROAD TOP COAL TRUSTEES
SAMUEL BUCKLEY TRACT
now
BROAD TOP FUEL COMPANY
WILLIAM MARTIN SURFACE
30 4/8 Acres
BROAD TOP FUEL COMPANY
(formerly PENN TRACT)
PART 1 - 3 4/8 Acres
2 - 45 8/8
3 - 20 8/8
TOTAL 37 1/8 Acres
GEORGE HIKES
GEORGE ELDER TRACT
now
BROAD TOP FUEL COMPANY
JOHN HAMILTON
COLONIAL IRON COMPANY
MAP
OF
LOUISE MINES
OPERATED BY
BROAD TOP FUEL COMPANY
Situated in
Broad Top Twp. Bedford Co. Penna.
Scale- 1" = 100'
Guy C. Abney Min. Engr.
Oakland Pa.
—1925—
The property lines shown on this map except those drawn with courses and distances were taken from old maps.