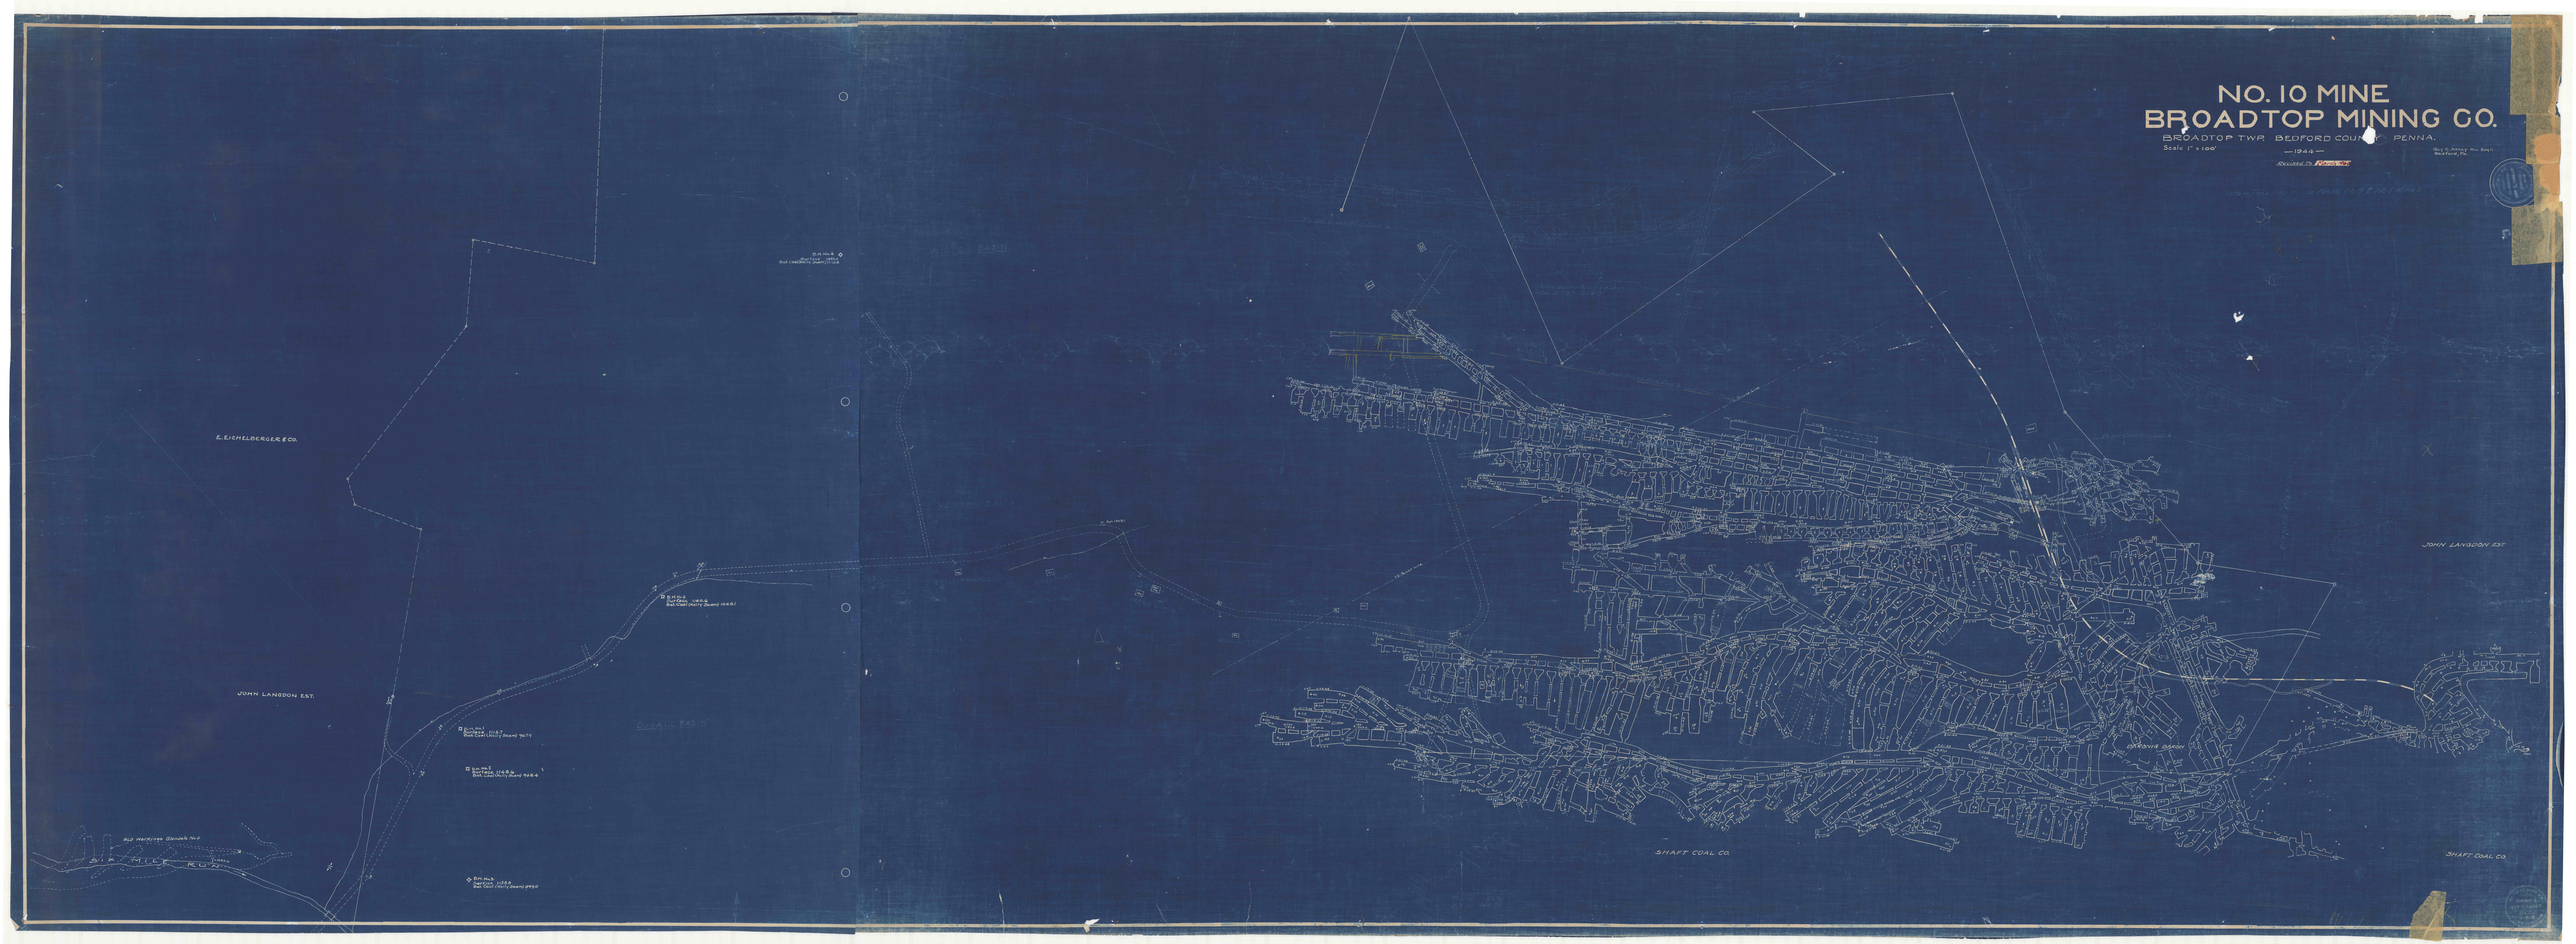
NO. 10 MINE
BROADTOP MINING CO.
BROADTOP TWP. BEDFORD COUNTY PENNA.
Scale 1" = 100'
—1944—
Revised to
E. EICHELBERGER & CO.
JOHN LANGDON EST.
JOHN LANGDON EST.
SHAFT COAL CO.
SHAFT COAL CO.
SIX MILE RUN