

JAMES M. McINTYRE & CO.

BUNKER HILL COAL CO.

MAP OF BACON No 5 MINE

OPERATED BY
E. EICHELBERGER & CO.
Broad Top Township — Bedford County


Scale 1"=100'

By C. Atterly, Inc.
Bedford, Pa.

KELLY SEAM
— 1928 —

MINE OPERATORS
No. 5 Duvall & White
No. 6 Neville & Everitts
No. 7 W. H. Martin

Revised

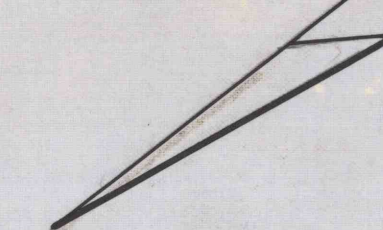

JAMES M. McINTYRE & CO.



E. EICHELBERGER & CO.
CUSHERTON TRACT

COLONIAL TRACT

WIGTON TRACT

EVERETT-DAYTON CO.

COLONIAL IRON CO.

IN BARNETT SEAM

ANTICLINAL

Note - Property Line
Surveys made prior to Sept. 3, 1924
are by Wemelsdorf, Dunkle & Guster