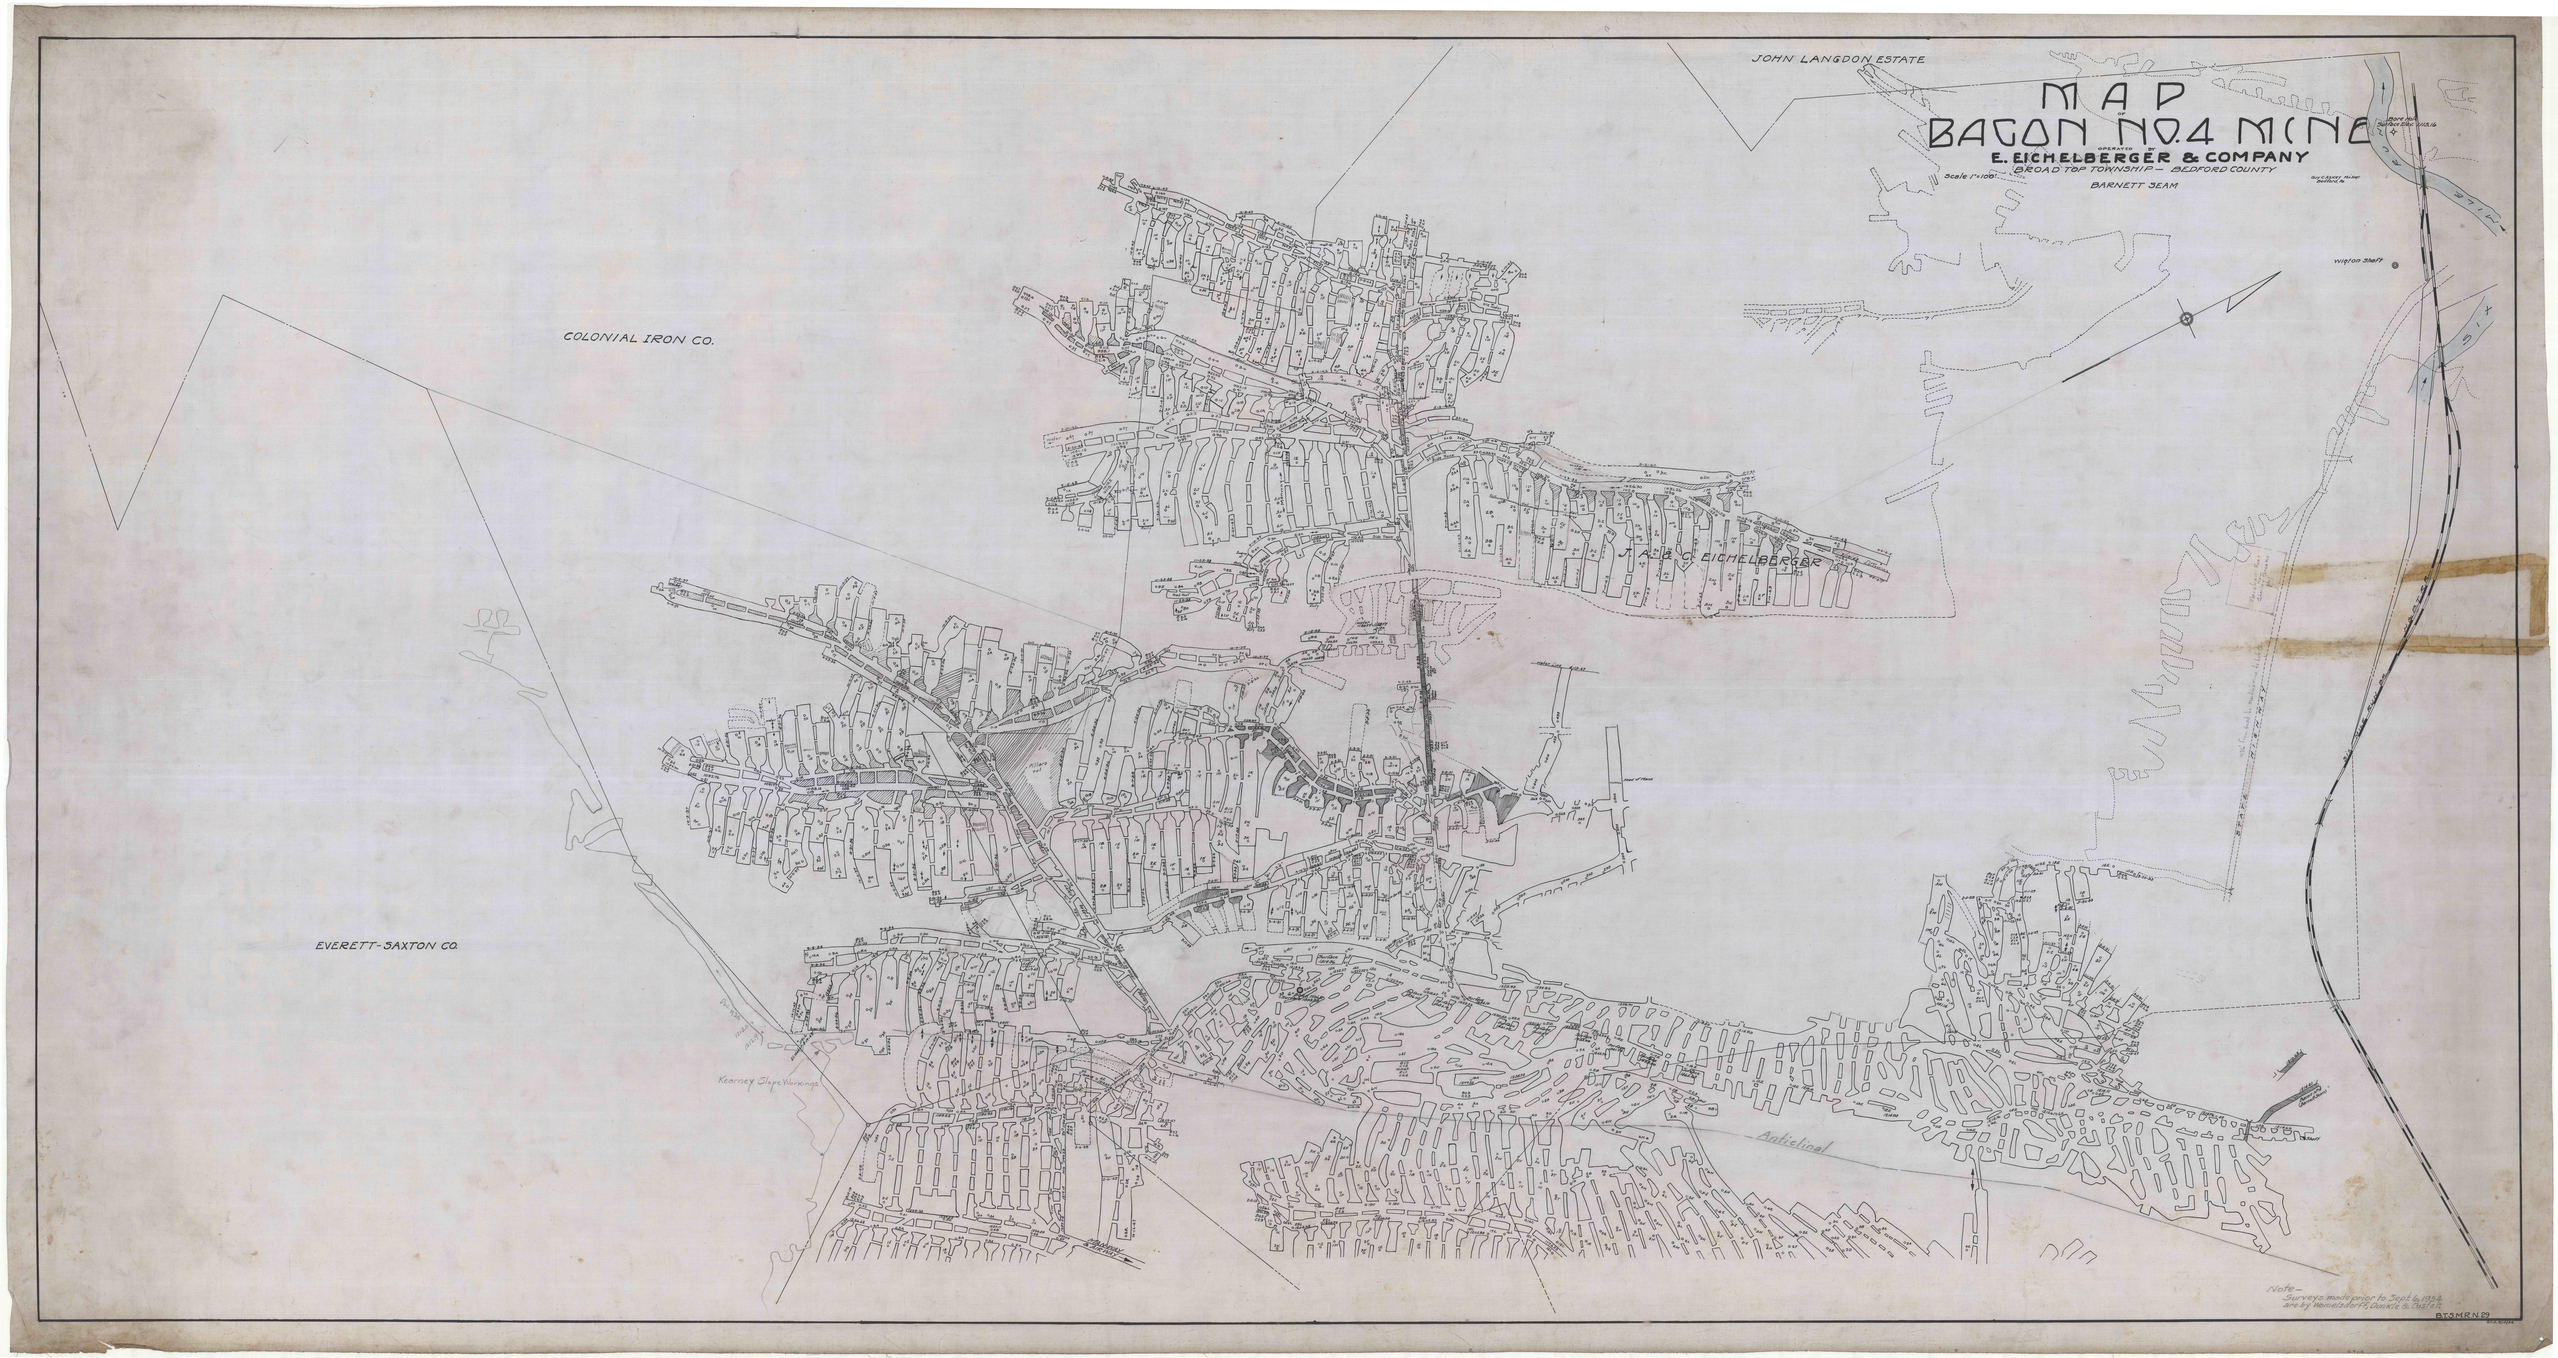
MAP
BAGON No. 4 MINE
OPERATED BY
E. EICHELBERGER & COMPANY
BROAD TOP TOWNSHIP — BEDFORD COUNTY
Scale 1"=100'
BARNETT SEAM
JOHN LANGDON ESTATE
COLONIAL IRON CO.
EVERETT-SAXTON CO.
J. A. & G. EICHELBERGER
Kearney Slope Workings
Anticlinal
Winton Shaft
Note—
Surveys made prior to Sept. 6, 1924
are by Hunsicker, Lawrie & Cuyler.