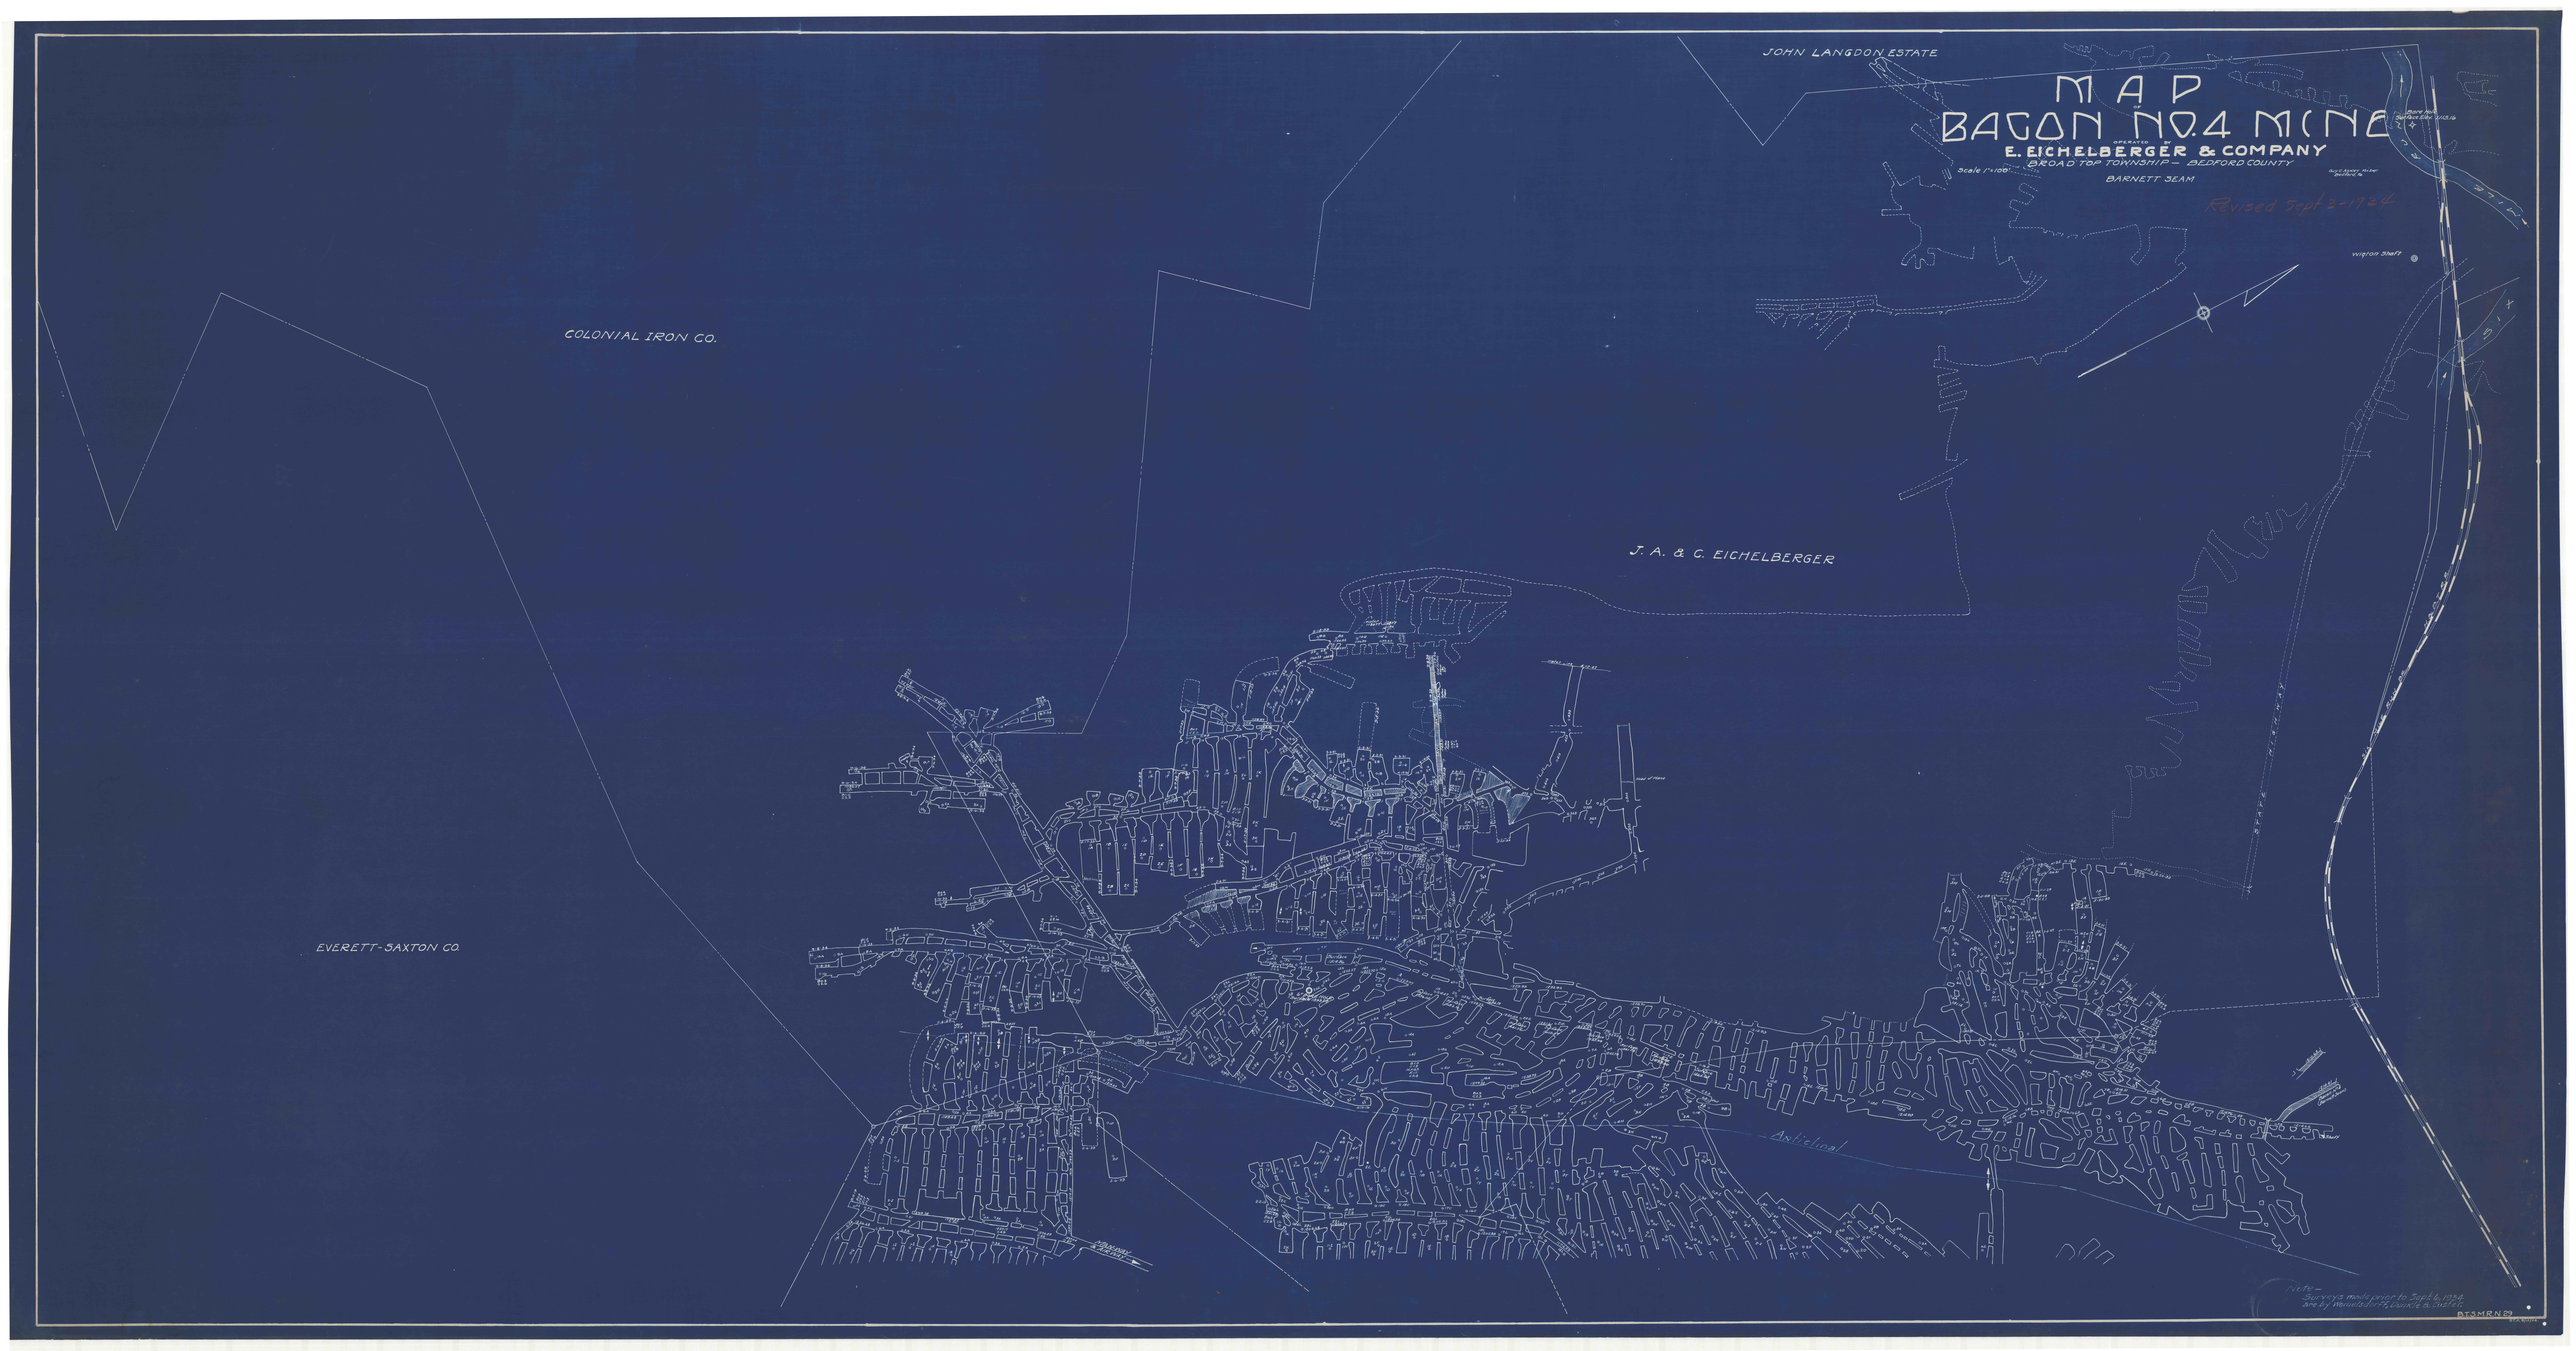
MAP
BAGON NO.4 MINE
OPERATED BY
E. EICHELBERGER & COMPANY
BROAD TOP TOWNSHIP — BEDFORD COUNTY
Scale 1"=100'
BARNETT SEAM
Revised Sept 3-1924
Wilton Shaft
JOHN LANGDON ESTATE
COLONIAL IRON CO.
J. A. & C. EICHELBERGER
EVERETT-SAXTON CO.
Axfield
Note—
Surveys made prior to Sept 6, 1924
are by Hensilsorf, Lockie & Custer.
DTJMRND