


HARRY C. MCCLAIN

Note:
Helm Coal Co. removed the upper bench
of coal in 1945.
H.M. Clevenger did not extend the Highwall
but he did remove the lower bench of coal
in 1959 from this area.

WARREN H. REED

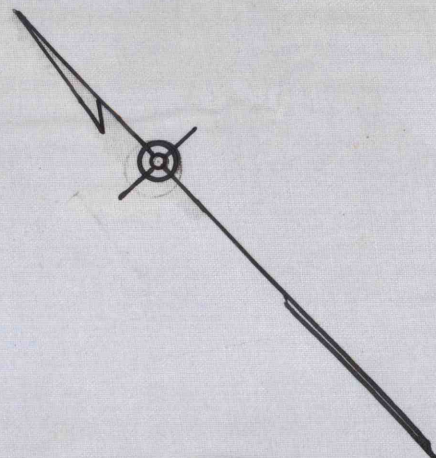

Broadtop
No. 1

Highwall 1945
to Nov. 1963

C 1.6
R 1.0
R 1.5
R 0.6
C 1.5

Ht. 25'

Fulton Seam

0.2 Ac.
Edge Spoil Pile
by H.M. Clevenger
Nov. 1963

Edge Spoil Pile
by Helm Coal Co.
Completed 1945

STRIPPING OPERATION BY
HERMAN M. CLEVINGER
CARBON TOWNSHIP - HUNTINGDON COUNTY

Scale: 1" = 100'

GUY C. ASKEY, P.E.
Bedford, Pa.

Nov. 1963

Private Road

0.8 Mi. To State Hwy. R. 913
Near Dudley.

MILLER RUN

N.74, AT-24