


J. Simpson Africa E. S. McMurtrie

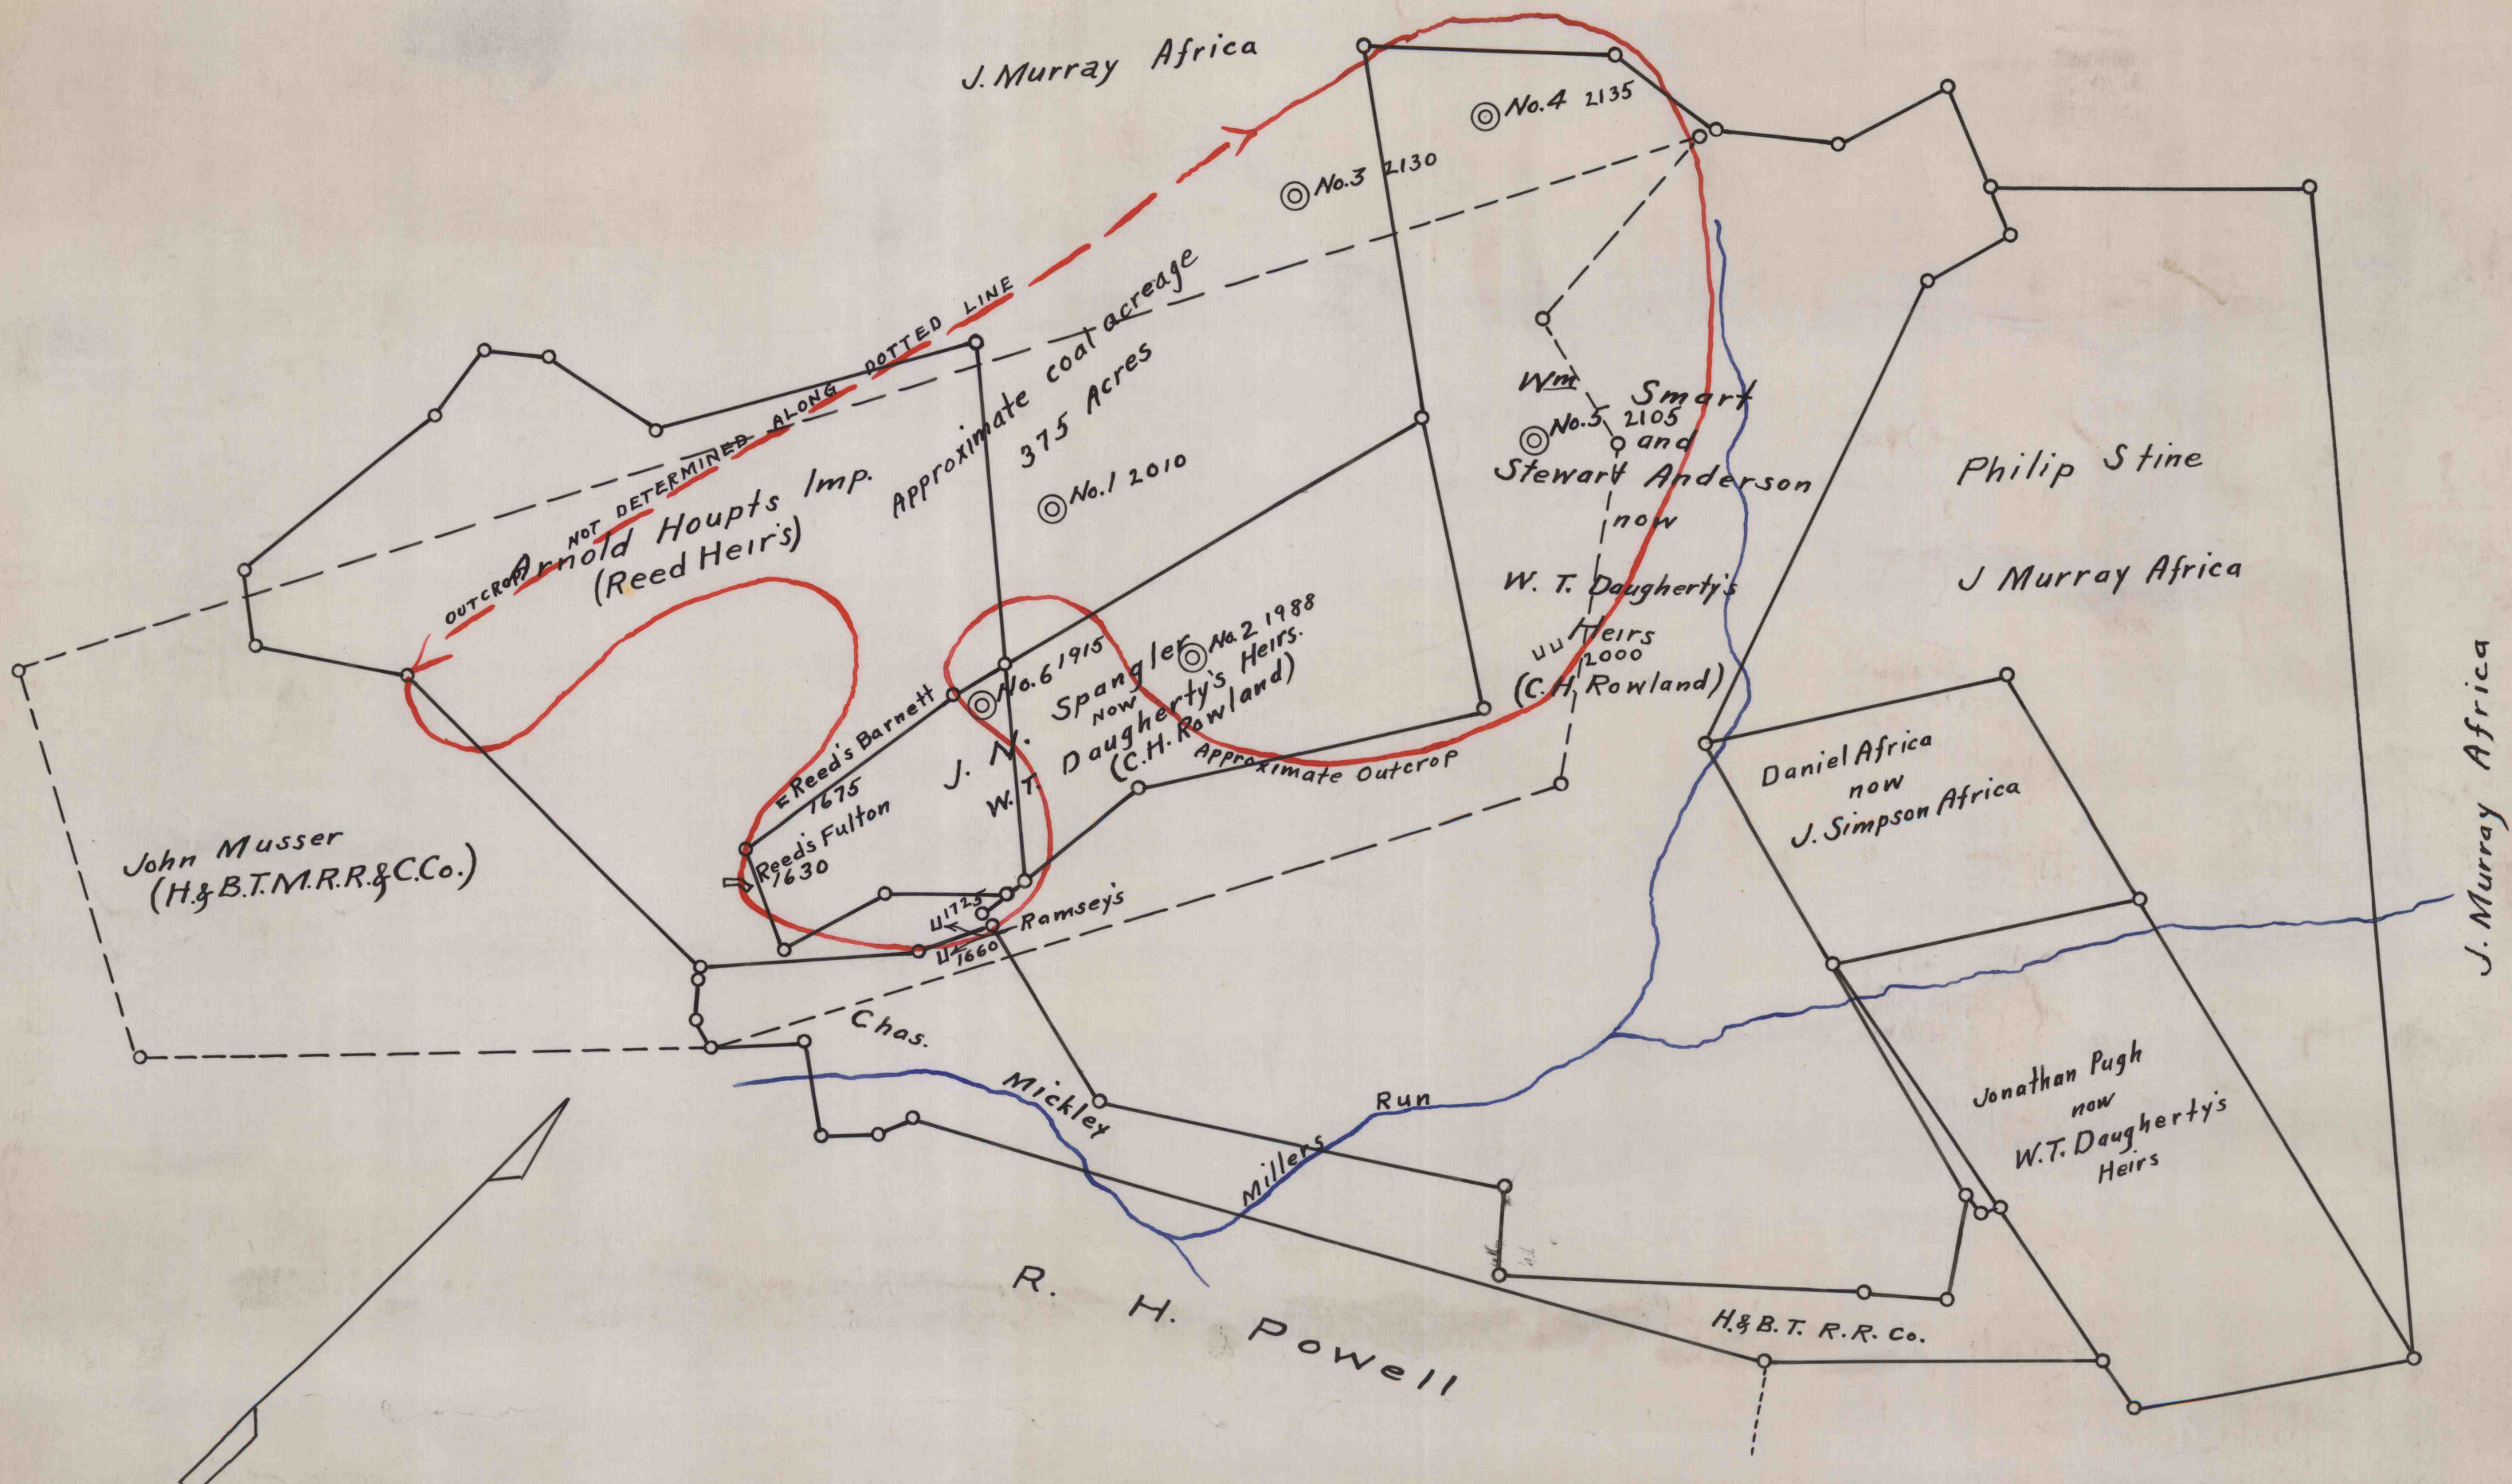

Made by J Murray Africa 1882

Elias Wiest & Others
J. Murray Africa

Traced & Drill Locations
added by R. D. Bridges 1916