



NEW ENTERPRISE STONE & LIME CO.

NEW ENTERPRISE STONE & LIME CO.

CLAIR BAKER  
(Surface only)

JOHN MELIUS  
(Surface)

KAY COAL MINING CO.

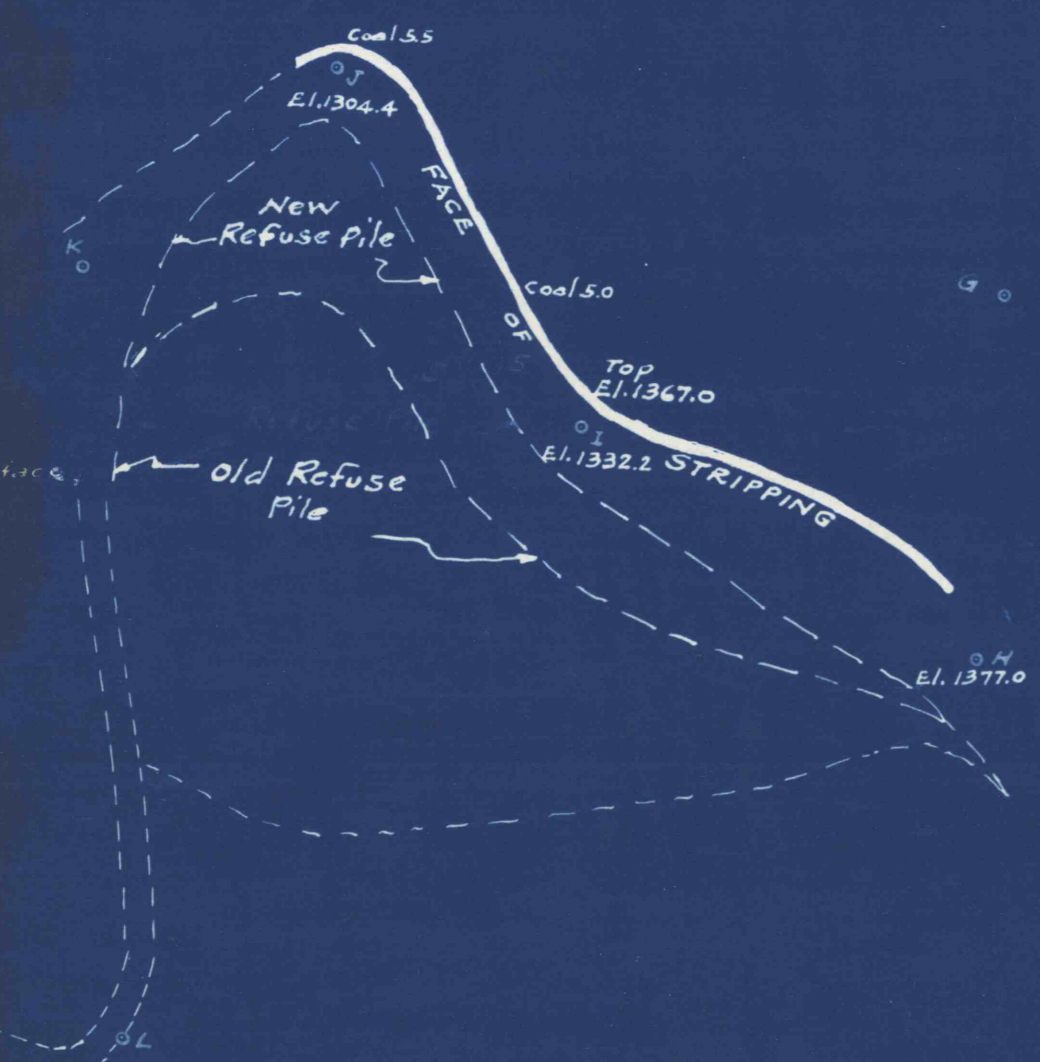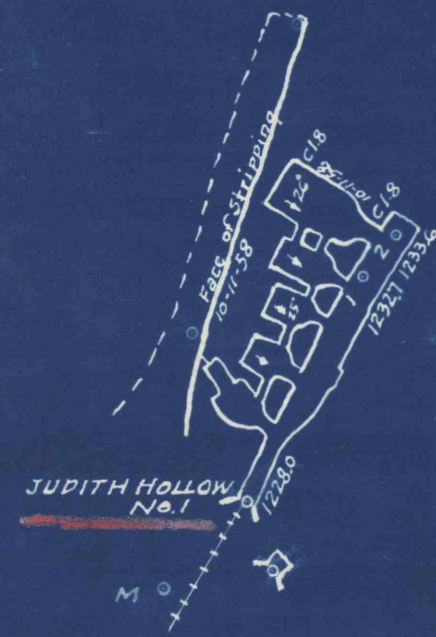

STRIPPING OPERATION BY  
NEW ENTERPRISE STONE & LIME CO.

Broad Top Township — Bedford County

Scale 1" = 100'

Nov. 1957  
Revised Oct. 11-1958

Guy C. Askey, P.E.  
Bedford, Pa.

