


SCOTT & ANDERSON TRACT


Post & Stakes

Top of Cut

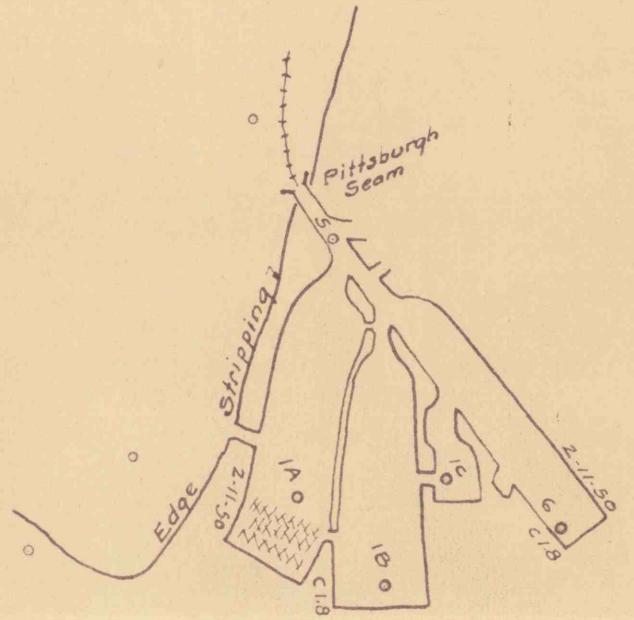

RUSSELL & SCHELL TRACT

PARKER TRACT

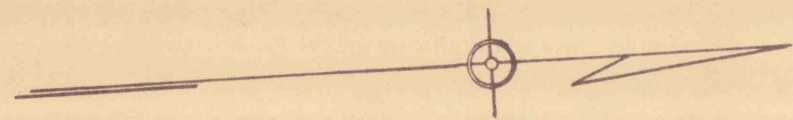

MINE NEAR PARKER TRACT
 BROAD TOP TOWNSHIP — BEDFORD COUNTY

Scale 1"=100'

—1950—

Guy C. Askey, Min. Engr.
Bedford, Pa.

N.G. AT 18