



SCOTT & ANDERSON TRACT

Ref. & Station

Top of Cyl

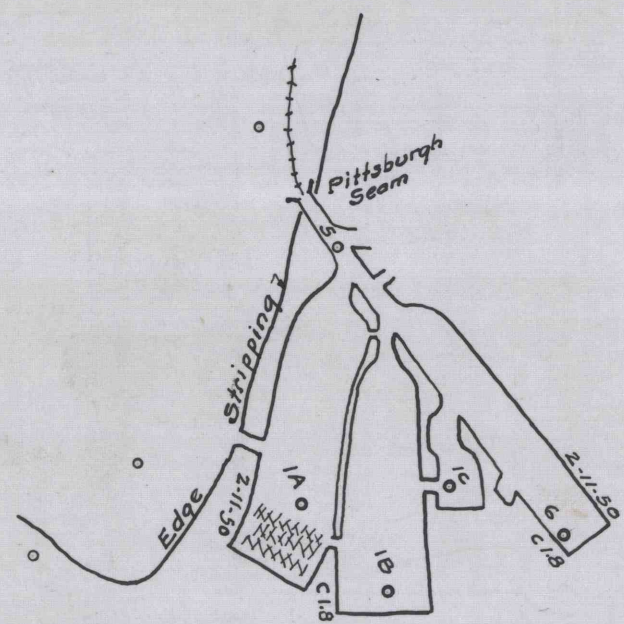

RUSSELL & SCHELL TRACT

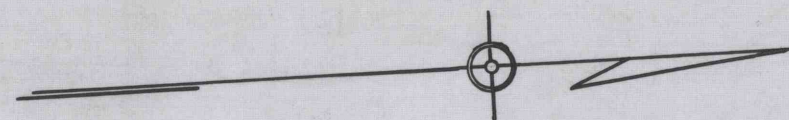

PARKER TRACT

MINE NEAR PARKER TRACT
 BROAD TOP TOWNSHIP — BEDFORD COUNTY

Scale 1"=100'

—1950—

Guy C. ASKEY, Min. Engr.
Bedford, Pa.