



Barnett seam

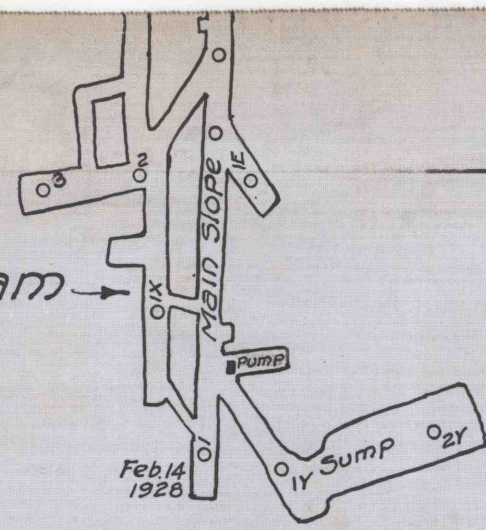

M-A-P
SHOWING PORTION OF
KEARNEY MINES
OWNED BY
EVERETT-SAXTON CO.
KEARNEY PENNA.
Scale - 1" = 100'
Guy C. Askey M.E.
Bedford, Pa.

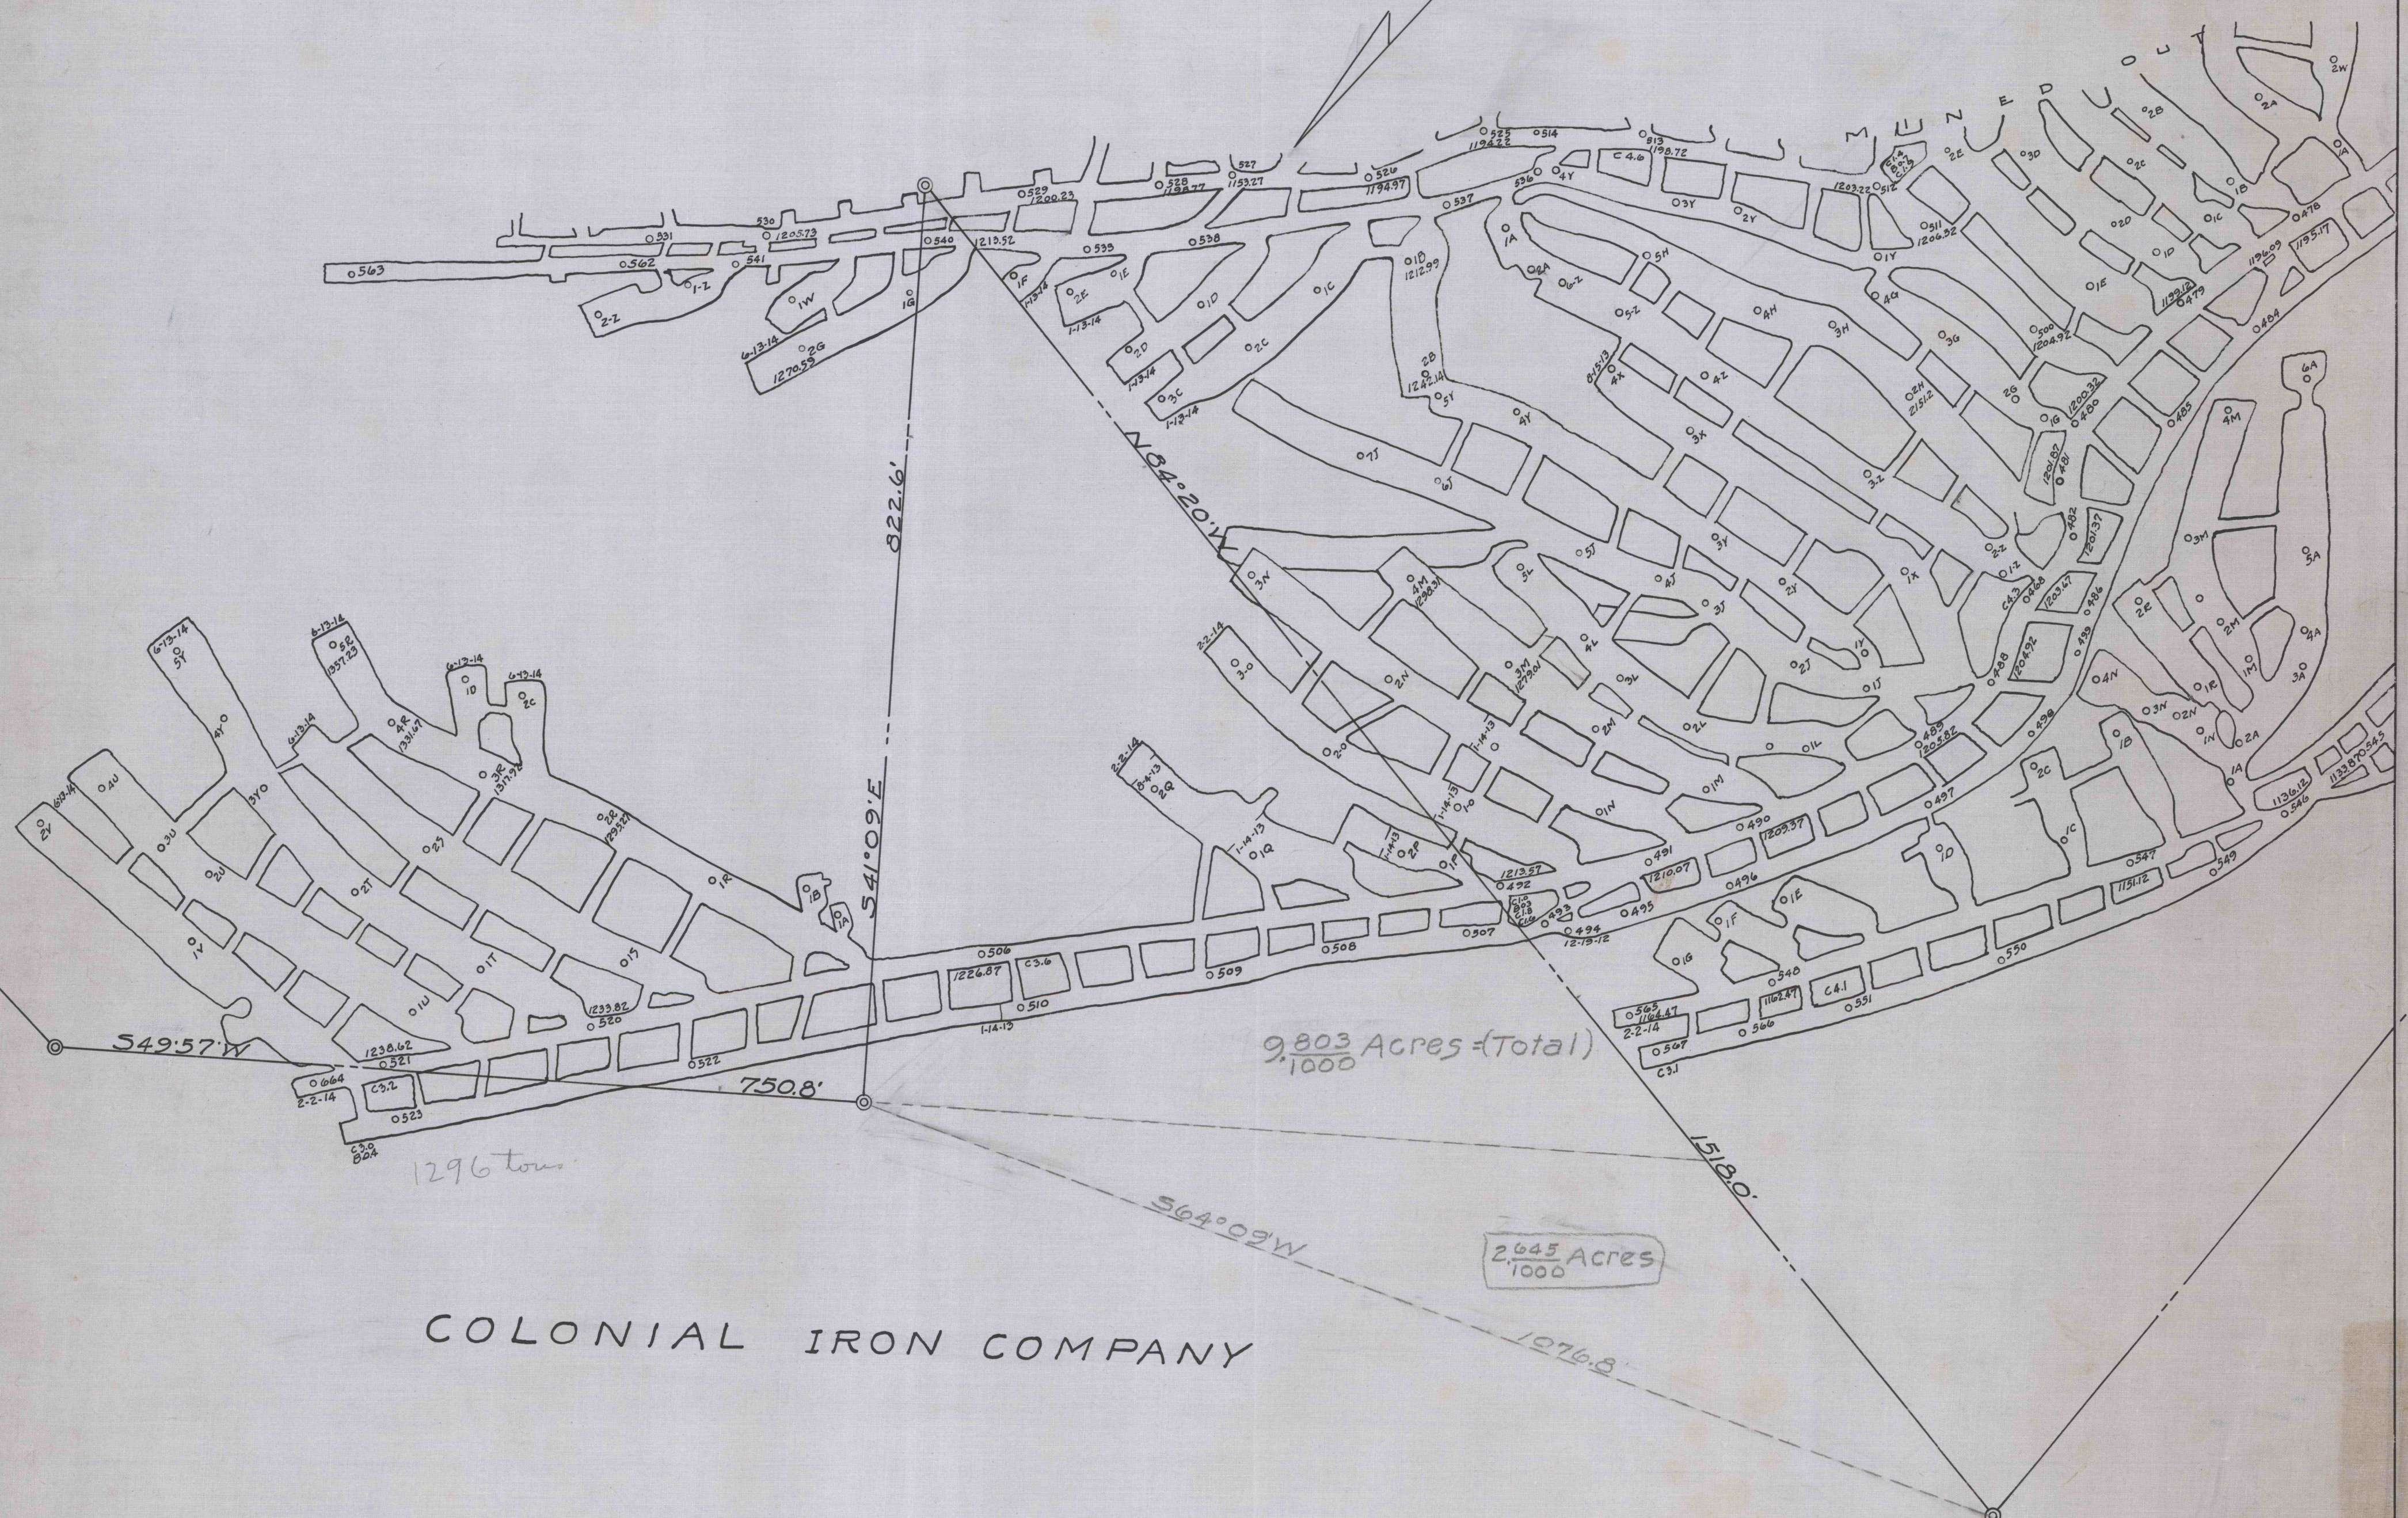

COLONIAL IRON COMPANY