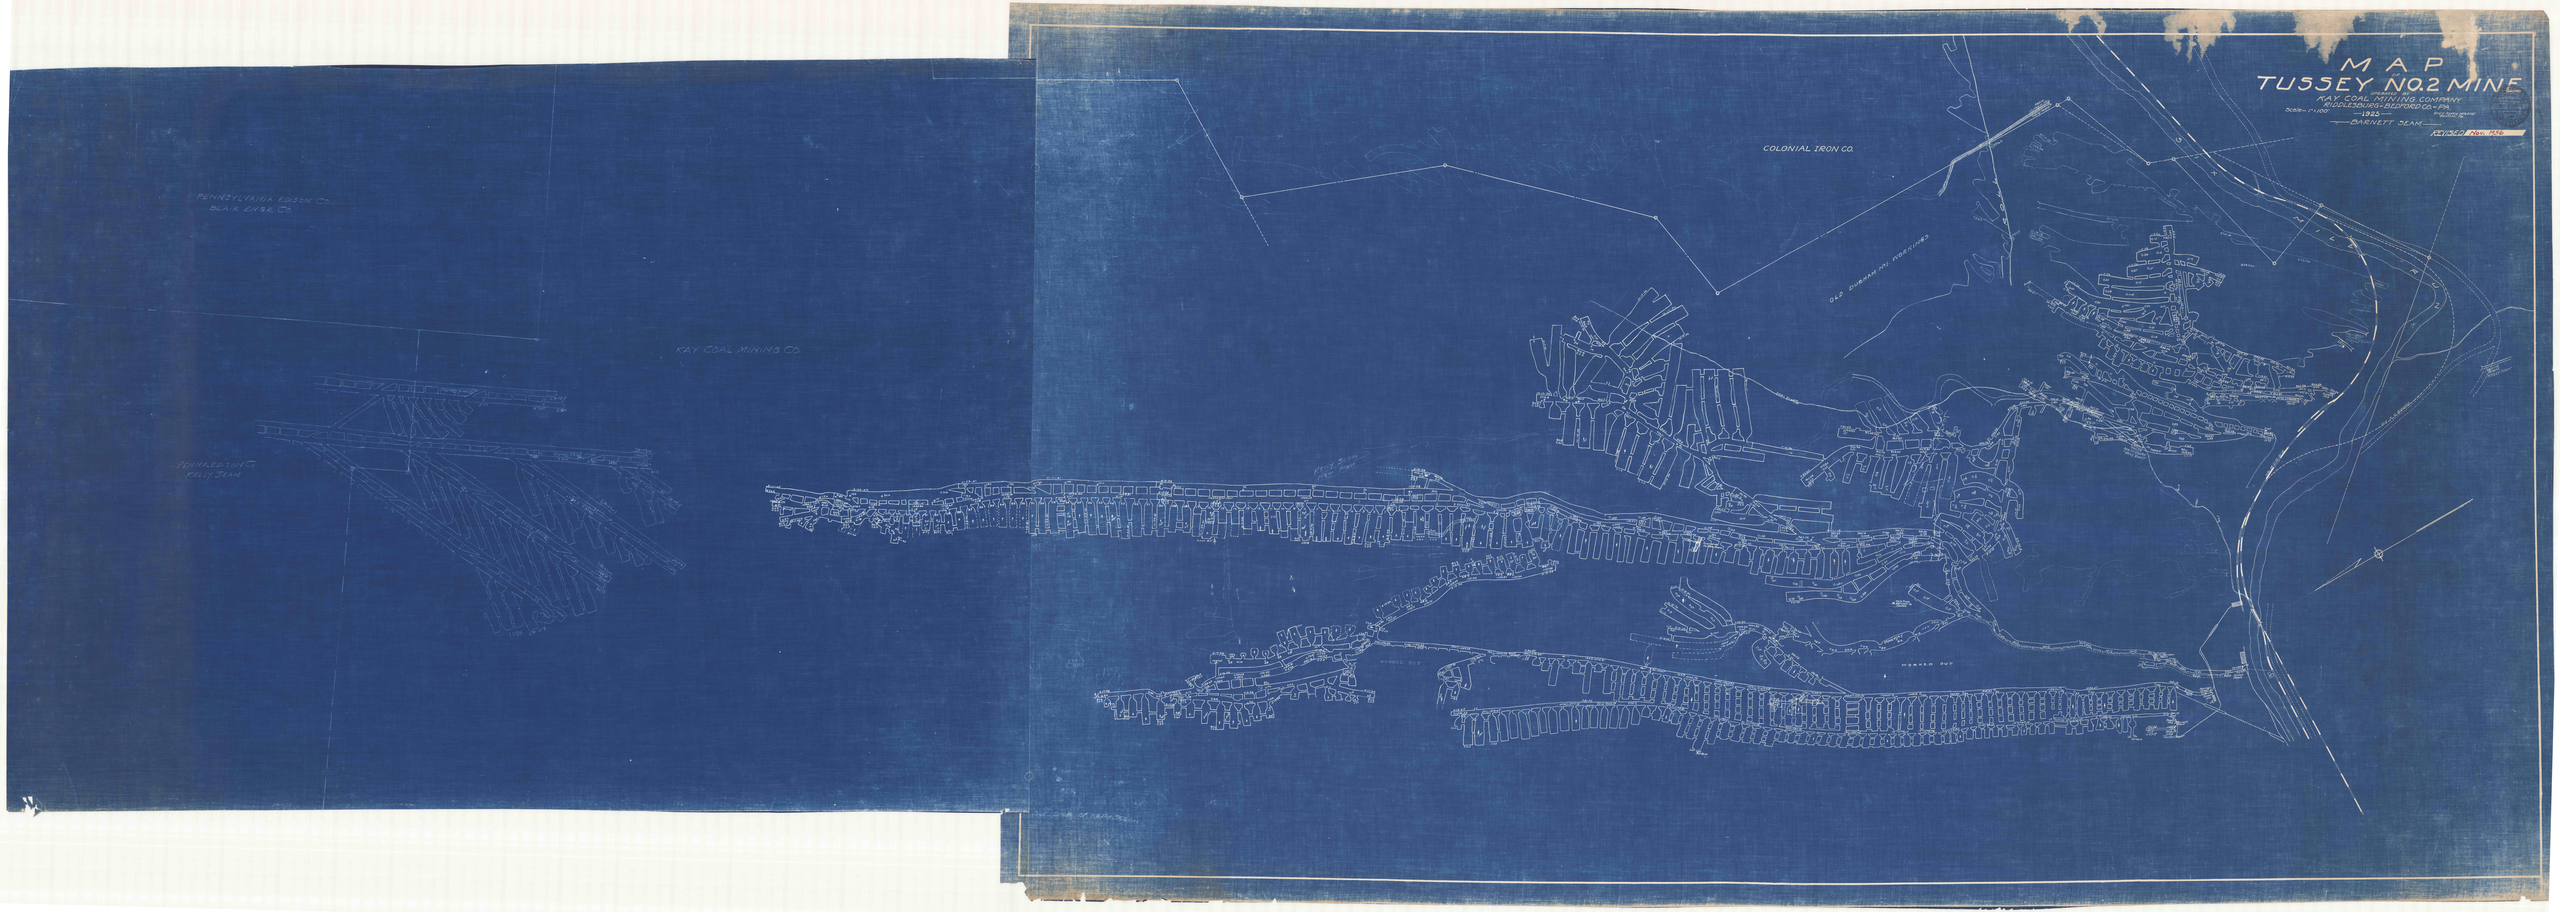

MAP
TUSSEY NO. 2 MINE
KAY COAL MINING COMPANY
SCALE- 1"=100'
1923
BARNETT SEAM
REVISED Nov. 1926
PENNSYLVANIA EDISON CO.
BLAIR ENGR. CO.
KAY COAL MINING CO.
PENNSYLVANIA
KELLY SEAM
COLONIAL IRON CO.
OLD SUBWAY OPENINGS
WORKED OUT
WORKED OUT