MAP OF MT EQUITY MINE

BELONGING TO THE


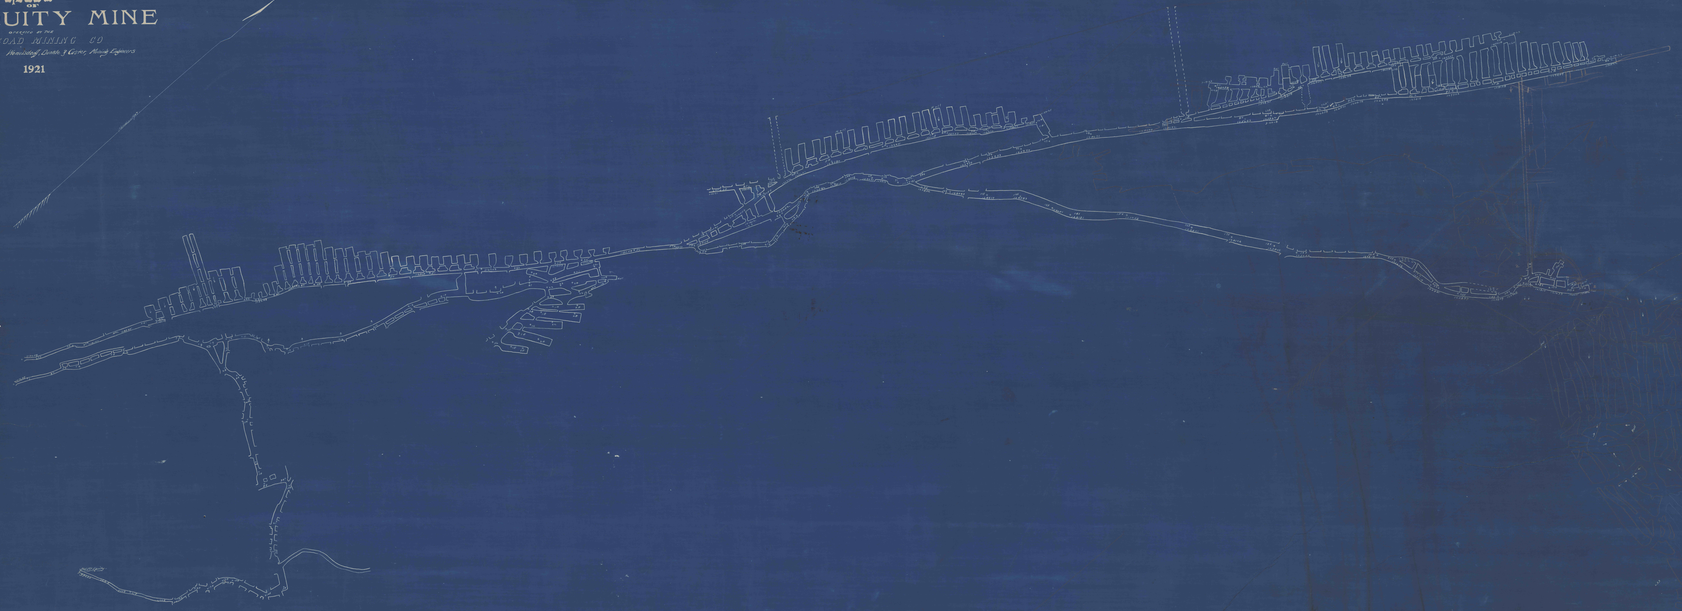
1921