


SEABOARD COAL CO.

N 40° 26' E

2370.6

587° 44' E

629.4

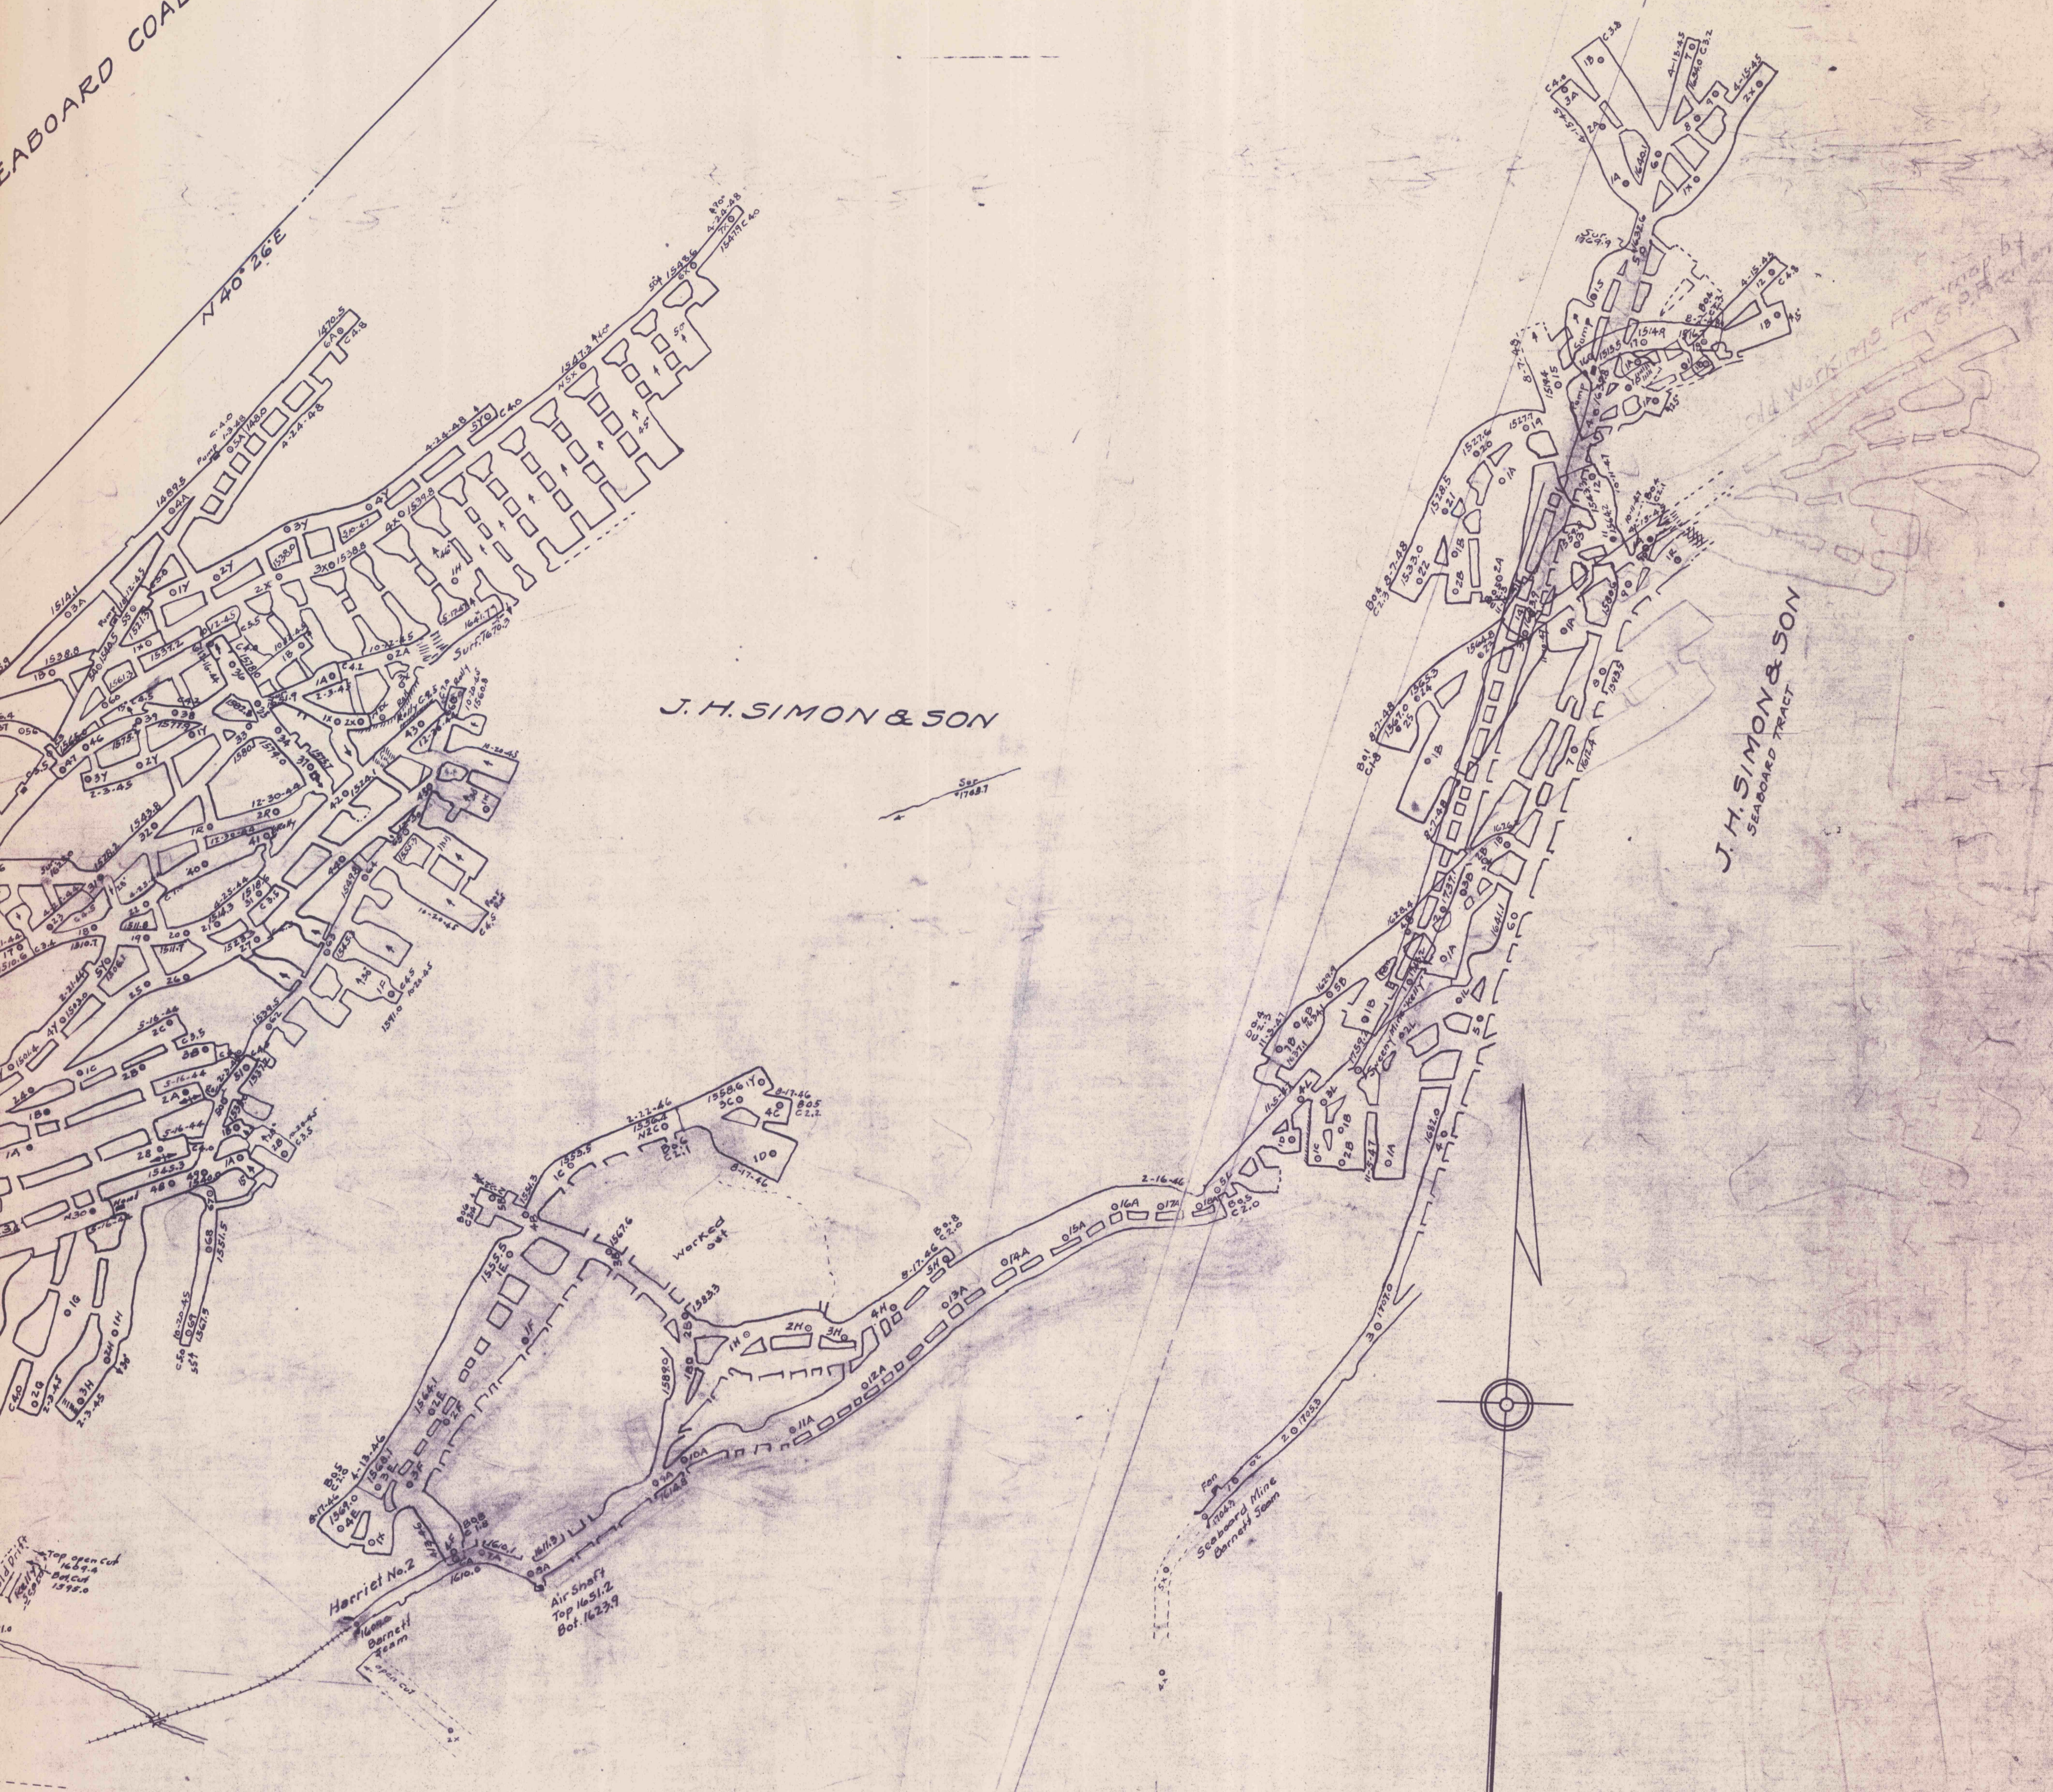

J. H. SIMON & SON

J. H. SIMON & SON
SEABOARD TRACT

HARRIET MINES

OWNED AND OPERATED BY

J. H. SIMONS & SON

ON SANDY RUN - BEDFORD COUNTY - PA.


Scale: 1" = 100'

1942

Guy C. Askey, Min. Engr.
Bedford, Pa.

Revised

Note -
Property Lines without Bearings & Distance were taken from
Mide map by A.W. Bodine.

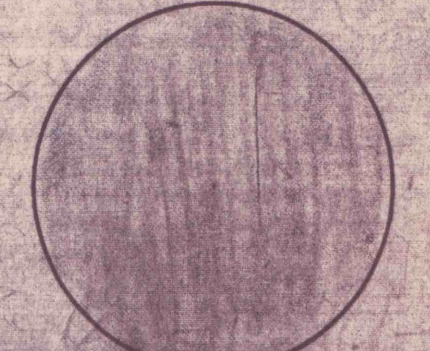

N. 41, A7-19

66.62.02