


POWER CO

EVERETT-SAXTON CO

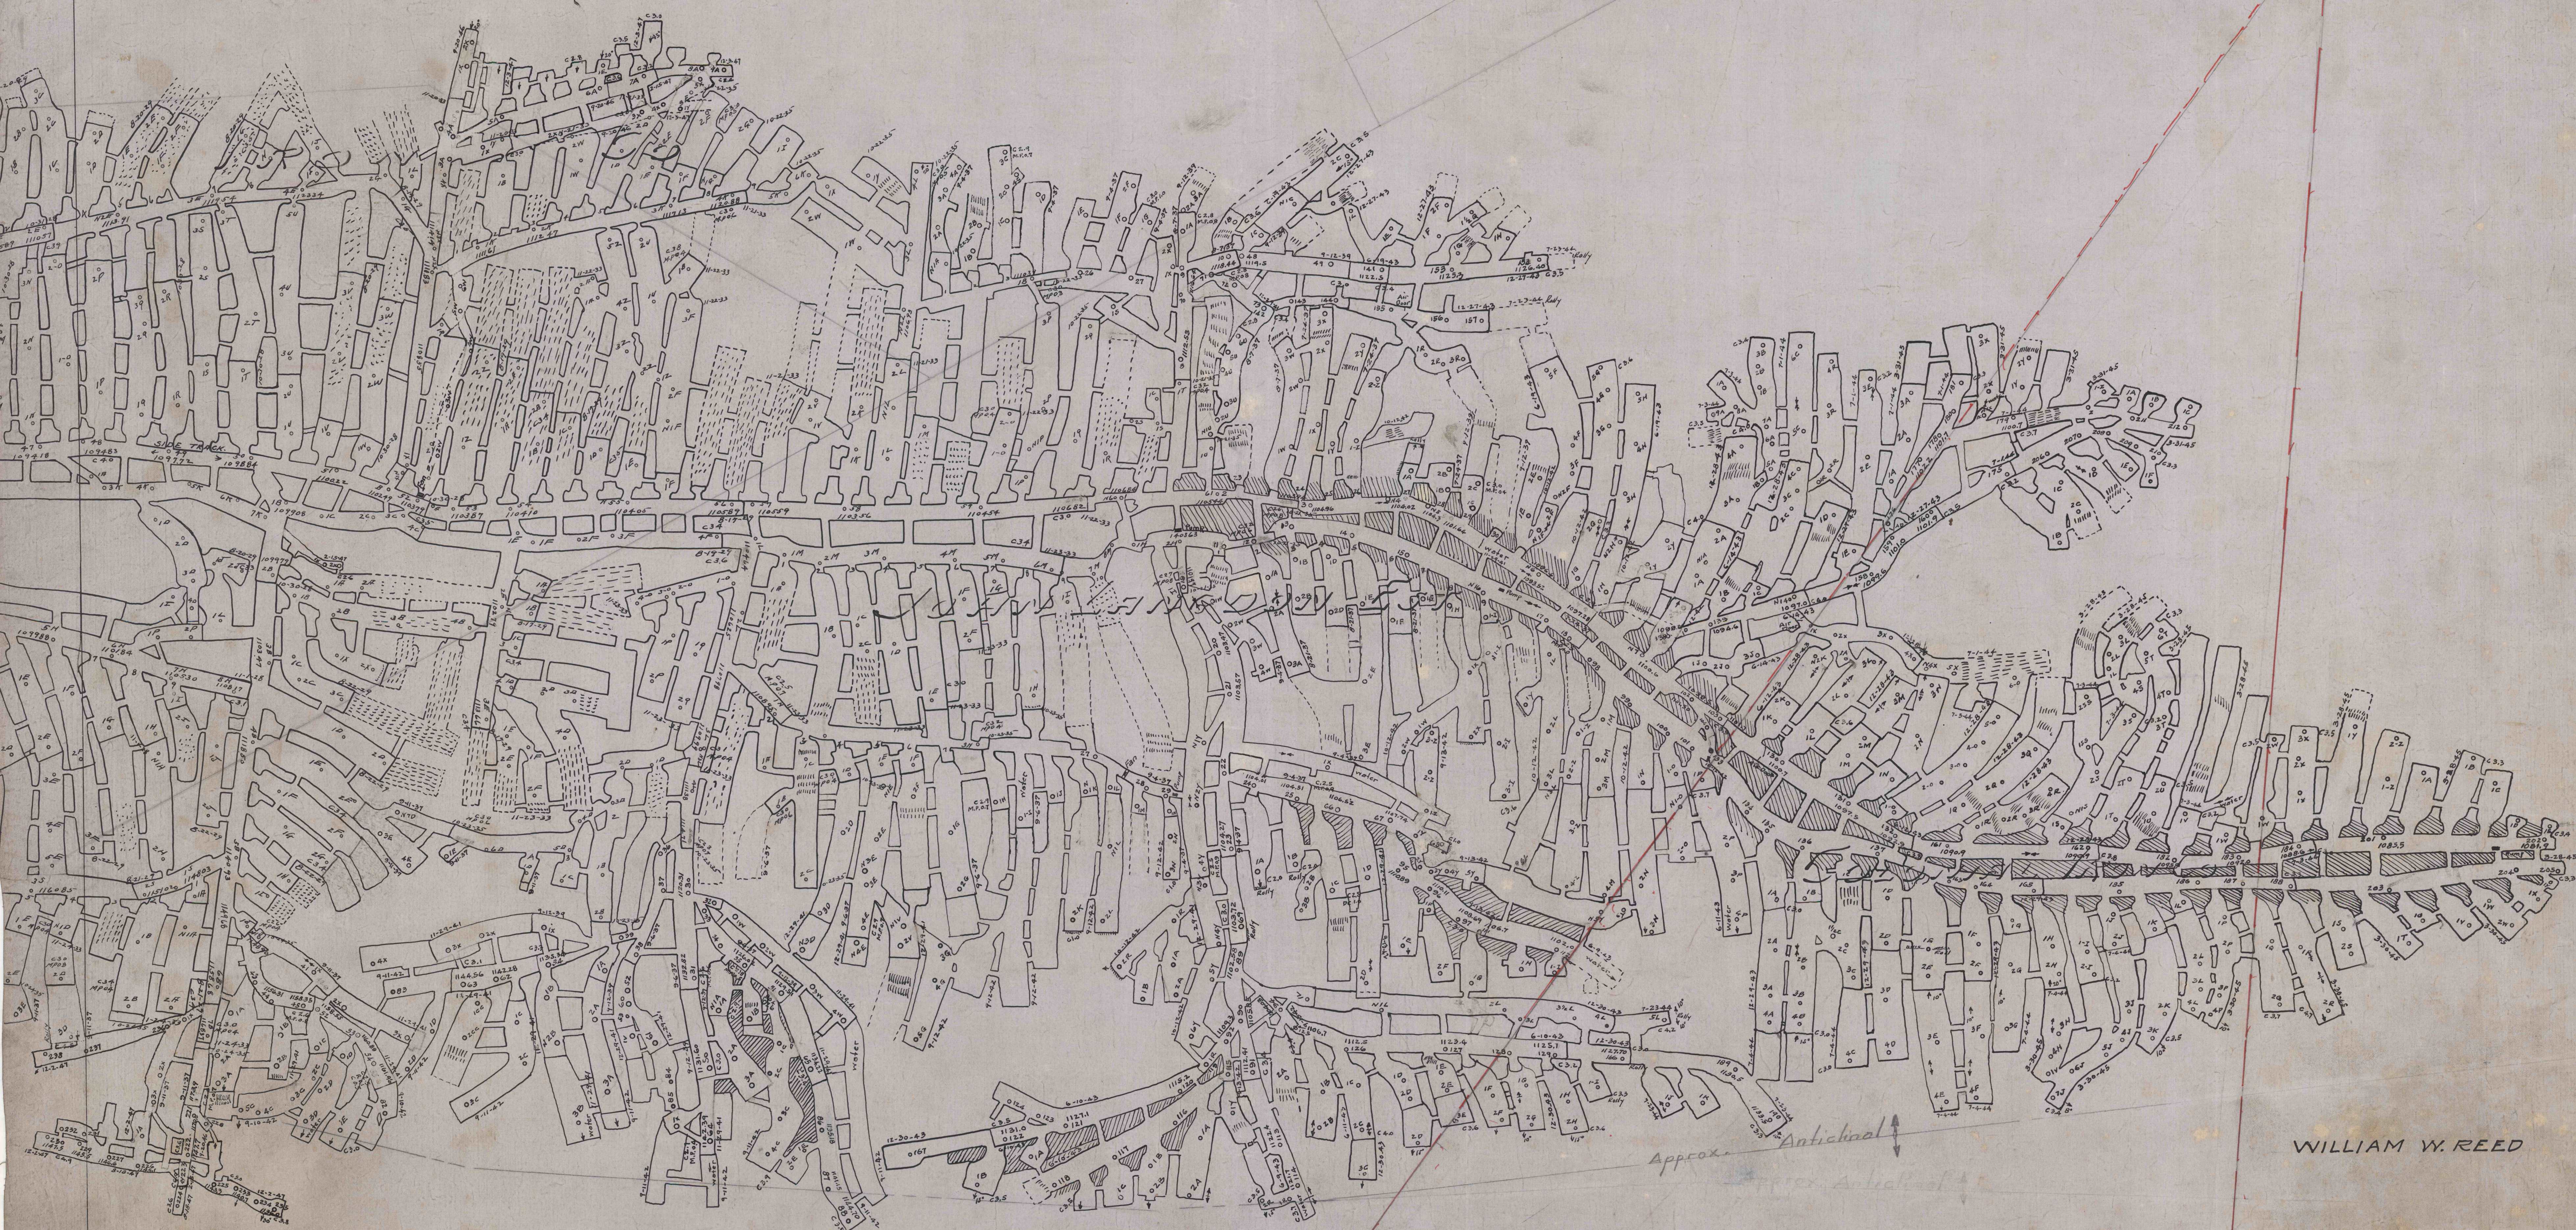

WILLIAM W. REED

PART OF
PATTON TRACT

