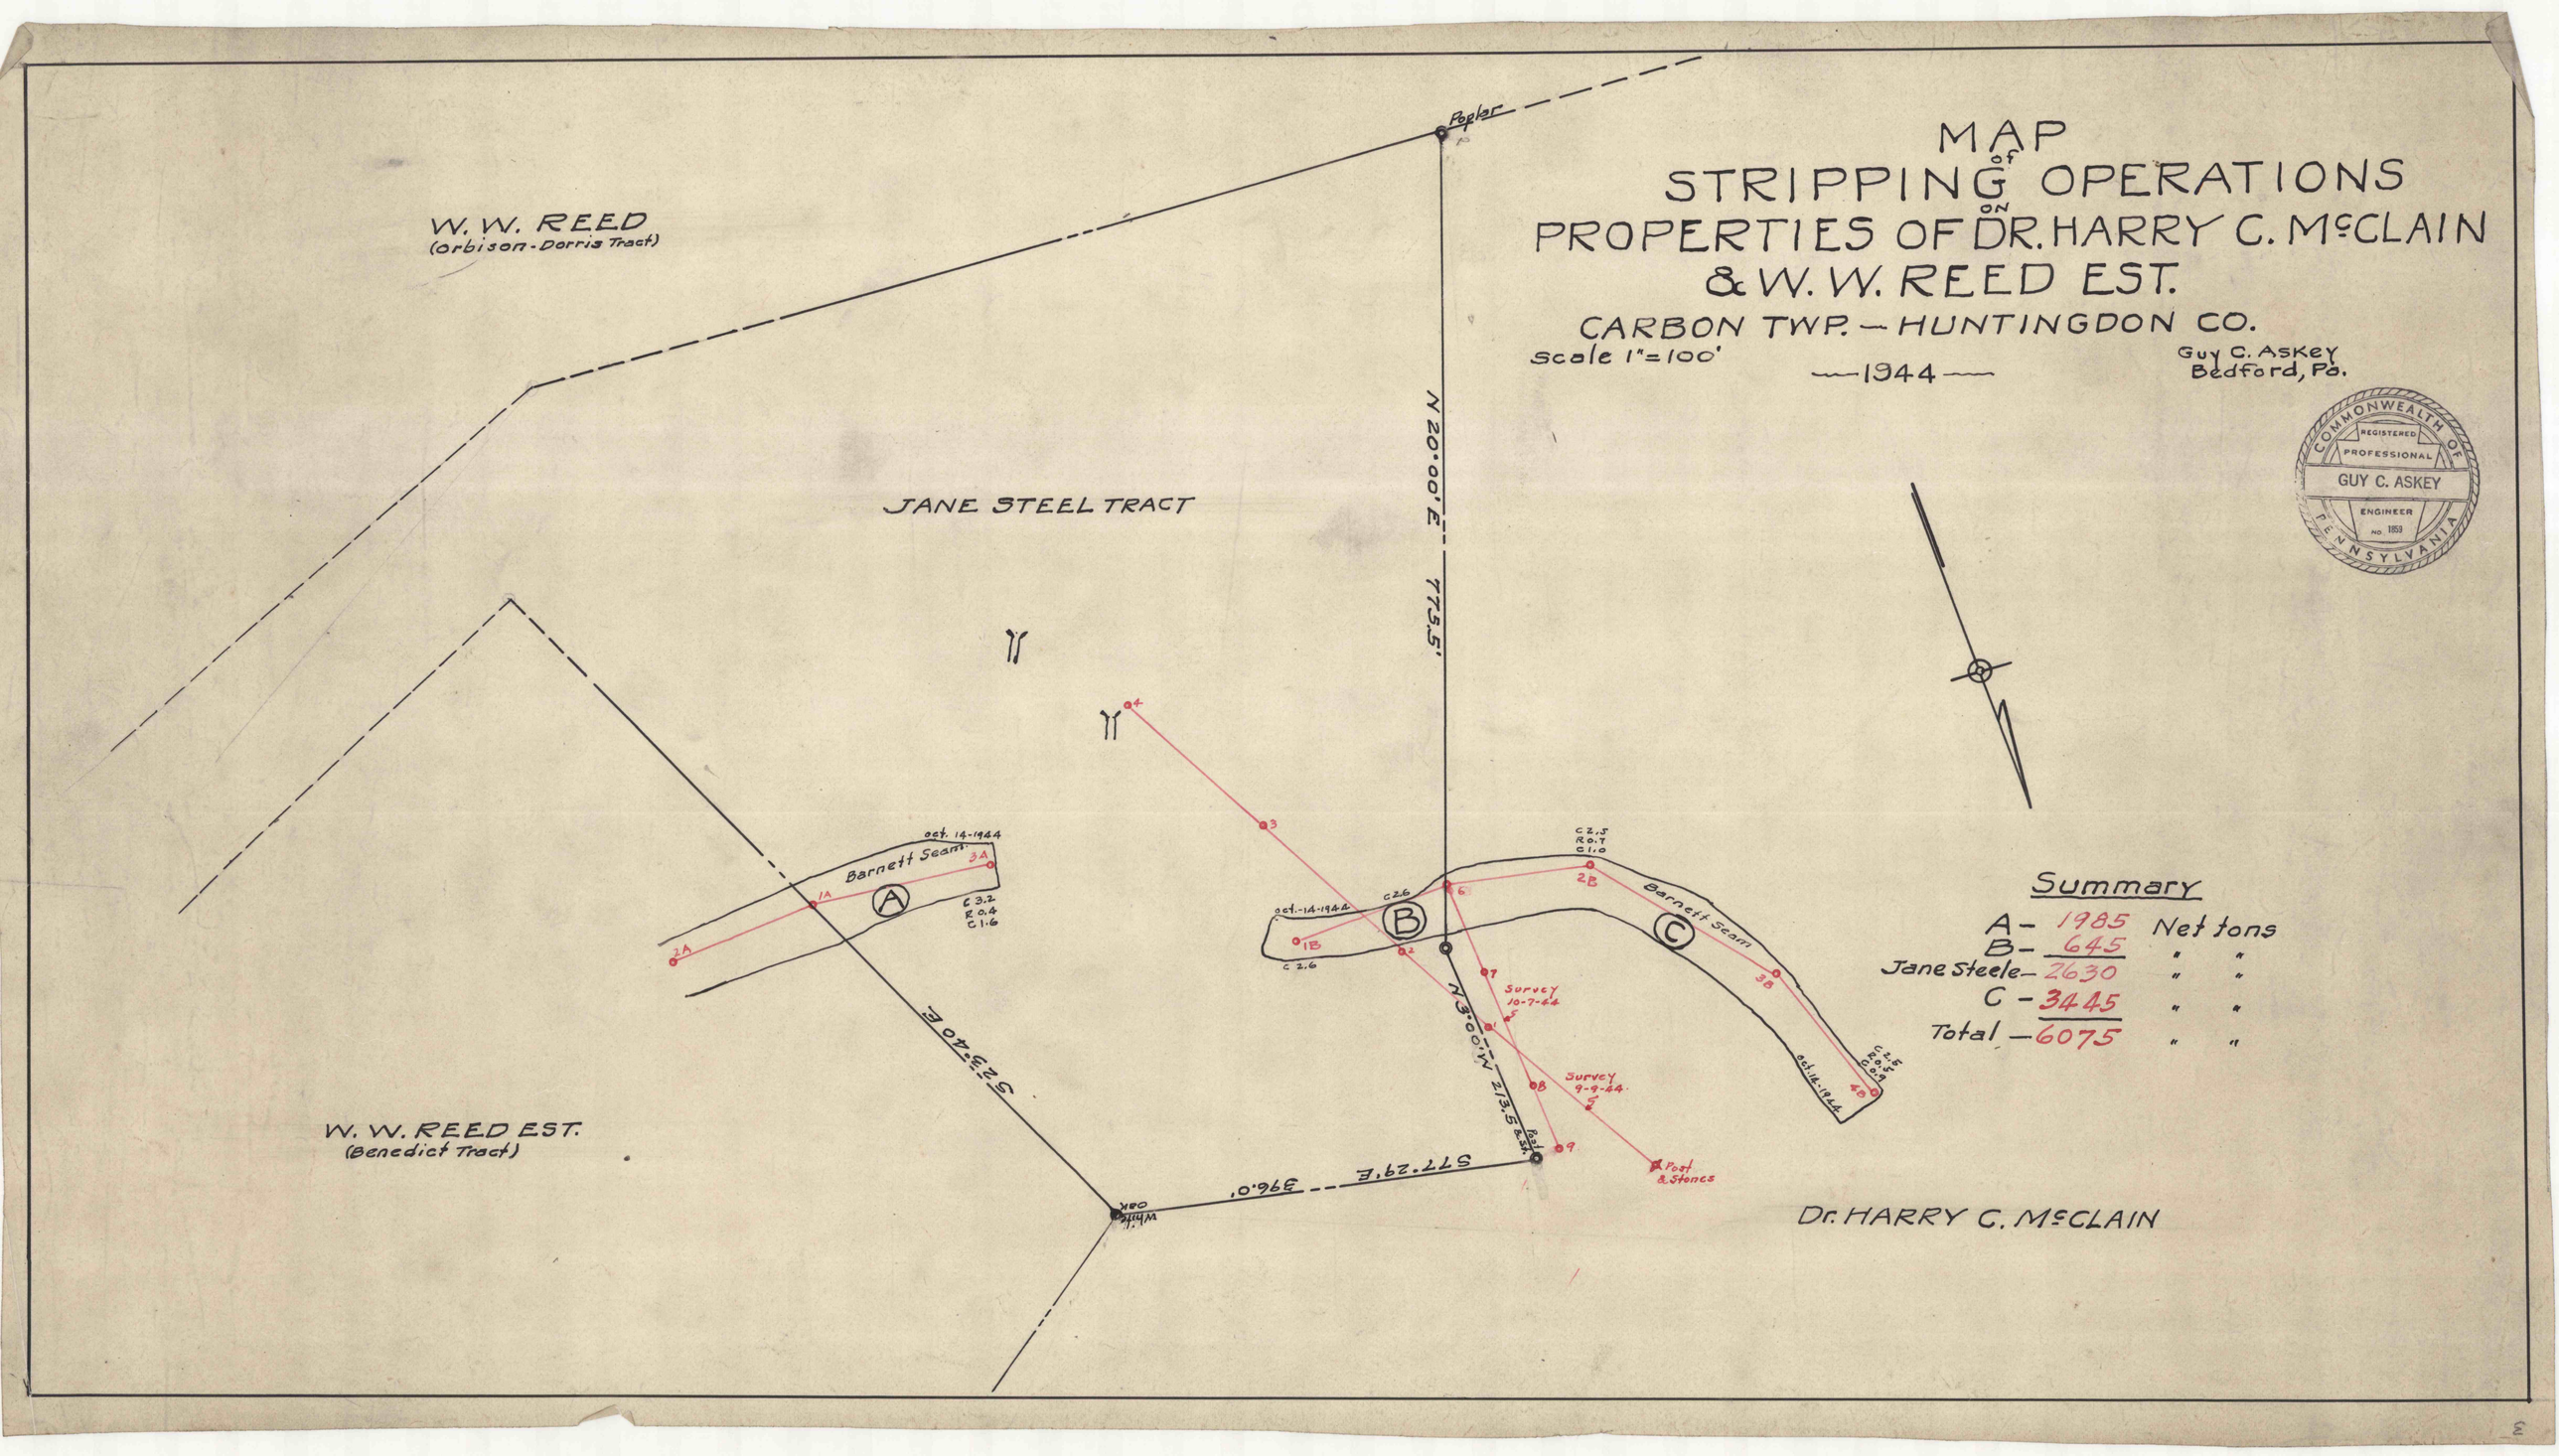
MAP
of
STRIPPING OPERATIONS
on
PROPERTIES OF DR. HARRY C. McCLAIN
& W. W. REED EST.
CARBON TWP. — HUNTINGDON CO.
Scale 1"=100'
—1944—
Guy C. Askey
Bedford, Pa.
COMMONWEALTH OF PENNSYLVANIA
REGISTERED PROFESSIONAL
GUY C. ASKEY
ENGINEER
NO. 1859
W. W. REED
(Orbison-Dorris Tract)
JANE STEEL TRACT
W. W. REED EST.
(Benedict Tract)
Dr. HARRY C. McCLAIN
Poplar
N 20°00' E 775.5'
S 23°40' E
S 77°29' E 396.0'
N 3°00' W 213.5'
Barnett Seam
Barnett Seam
A
B
C
oct. 14-1944
oct.-14-1944
oct. 14-1944
C 3.2
R 0.4
C 1.6
C 2.6
C 2.6
C 2.5
R 0.7
C 1.0
C 2.5
R 0.5
C 0.9
Survey 10-7-44
Survey 9-9-44
Post & Stones
White Oak
Summary
A - 1985 Net tons
B - 645 " "
Jane Steele - 2630 " "
C - 3445 " "
Total - 6075 " "