



MAP MIDLOTHIAN No 2 W.W. REED COAL CO.

DUDLEY - HUNTINGDON COUNTY, PA.

Scale 1" = 100'

Guy C. Askey, Min. Engr.
Bedford, Pa.

1943

 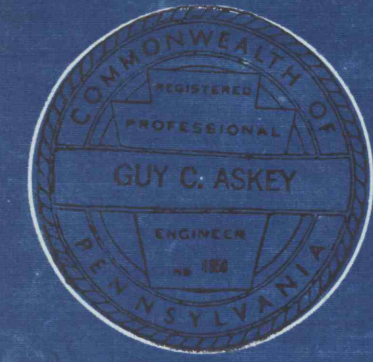

Elev. Water Gordon Slope
1225.8 (5-8-41)
Approx. 1227.0 (10-25-60)

ONION MINE
OPERATED BY
PAUL THOMAS

REVISED JULY 1962

