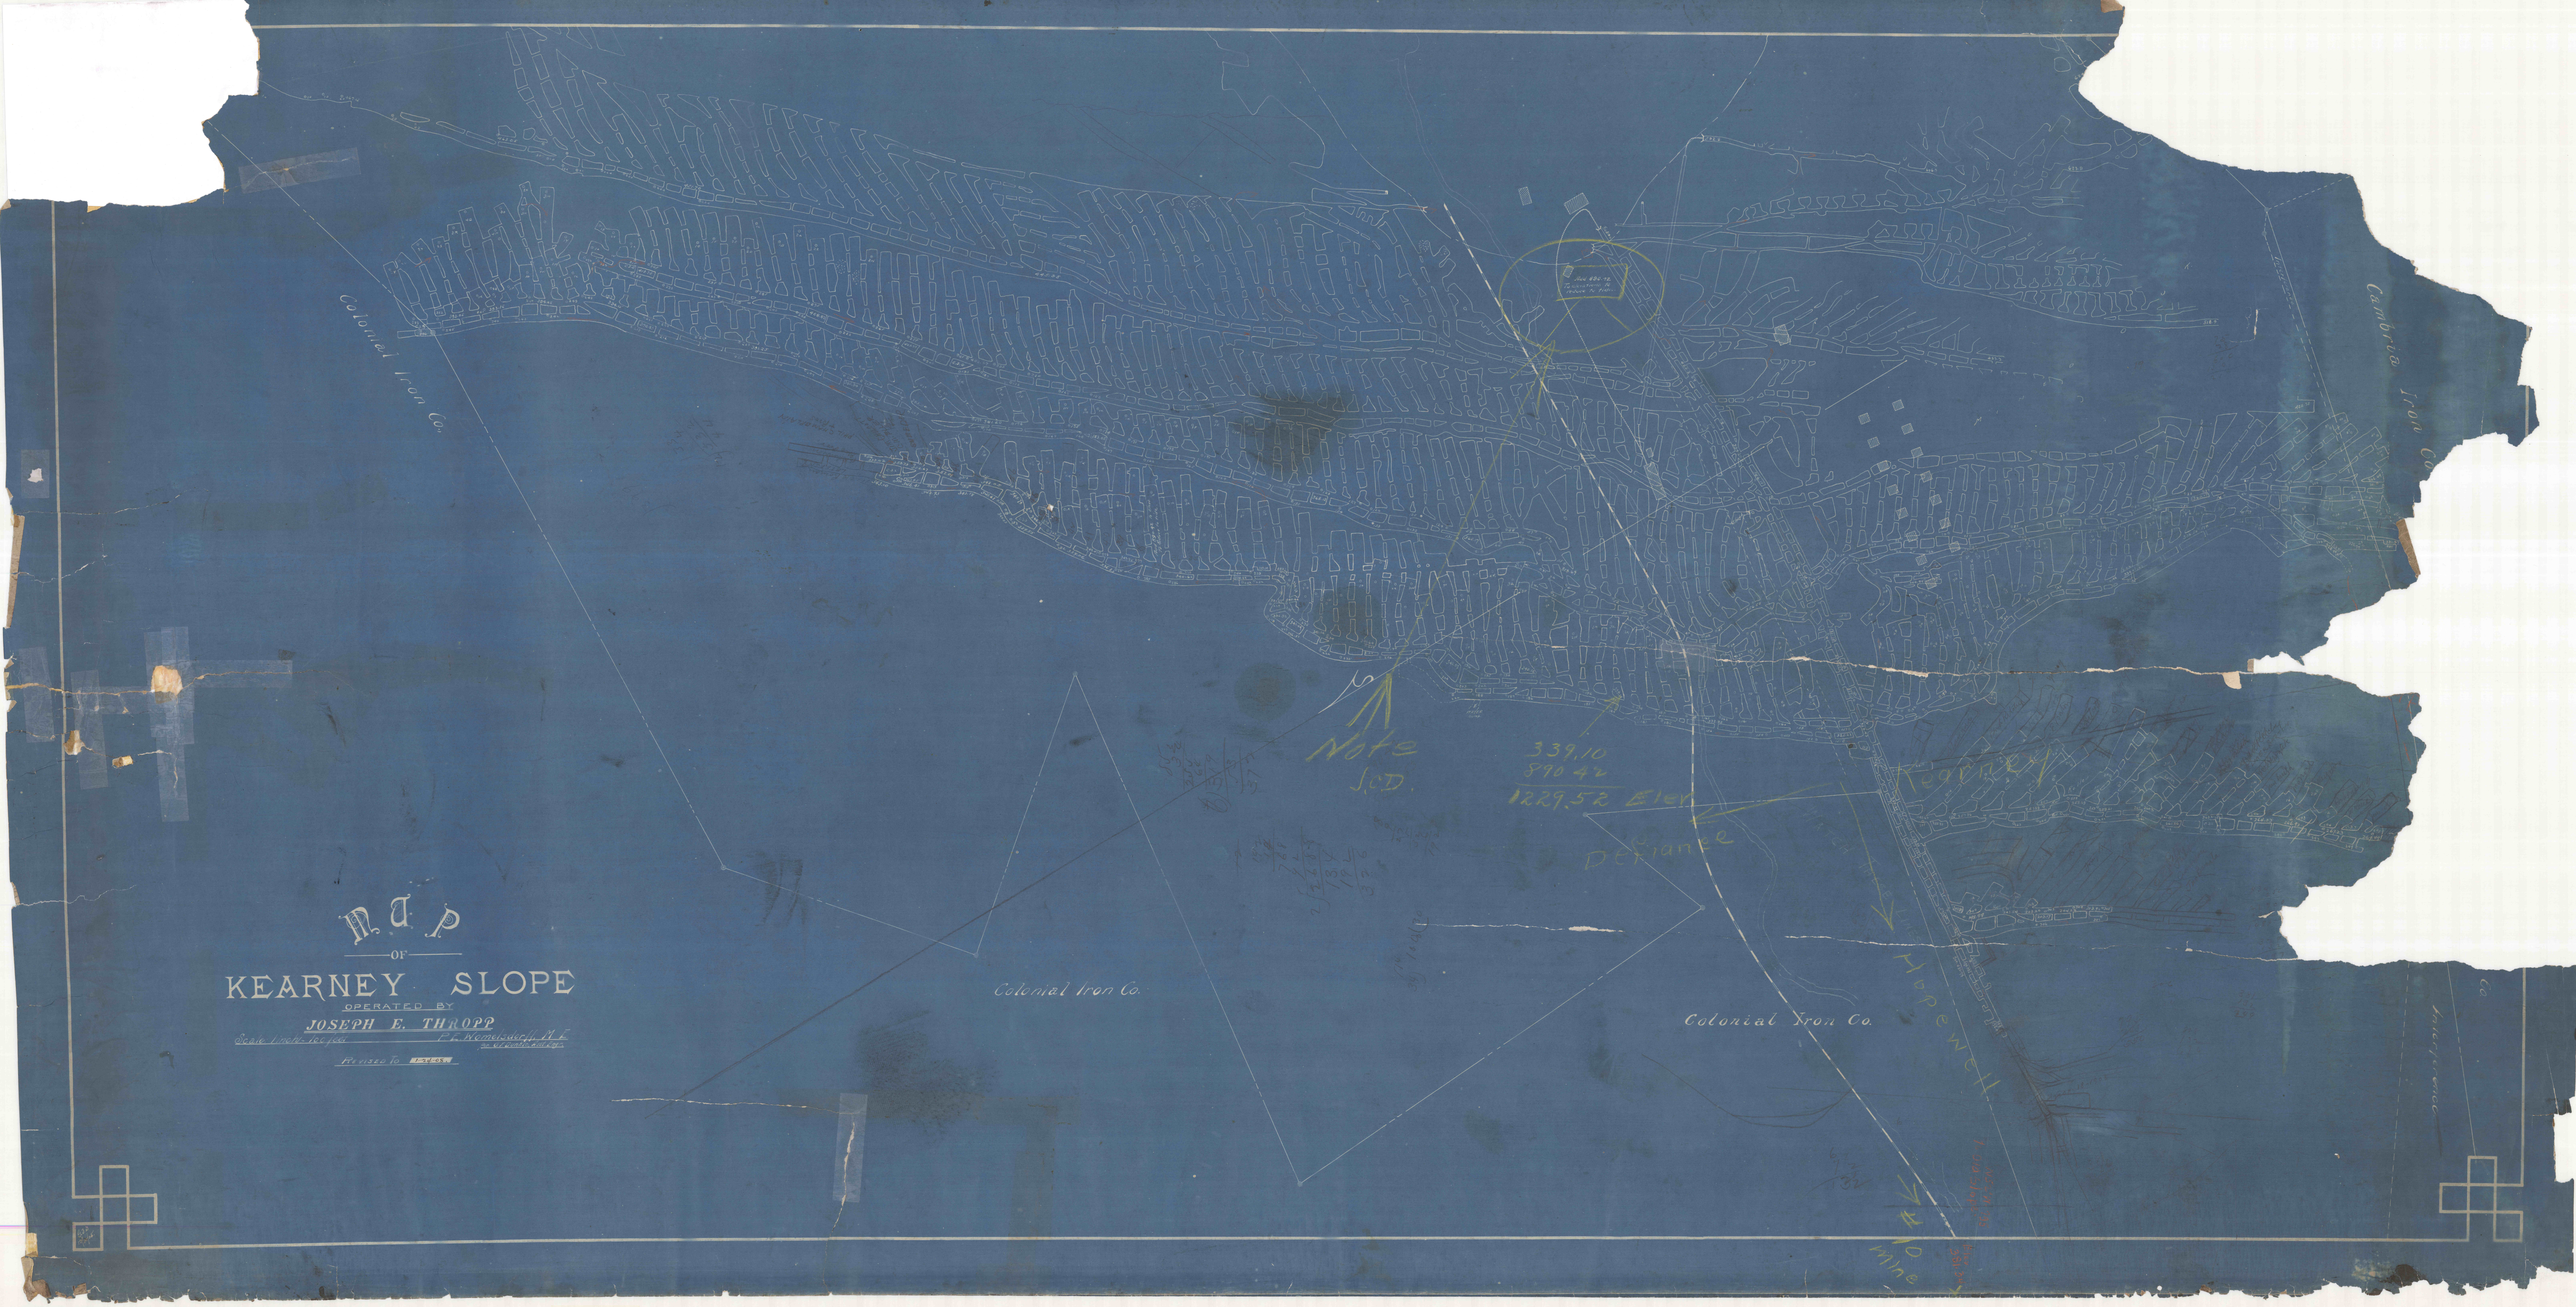
Map
OF
KEARNEY SLOPE
OPERATED BY
JOSEPH E. THROPP
Colonial Iron Co.
Colonial Iron Co.
Colonial Iron Co.
Cambria Iron Co.
Kearney
Hopewell
Mine
Note
S.E.D.
339.10
890.42
1229.52 Elev
Defiance