MAP of MILLER MINES

NEAR

COALMONT, HUNTINGDON CO., PENNA.

P.E. WOMELSDORFF, MINING ENGINEER, G.F.D. UNKLE, ASSISTANT

Scale: 1in=100 Feet

December 1904
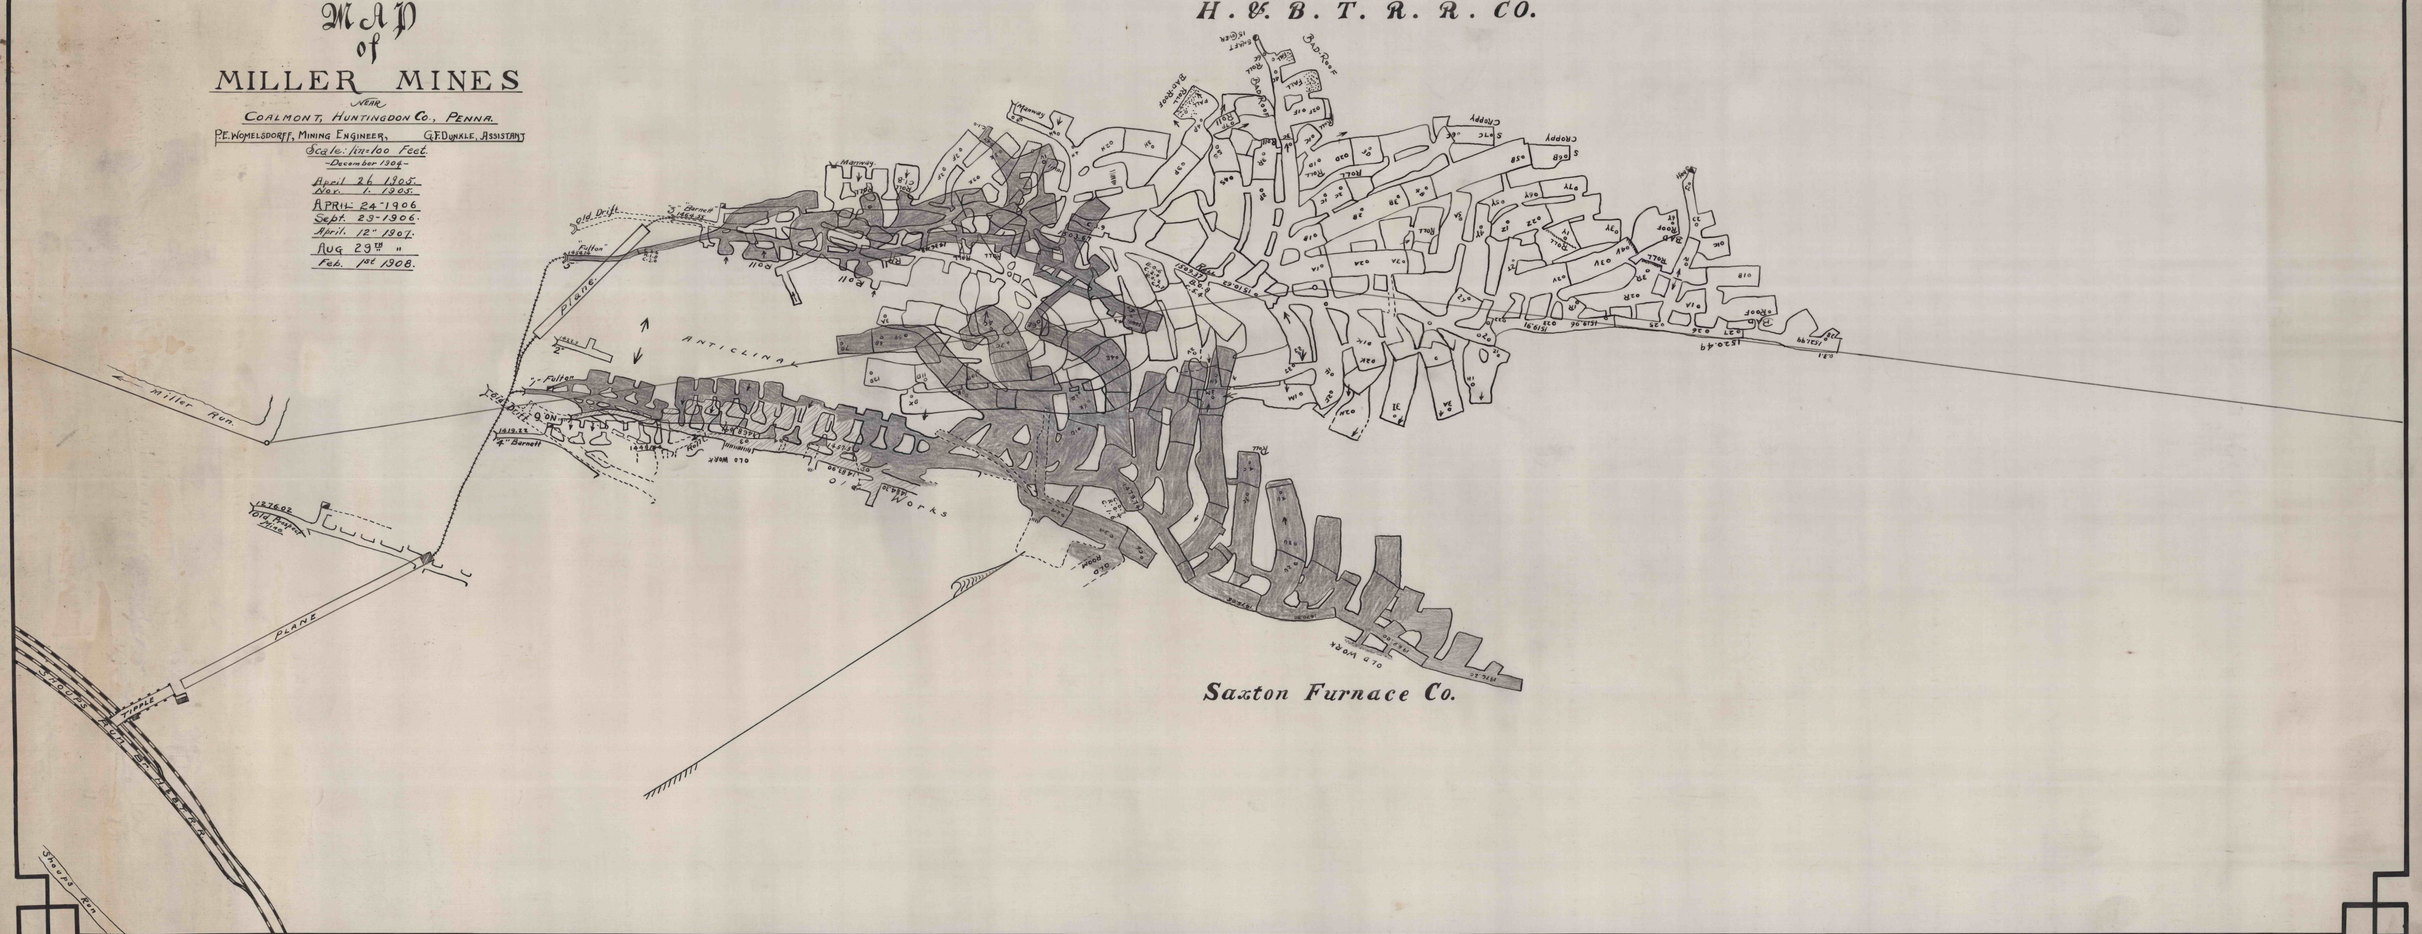
April 24 1905.
Nov. 1. 1905.
APRIL 24-1906
Sept. 29-1906.
April. 12" 1907.
Aug 29th "
Feb. 1st 1908.