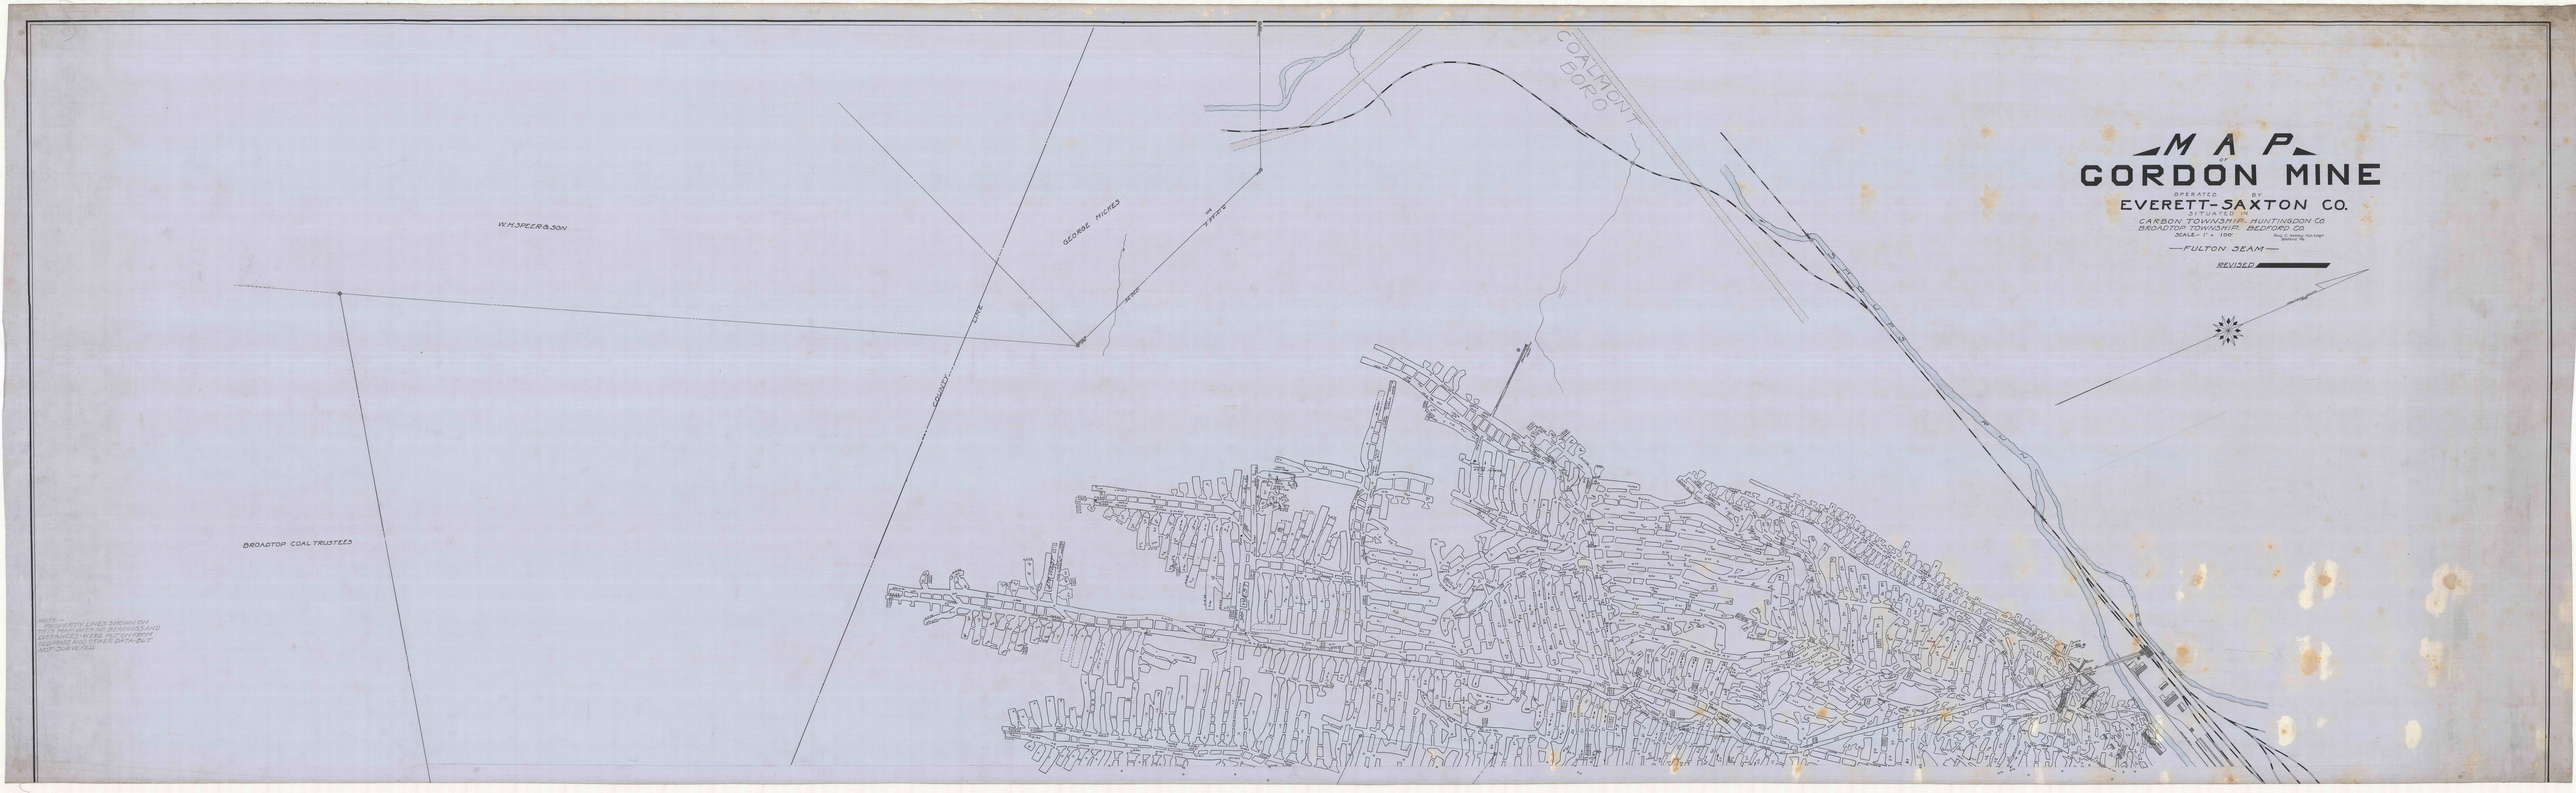
MAP
OF
GORDON MINE
OPERATED BY
EVERETT-SAXTON CO.
SITUATED IN
CARBON TOWNSHIP, HUNTINGDON CO.
BROADTOP TOWNSHIP, BEDFORD CO.
SCALE: 1" = 100'
Eng. C. Hartley 1904-1905
Surveyor Hg
FULTON SEAM
REVISED
W. H. SPEER & SON
GEORGE HIGHES
COUNTY LINE
COALMONT BORO
BROADTOP COAL TRUSTEES
NOTE:- PROPERTY LINES SHOWN ON THIS MAP WITH NO BEARINGS AND DISTANCES WERE PITCHED FROM ALIGNED AND OTHER DATA BUT NOT SURVEYED