


2.37 E
E GOLD D
523 W 5867.7
Stones
AMTICKLASH
LINE

APPROXIMATE LOCATION
WORKINGS
GORDON MINE

51930'E 3183.7'
RAVENHOCK
TUNNEL

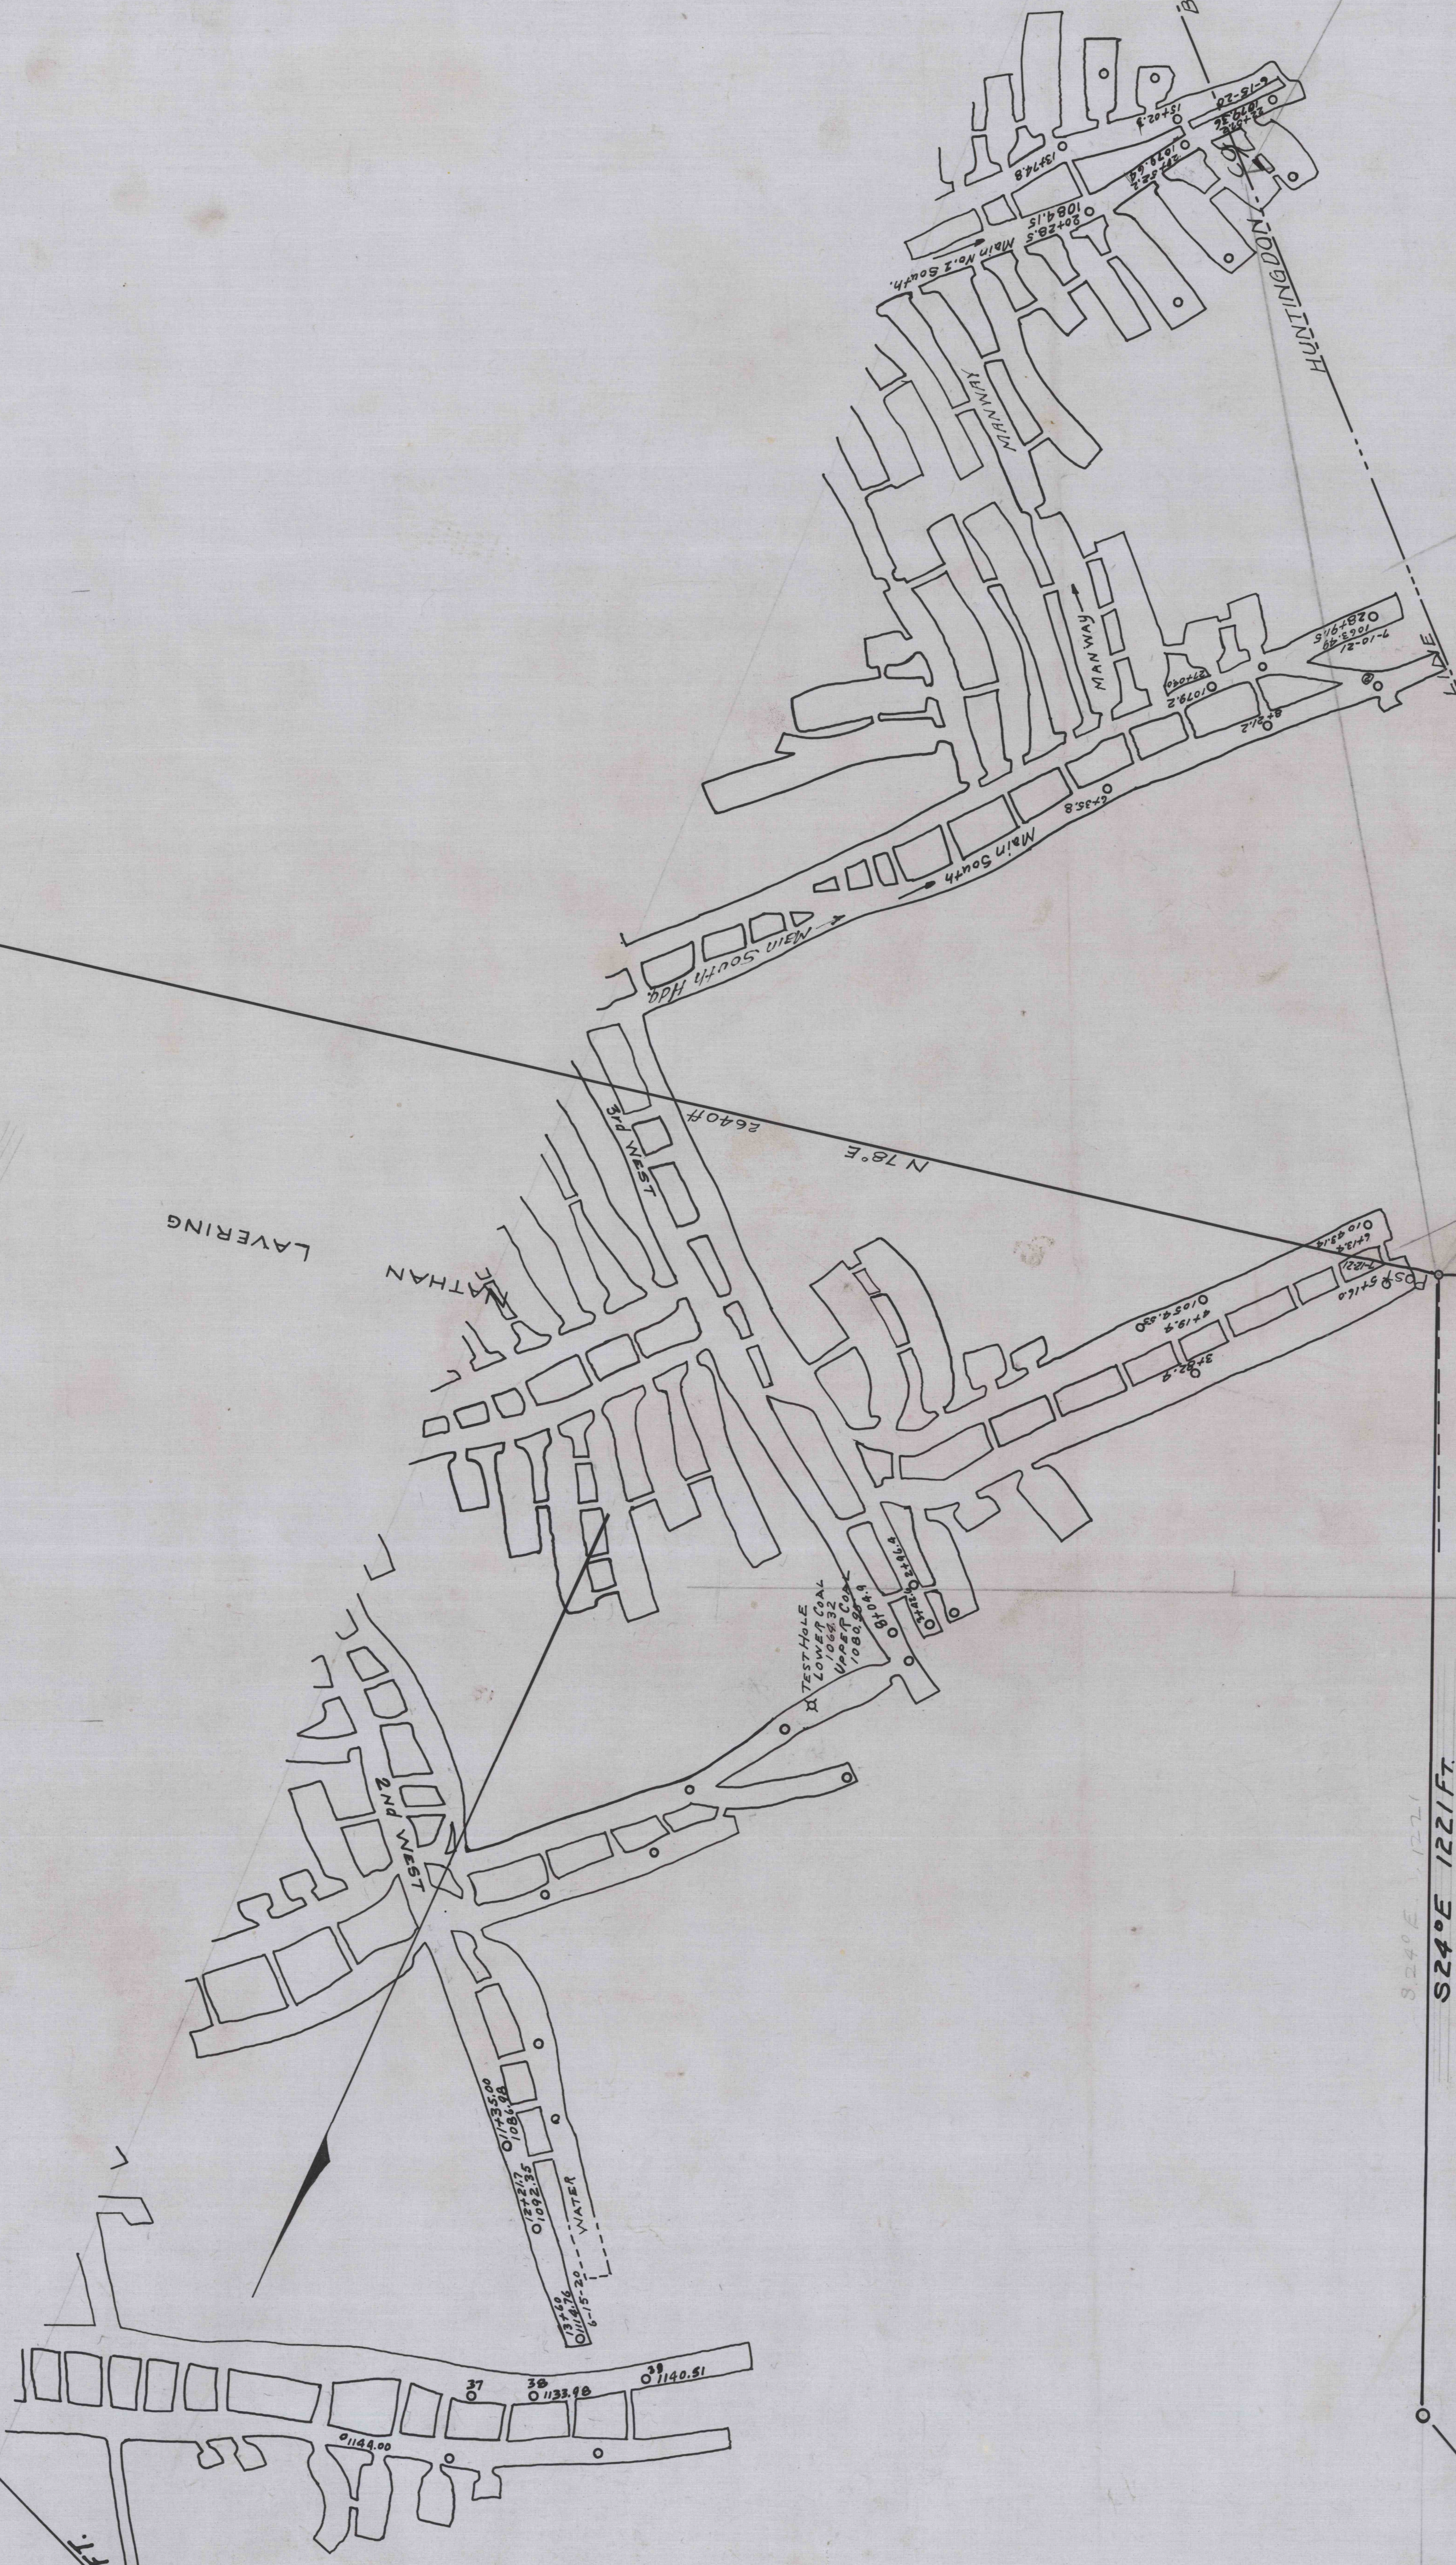

524°E 1221.7'

507°E 683.7'

APPROXIMATE LOCATION OF
COALMINE BRANCH OF THE H.B.T.R. TO
COALMINE

LENOPE MINE

GEORGE HICKES


N 65° 48' E
8020.4' H

ADDITIONAL
LINE

N 121° 12' E
4528.7'

DRIFT MOUTH
HAMILTON

N 74° W 9263.9'

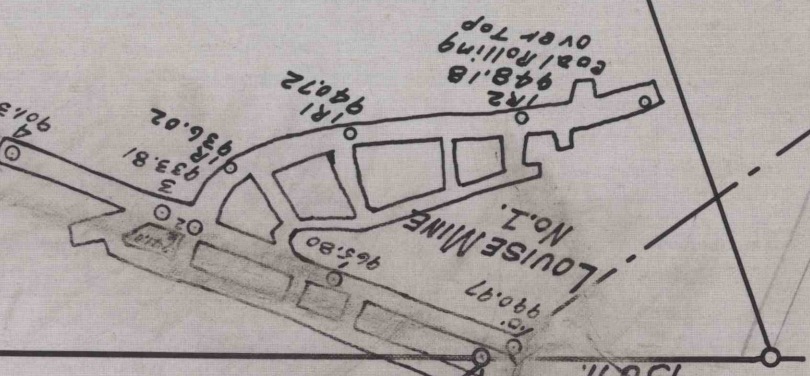

JOHN