



# BROAD TOP NO. 1

OWNED AND OPERATED BY  
**WARREN H. REED**  
CARBON TOWNSHIP - HUNTINGDON COUNTY

Scale: 1" = 100'

— 1959 —  
Revised: Nov. 1961  
" Oct. 1962  
" Sept. 1963

GUY C. ASKEY RE.  
Bedford, Pa.

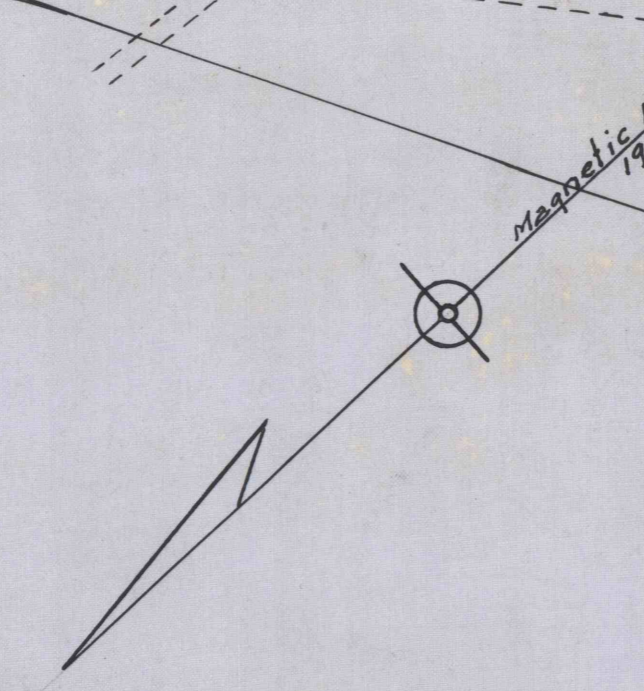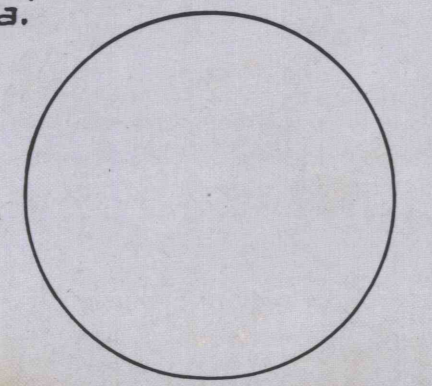

Approx. ± H.B.B.R. Grading