

W. W. REED
Schenectady, N.Y.

MAP of McCLAIN MINES

McCLAIN COAL COMPANY
situated in
CARBON TOWNSHIP—HUNTINGDON COUNTY



Scale: 1"=100'

—1944—

Guy C. Askey, Min. Engr.
Bedford, Pa.

OPERATED BY
CHAMBERLAIN BROTHERS COAL CO. ^{1/2} & ACE COAL CO.
Six Mile Run, Pa. Coalport, Pa.

REVISED Oct. 1964 (Barnett)

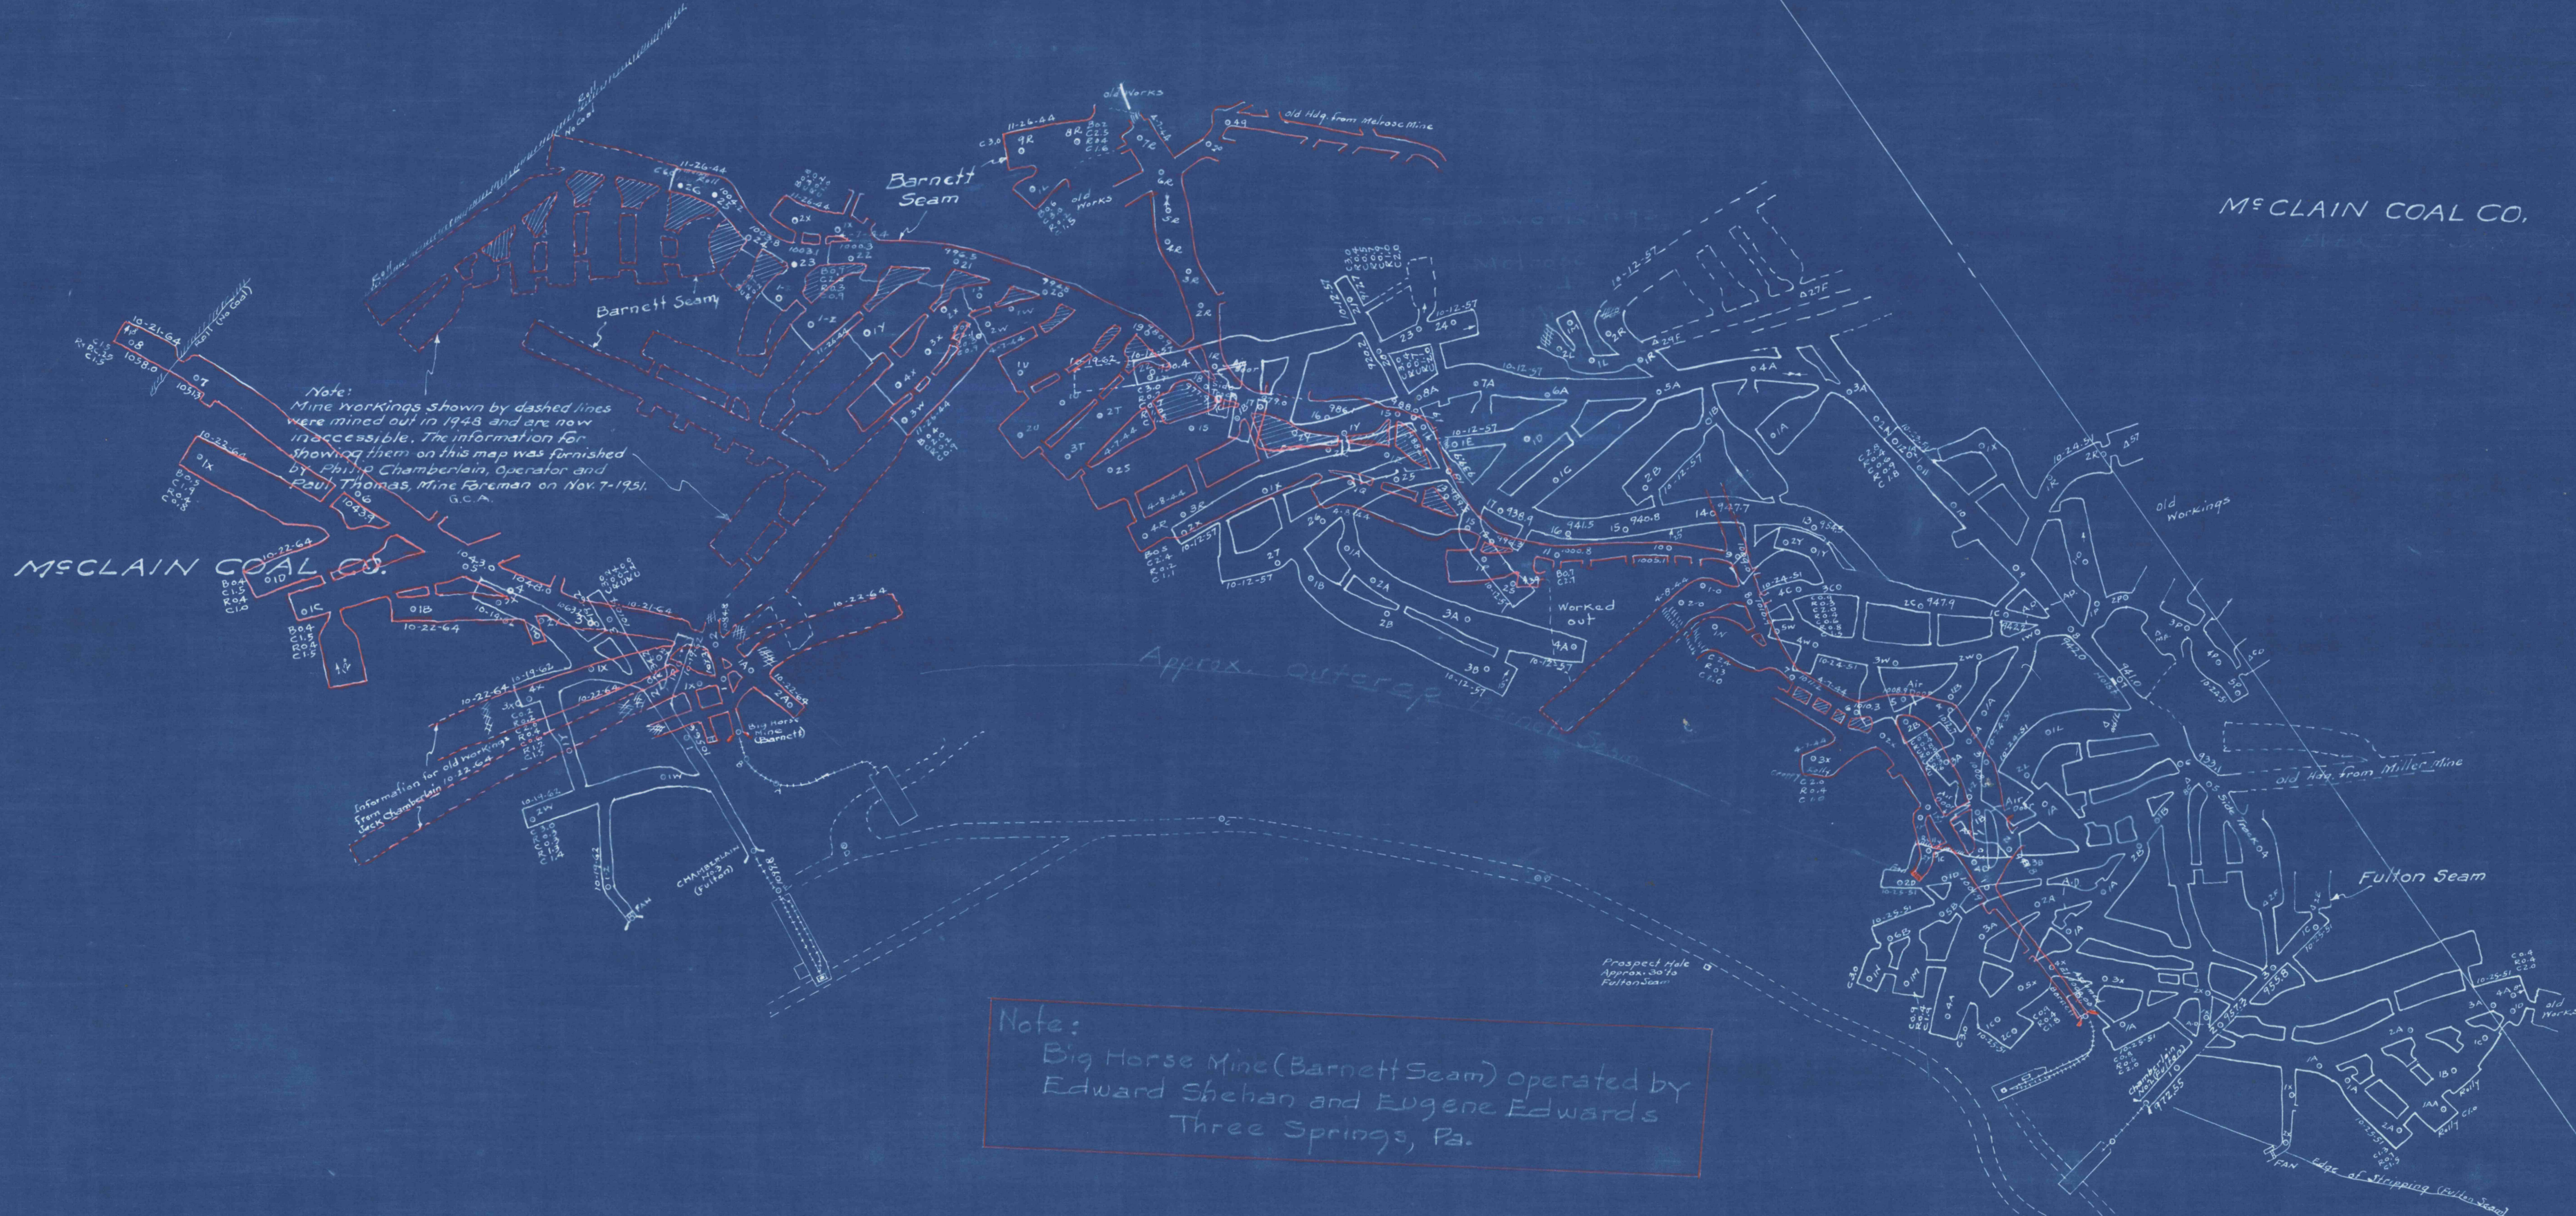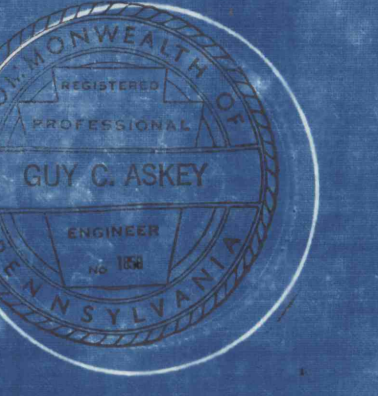

H & B. T. R. R. CO.

MILLER
CRAWN