

W. W. REED
Benedict Trust

MAP of McCLAIN MINES

McCLAIN COAL COMPANY

Situated in
CARBON TOWNSHIP—HUNTINGDON COUNTY


Scale: 1"=100'

— 1944 —

Guy C. Askey, Min. Engr.
Bedford, Pa.

OPERATED BY
CHAMBERLAIN BROTHERS COAL CO. ^{1/2}W. ACE COAL CO.
Six Mile Run, Pa. Coalmont, Pa.

REVISED

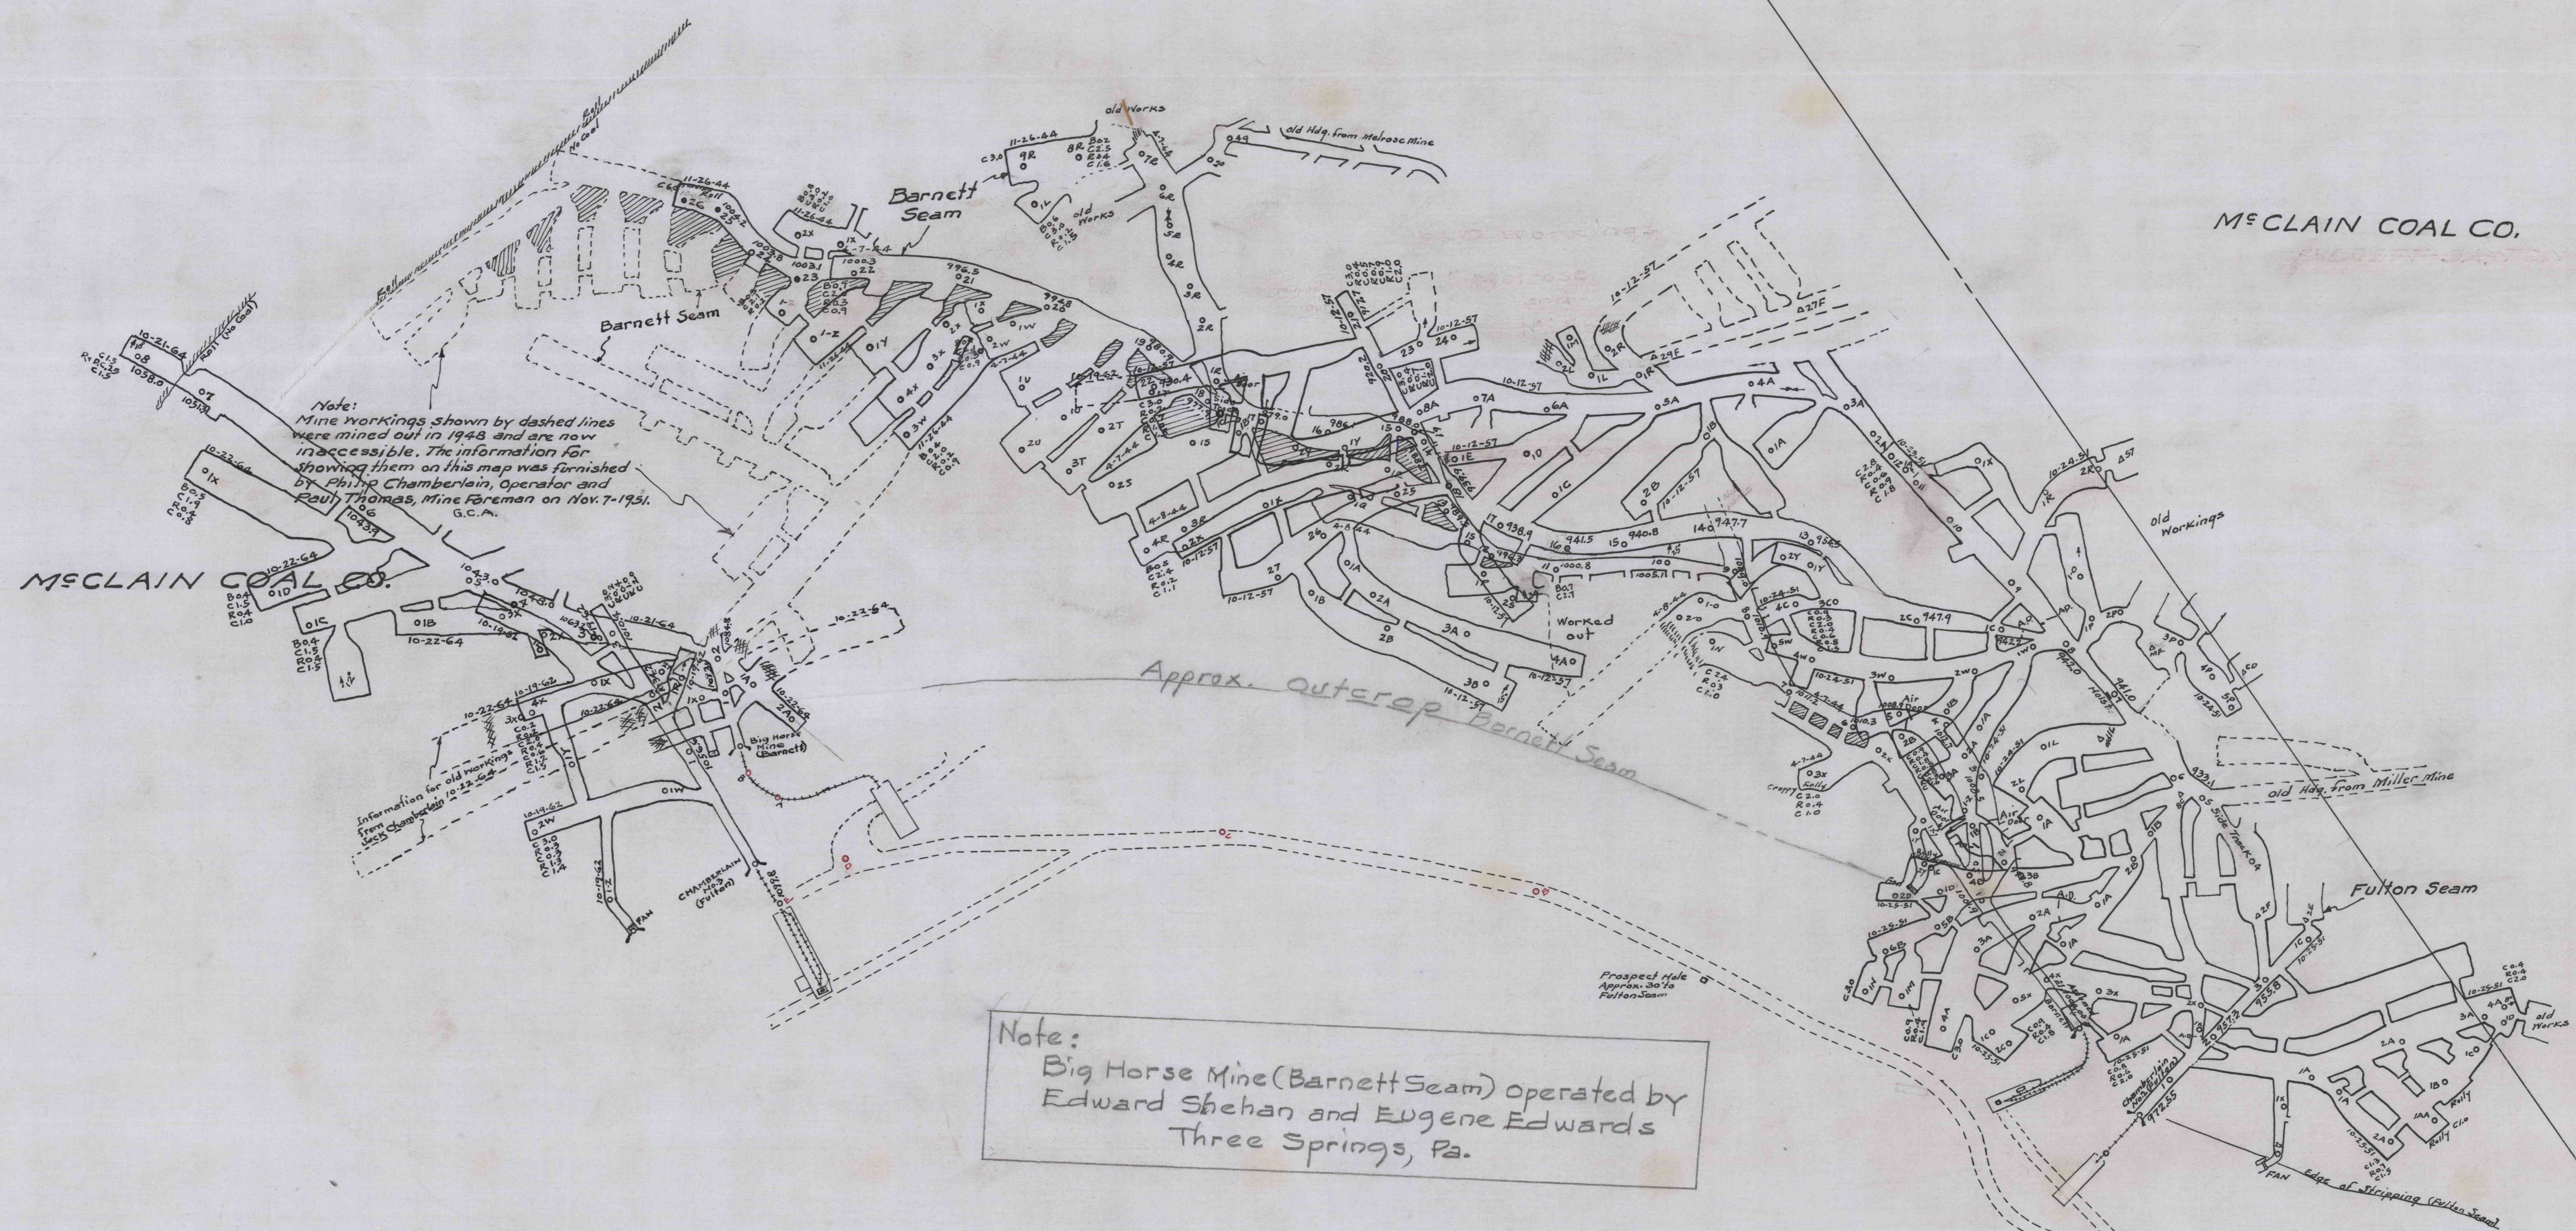

H & B. T. R. R. CO.