


JOHN LANGDON



REED & WILSON

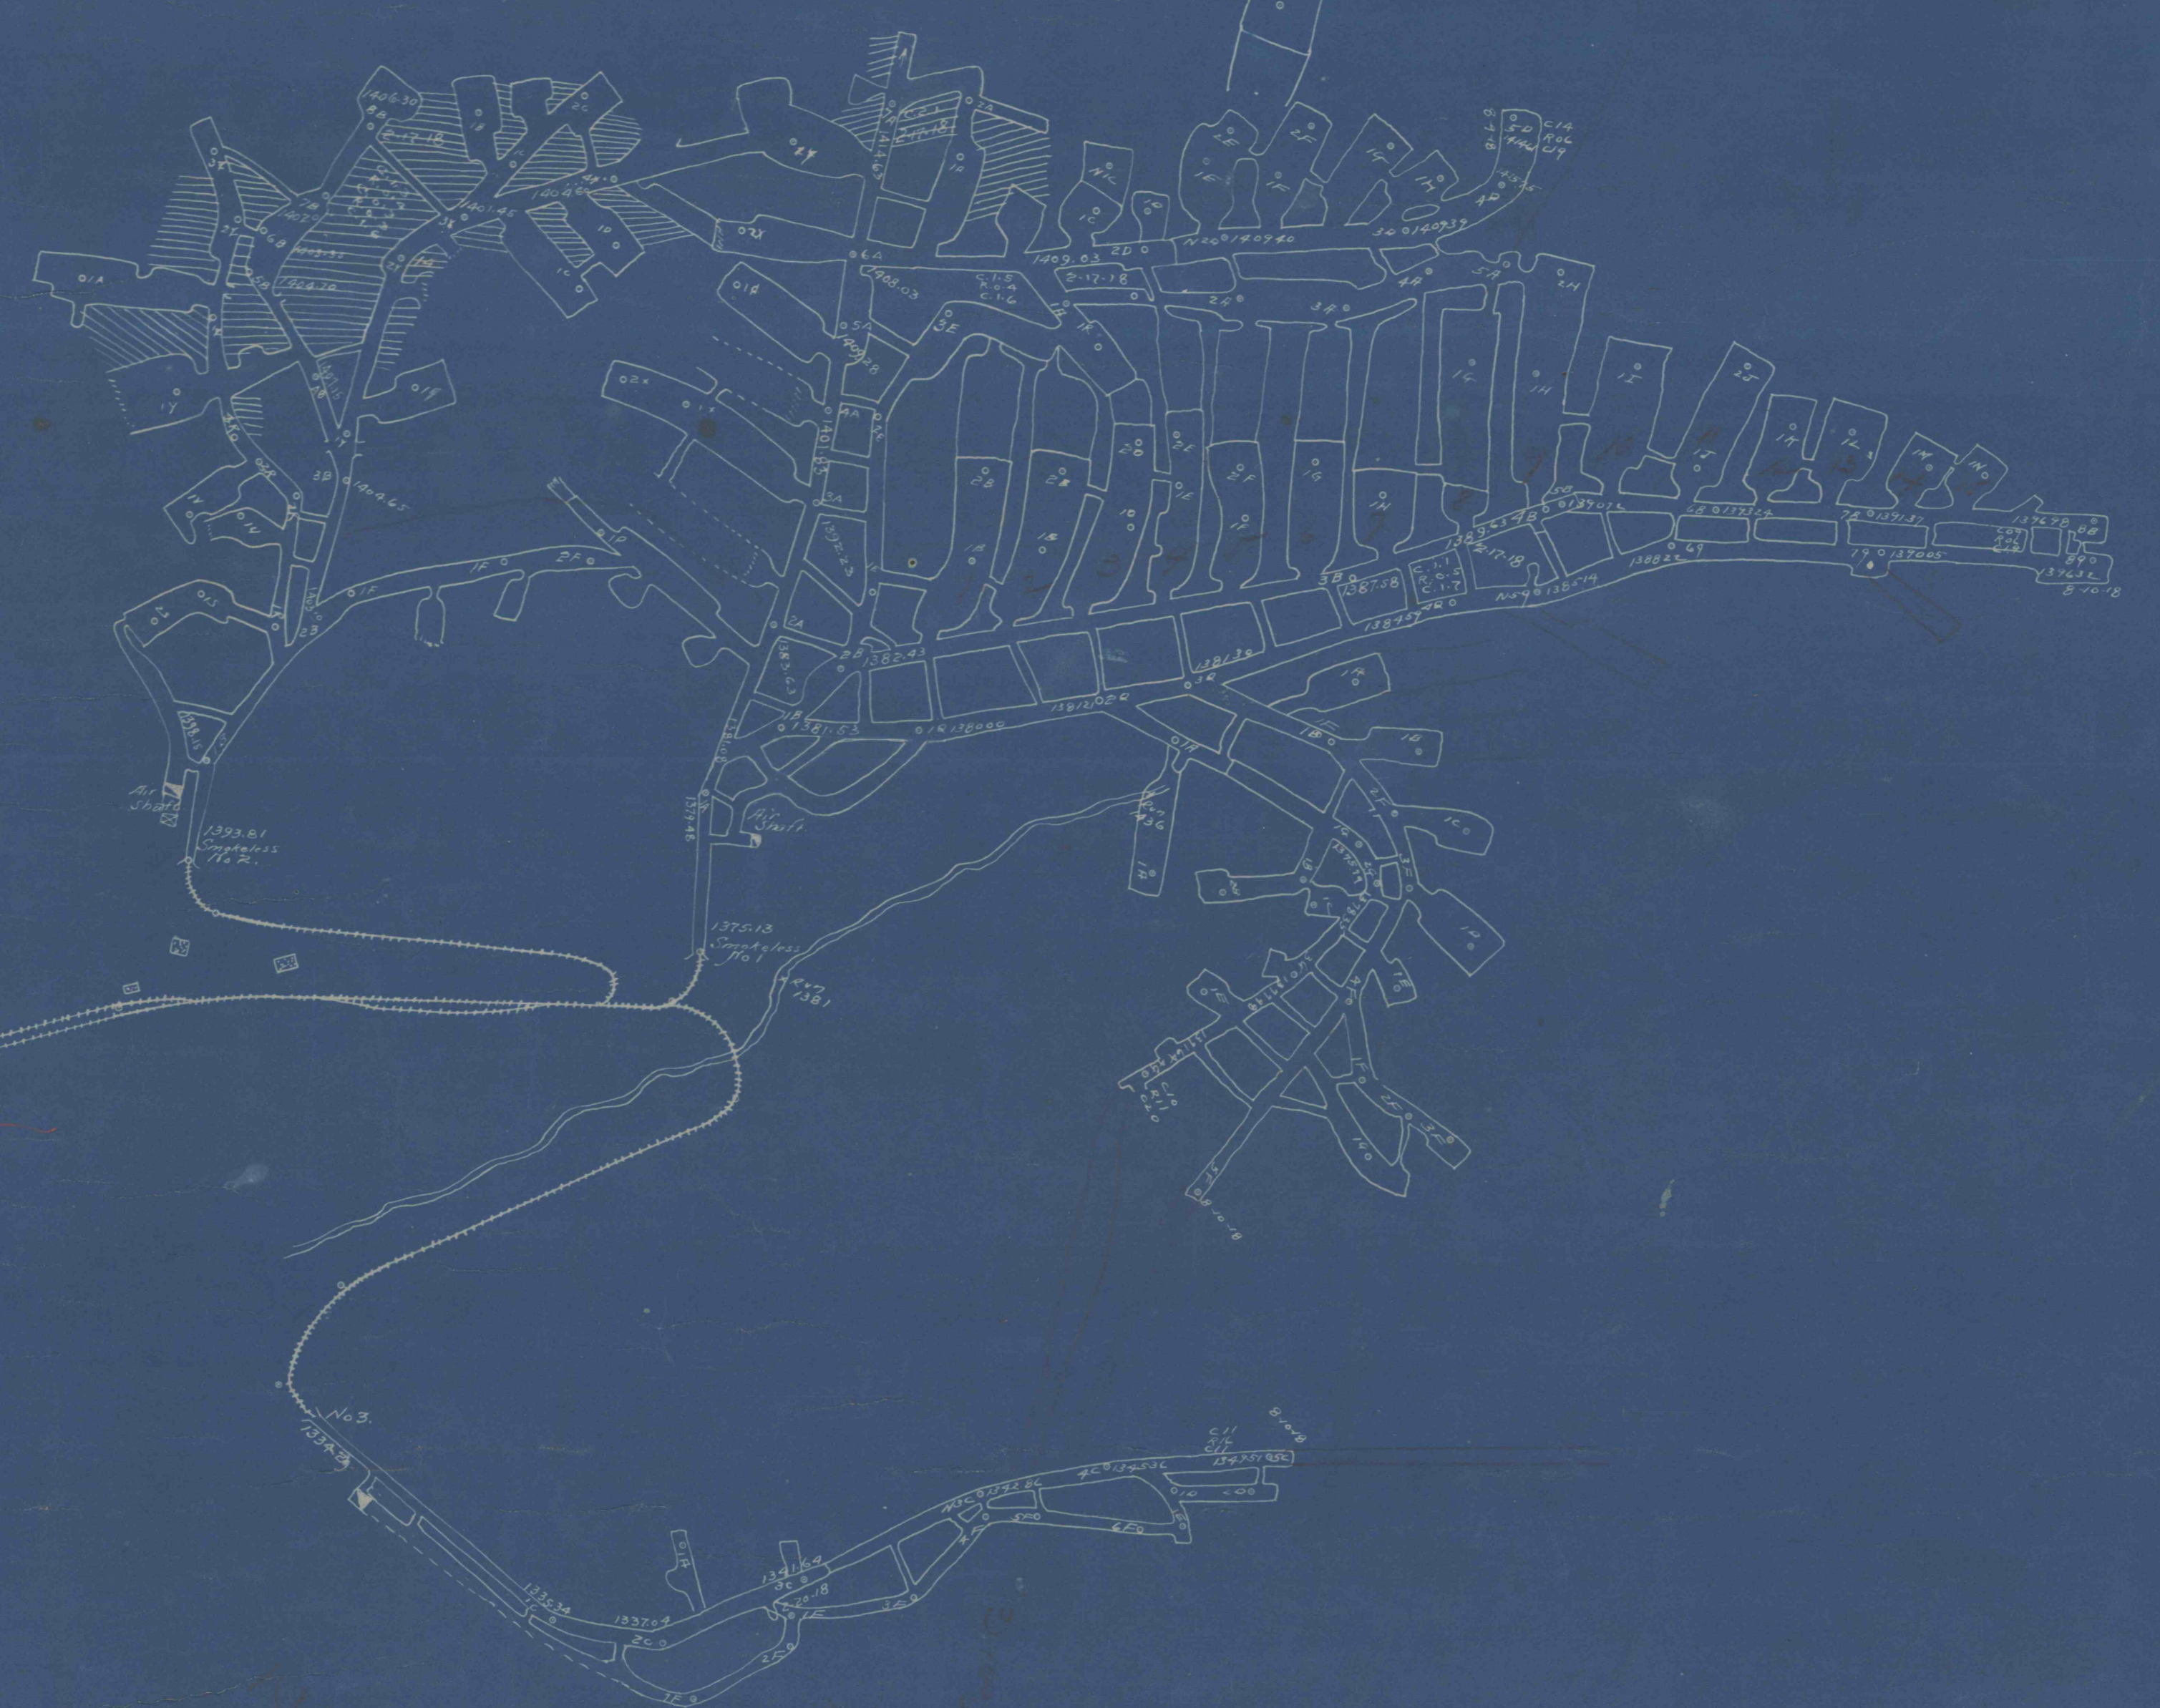

MAP
SMOKELESS MINES

OPERATED BY THE
Smokeless Coal Co

Scale: 1 inch = 100 feet
Henshaw, Banks & Carter, Mining Engineers
1918

8/16