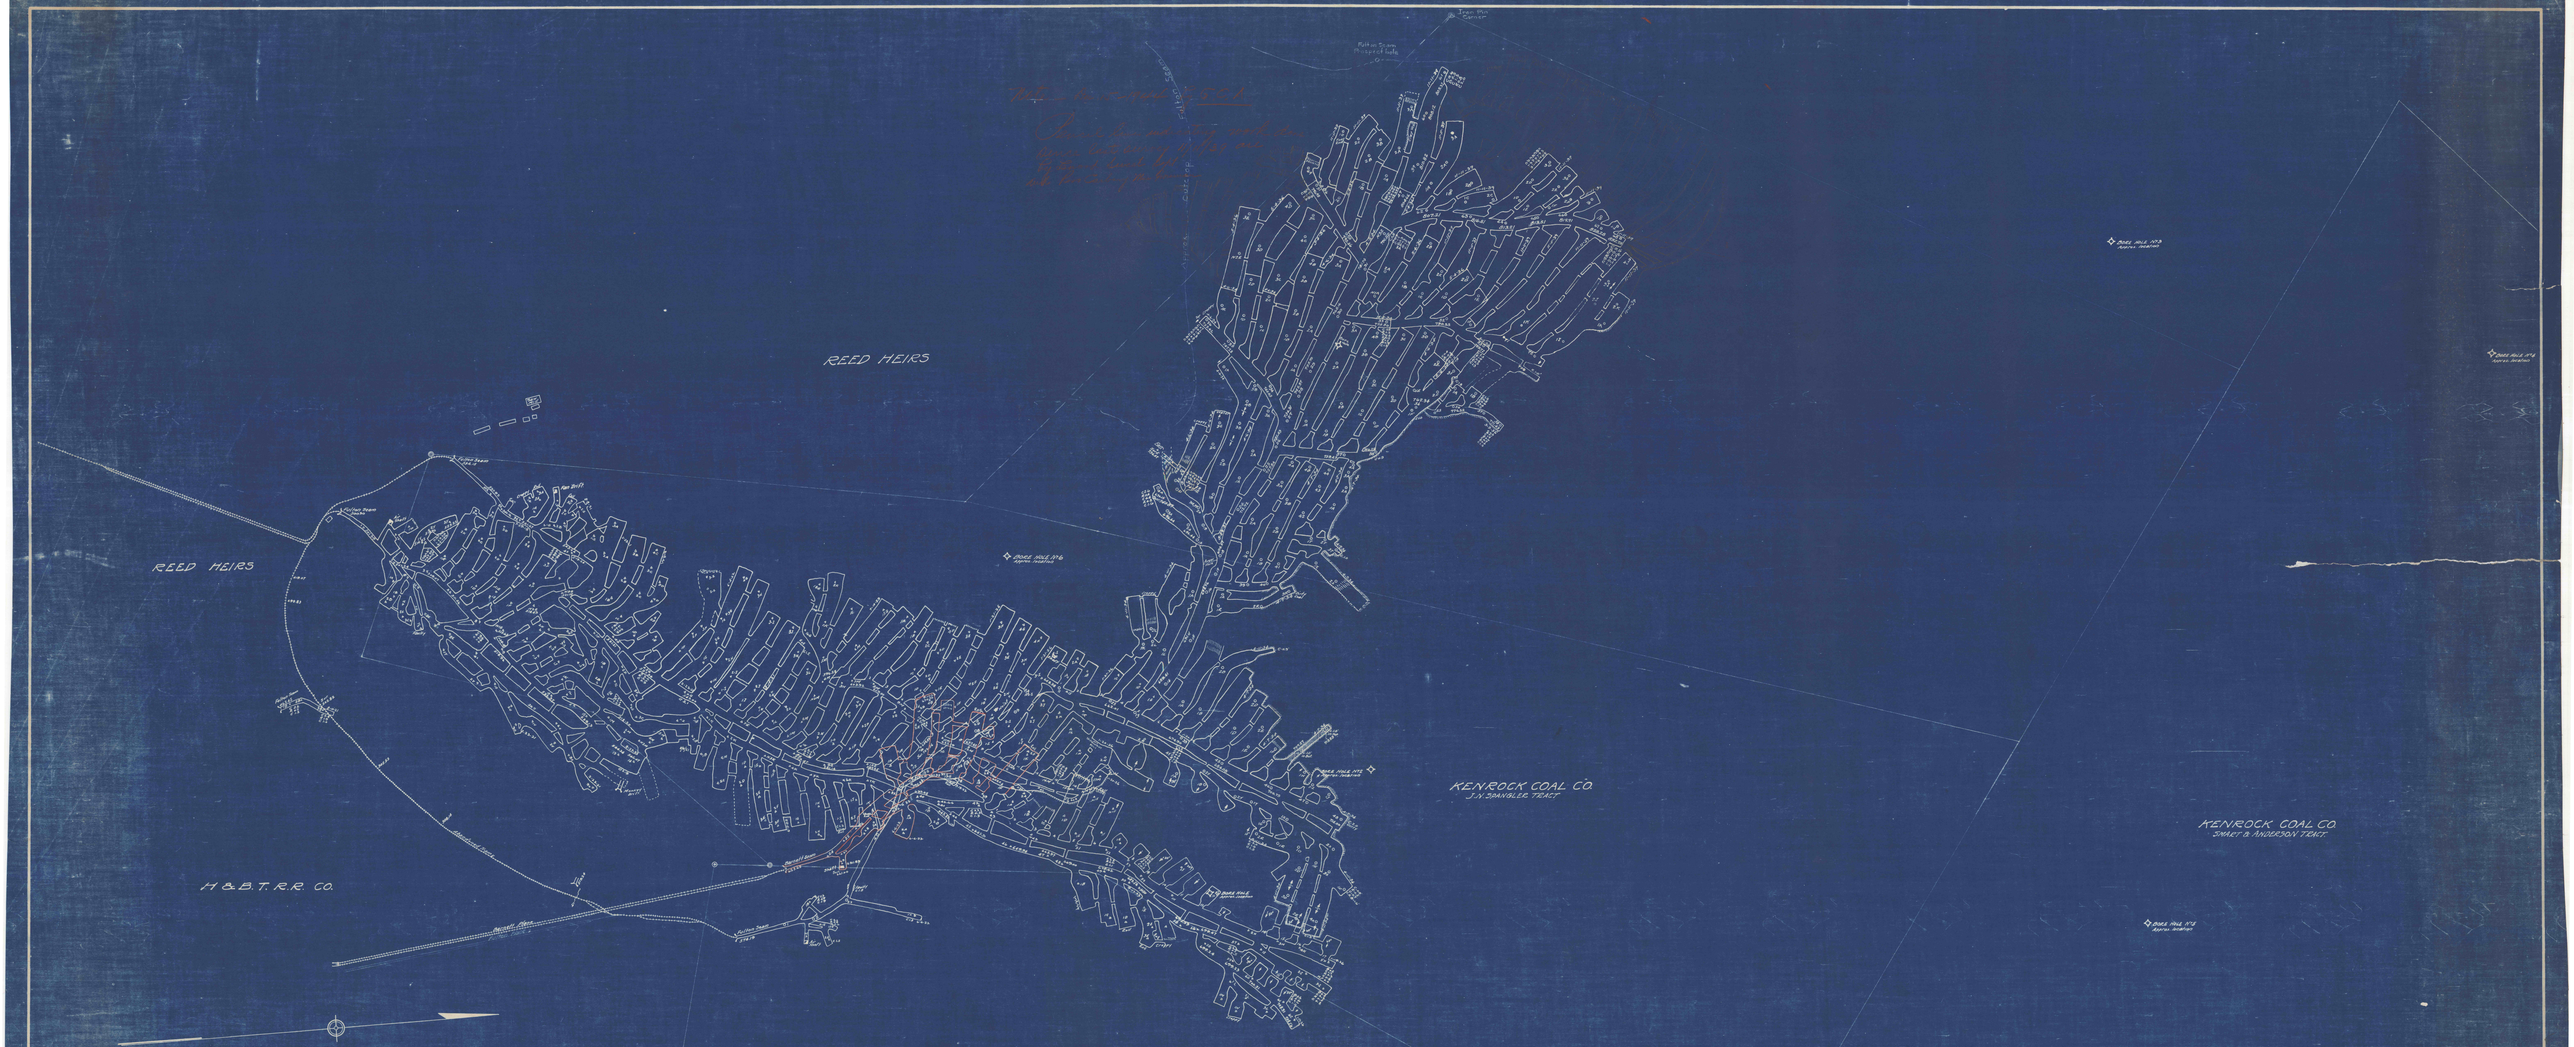

MAP
OF
KENROCK MINES

OPERATED BY

KENROCK COAL CO.

CARBON TOWNSHIP HUNTINGDON COUNTY

Scale 1" = 100'

—1931—

Note: Bore Holes and property lines are taken from old maps and descriptions, and are not located by surveys. U.S. & C. Stations are indicated thus: △

Revised NOV. 11-1931

B.T. 3.V.19.