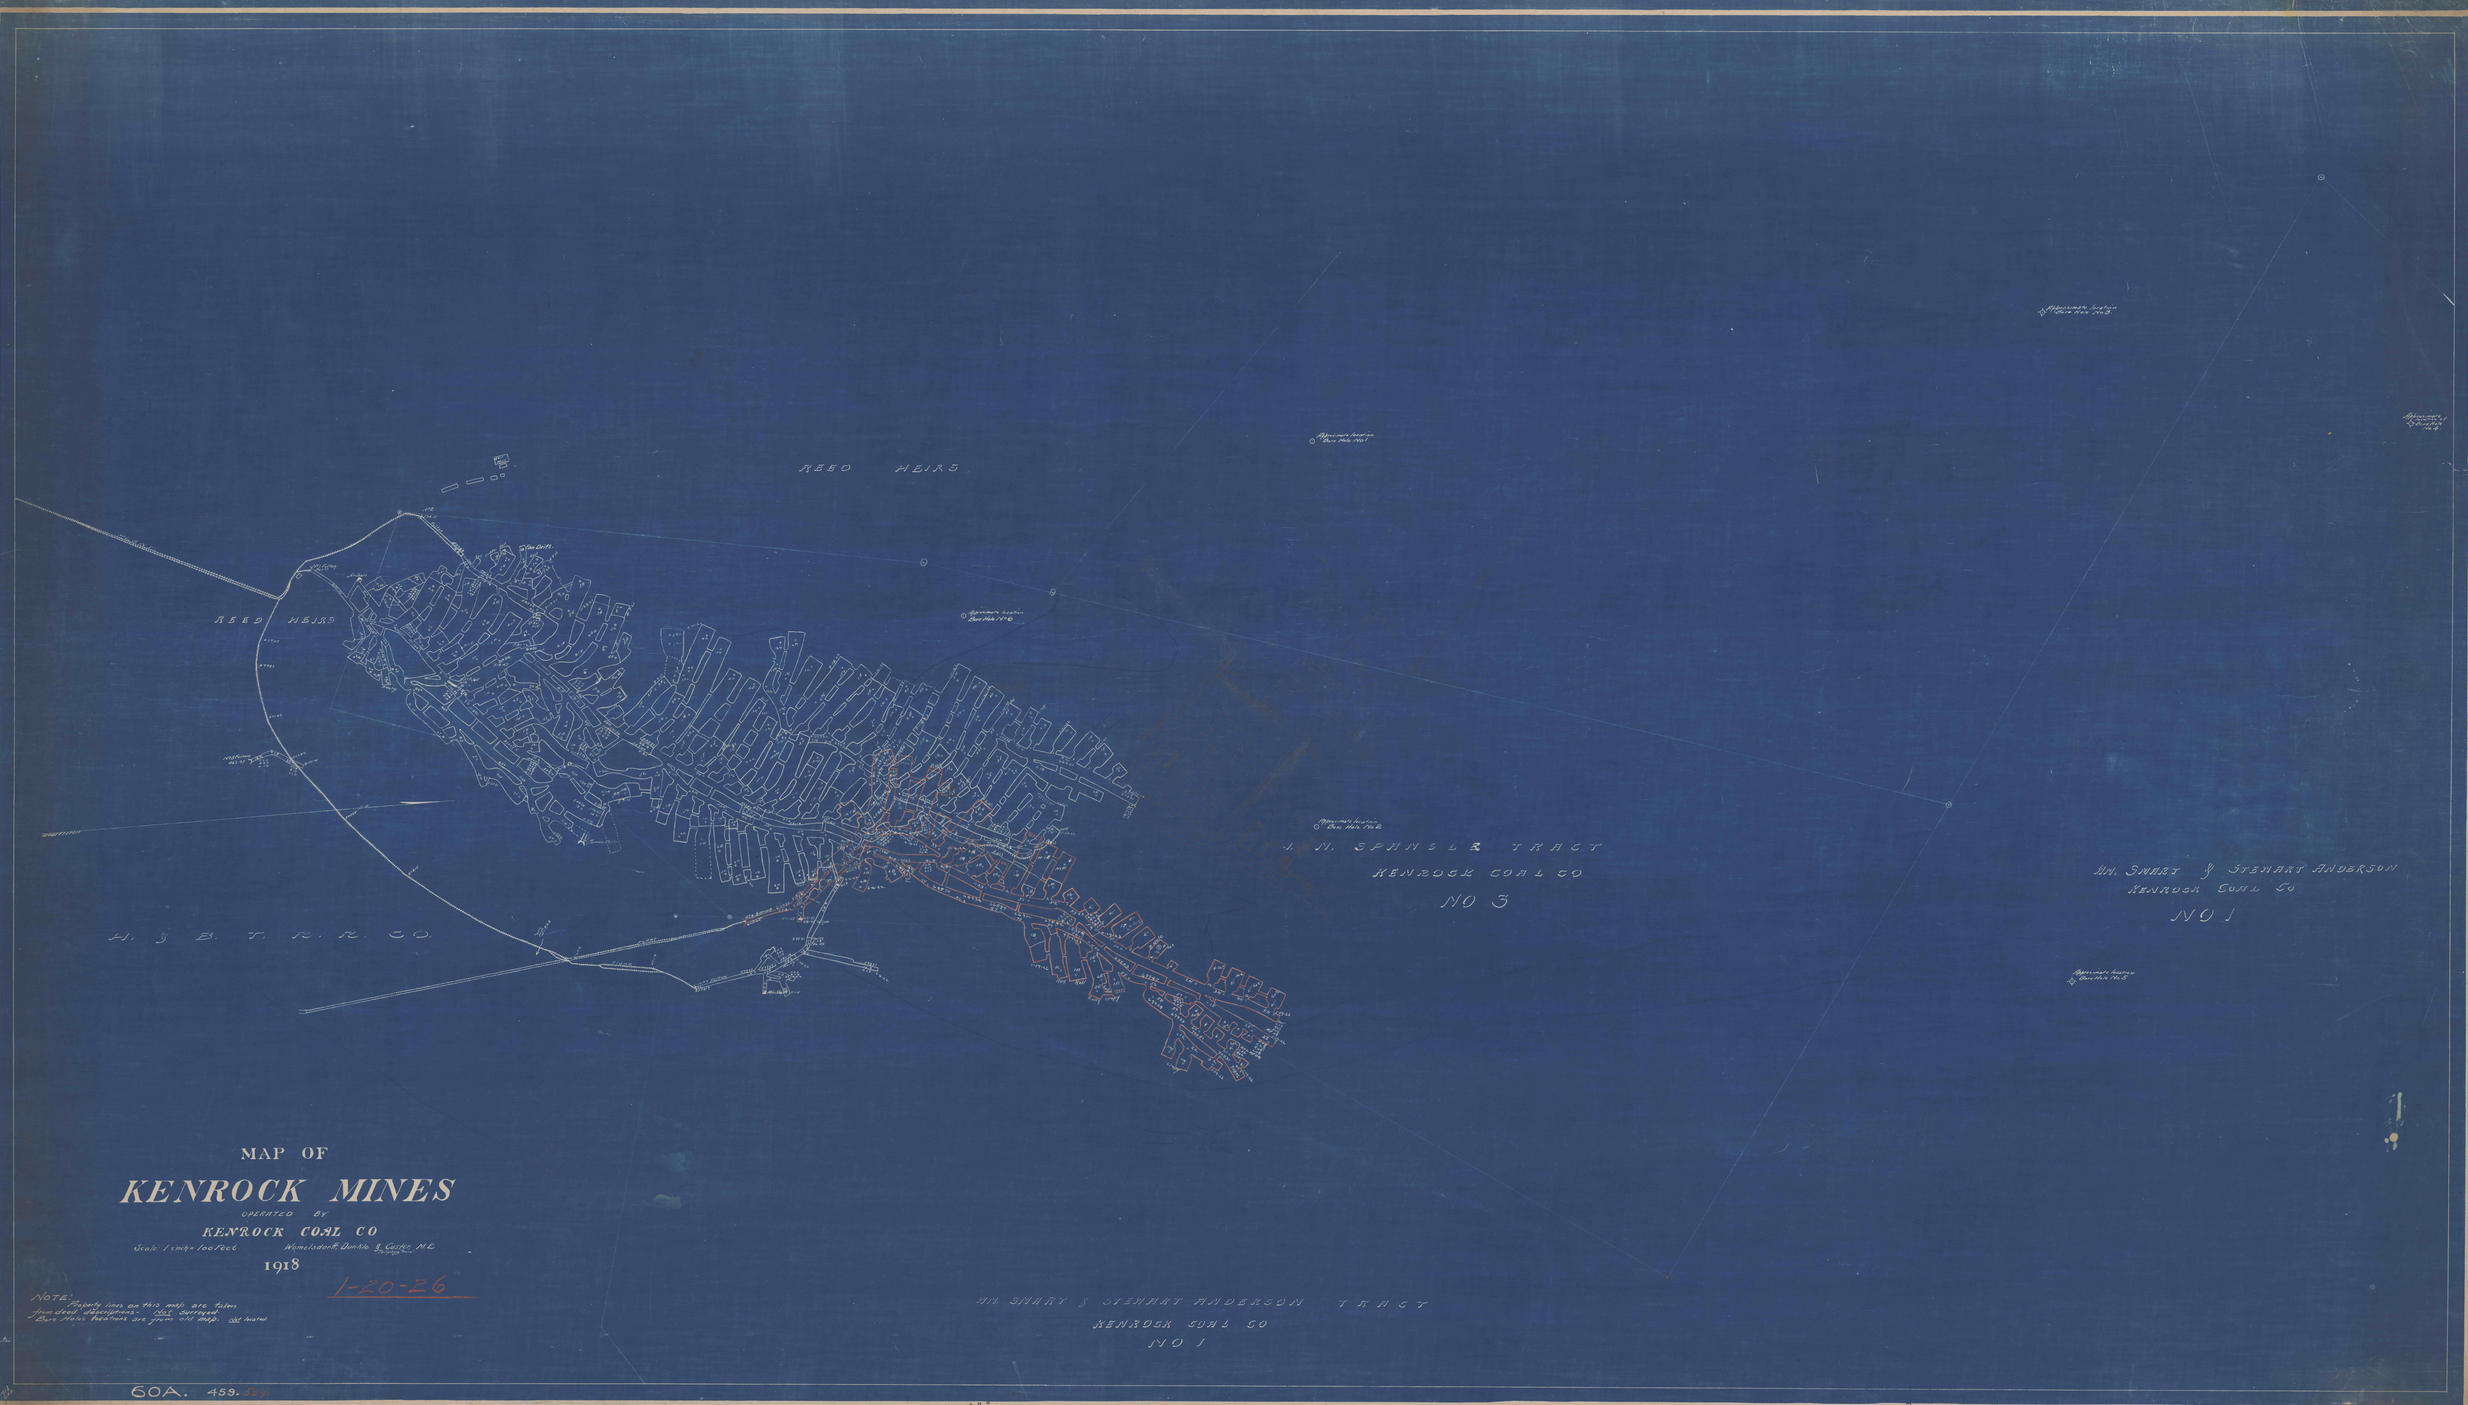
REED HEIRS
REED HEIRS
H. & B. T. R. R. CO.
A. N. SPANGLER TRACT
KENROCK COAL CO
NO 3
MN. SMART & STEWART ANDERSON
KENROCK COAL CO
NO 1
MN. SMART & STEWART ANDERSON TRACT
KENROCK COAL CO
NO 1
MAP OF
KENROCK MINES
OPERATED BY
KENROCK COAL CO
Scale 1 inch = 100 feet
Womelsdorff, Dunkle & Cooper, M.E.
1918
1-20-26
NOTE: Property lines on this map are taken from deed descriptions. Not surveyed. Bore hole locations are from old map. Not located
60A. 459.