

Abandoned Workings from Foreman Mine
Traced from blue print of Map and Surveys by W. A. Sullivan, Engr.

40' BARRIER PILLAR
N 40° 26' E

FOREMAN-WHITE COAL CO.

2310.6
50' BARRIER

6279.4

FOREMAN-WHITE COAL CO.
38975.2
7434.7

ZETH COAL CO.
38878.2
7434.7



Note: Old workings shown with dashed lines were traced from map of G. A. Faceman, dated Sept. 1940.

HARRIET MINES

OWNED BY

J. H. SIMON & SON

BROADTOP TOWNSHIP - BEDFORD COUNTY

Scale: 1" = 100'

(KELLY SEAM)


OPERATORS

No. 3 MINE - J. L. TENLEY

No. 4 MINE - JOSEPH ZELANKO & SON

No. 5 MINE - LARK COAL CO. - AMBERLAIN COAL CO.

Guy C. Askey, Min. Engr.
Bedford, Pa.

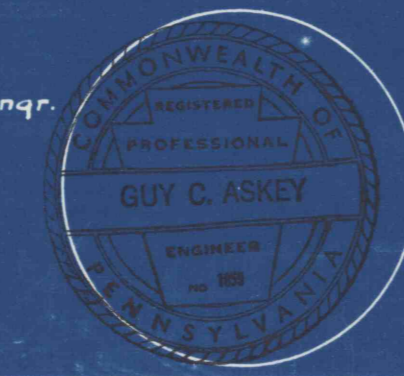

Revised Nov. 1959