
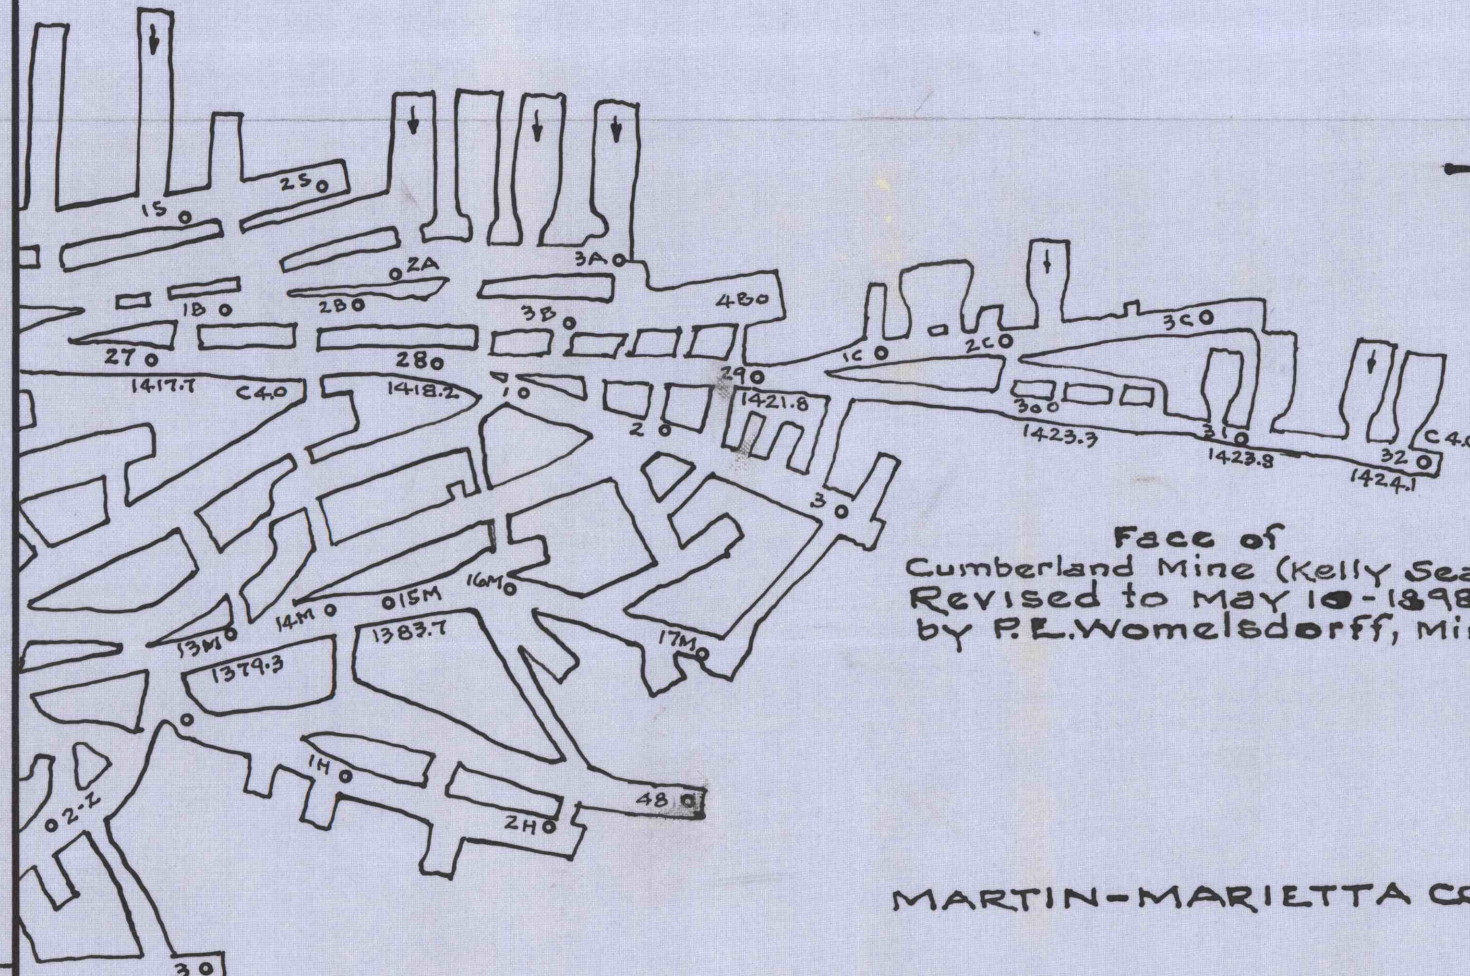



MARTIN-MARIETTA CO.

MARTIN-MARIETTA CO.

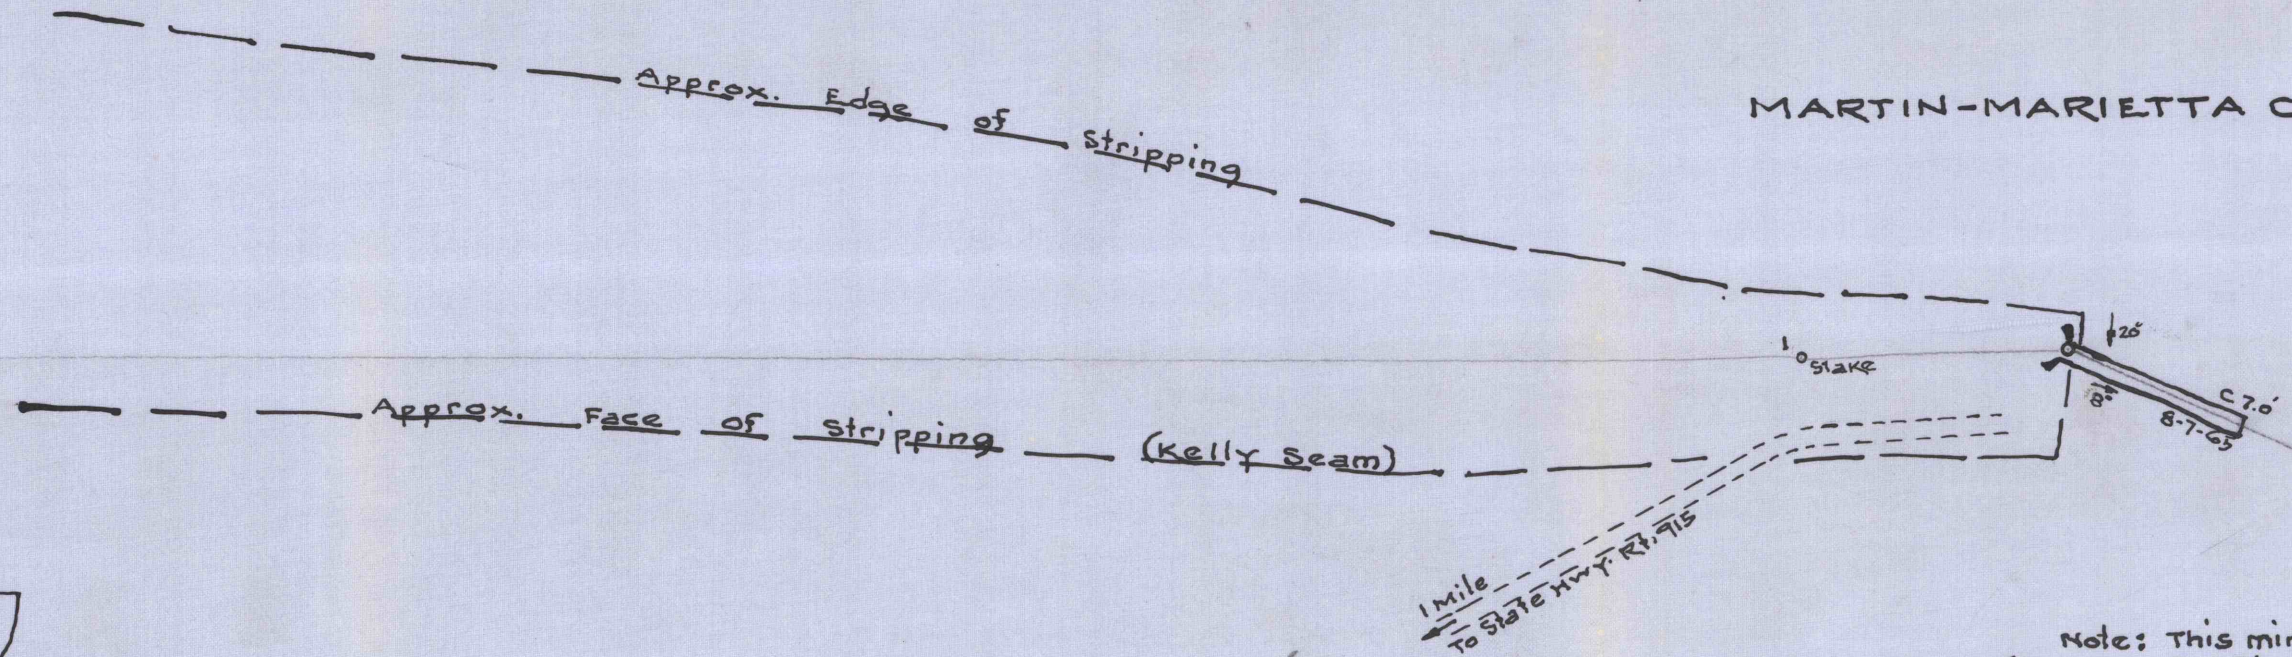

Face of
Cumberland Mine (Kelly Seam)
Revised to May 10-1965
by P.E. Womelsdorff, Min. Engr.

Note: This mine was abandoned by
O.J. Shaw August 7-1965

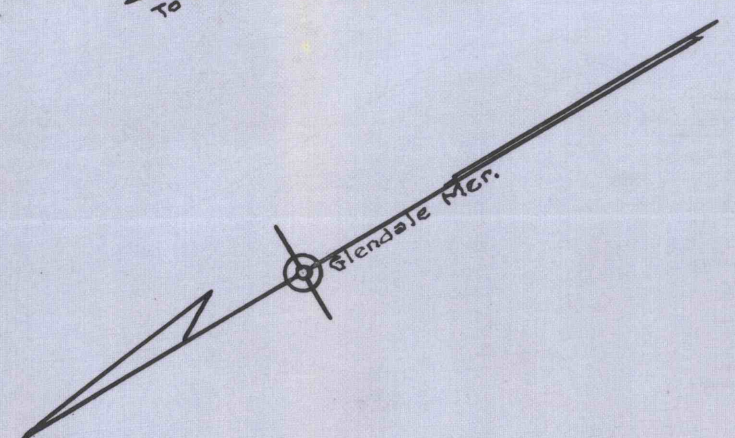

MARTIN-MARIETTA CO.

MINE ON FACE OF STRIPPING
OPERATED BY O.J. SHAW
BROAD TOP TOWNSHIP - BEDFORD COUNTY
Scale: 1"=100'

Guy C. ASKEY, P.E.
Bedford, Pa.

Aug. 1965

N. 54. B-6. AT-19

Manway