


MARTIN-MARIETTA CO.

MARTIN-MARIETTA CO.




Face of  

MARTIN-MARIETTA CO.

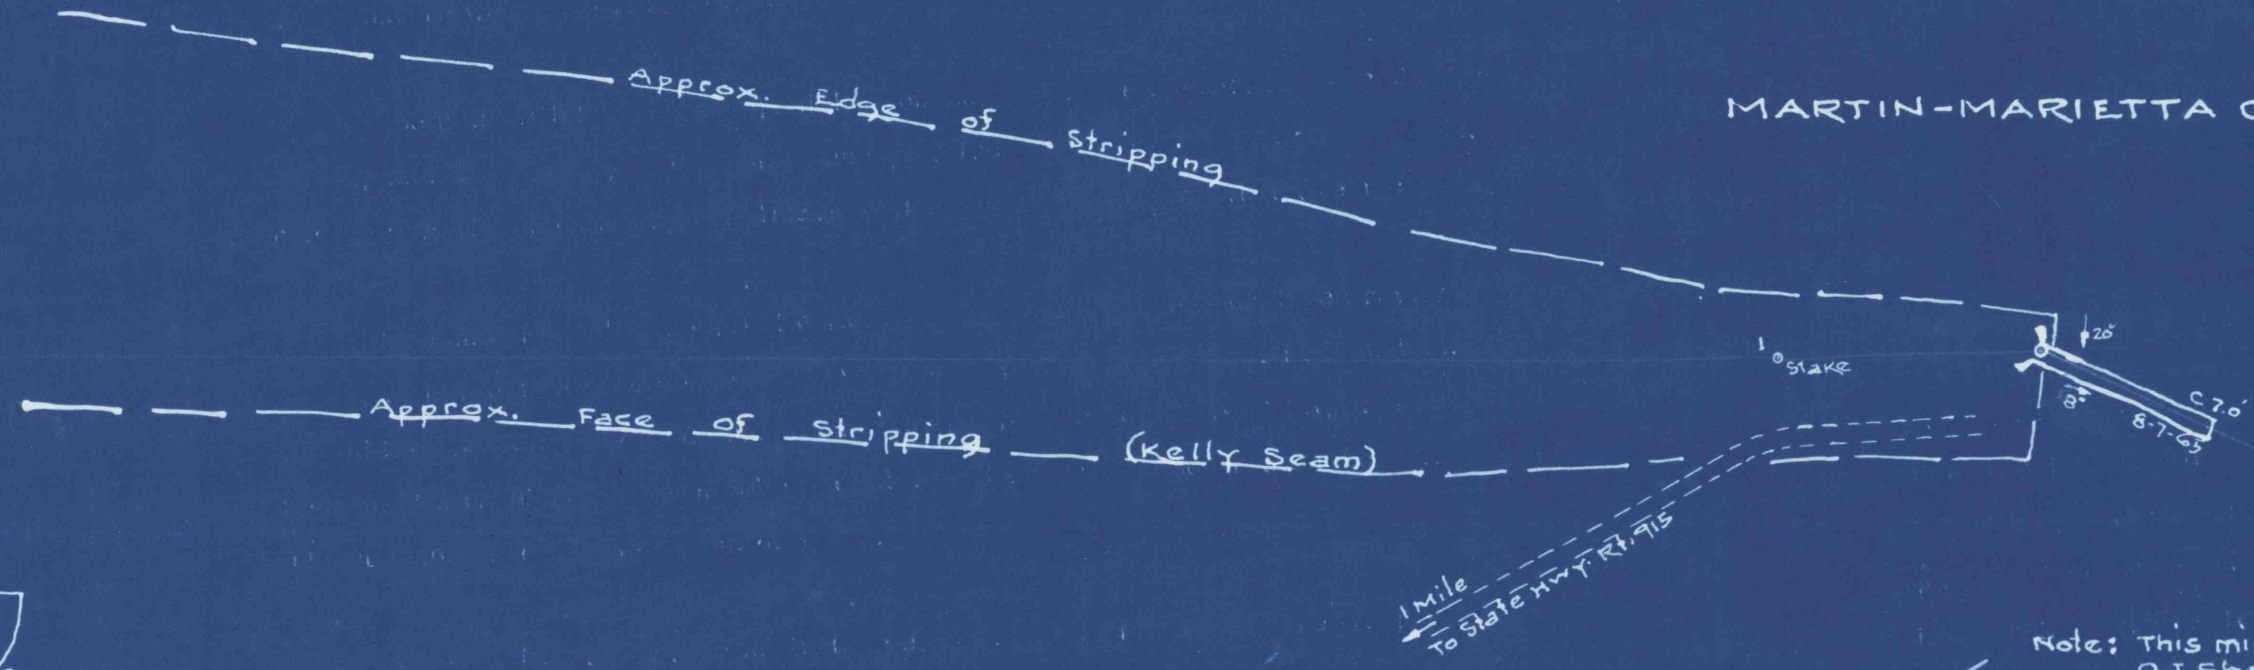


Note: This mine was abandoned by  
O.J. Shaw August 7-1965

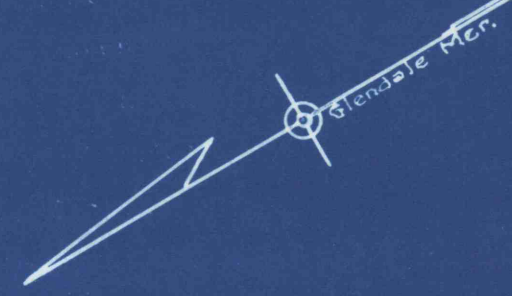

MINE ON FACE OF STRIPPING  
OPERATED BY O.J. SHAW  
BROAD TOP TOWNSHIP - BEDFORD COUNTY  
Scale: 1"=100'  
Guy C. Askey, P.E.  
Bedford, Pa.

Aug. 1965

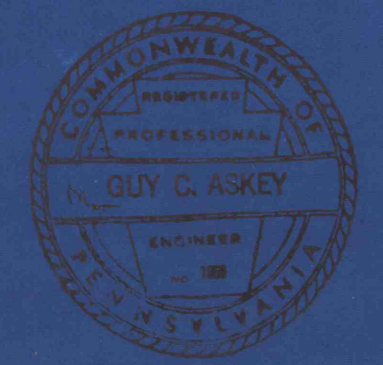

Manway

N.54. B-6. AT-19