


FOREMAN-WHITE COAL CO.

ZETH COAL CO.
J. C. Foyard tract

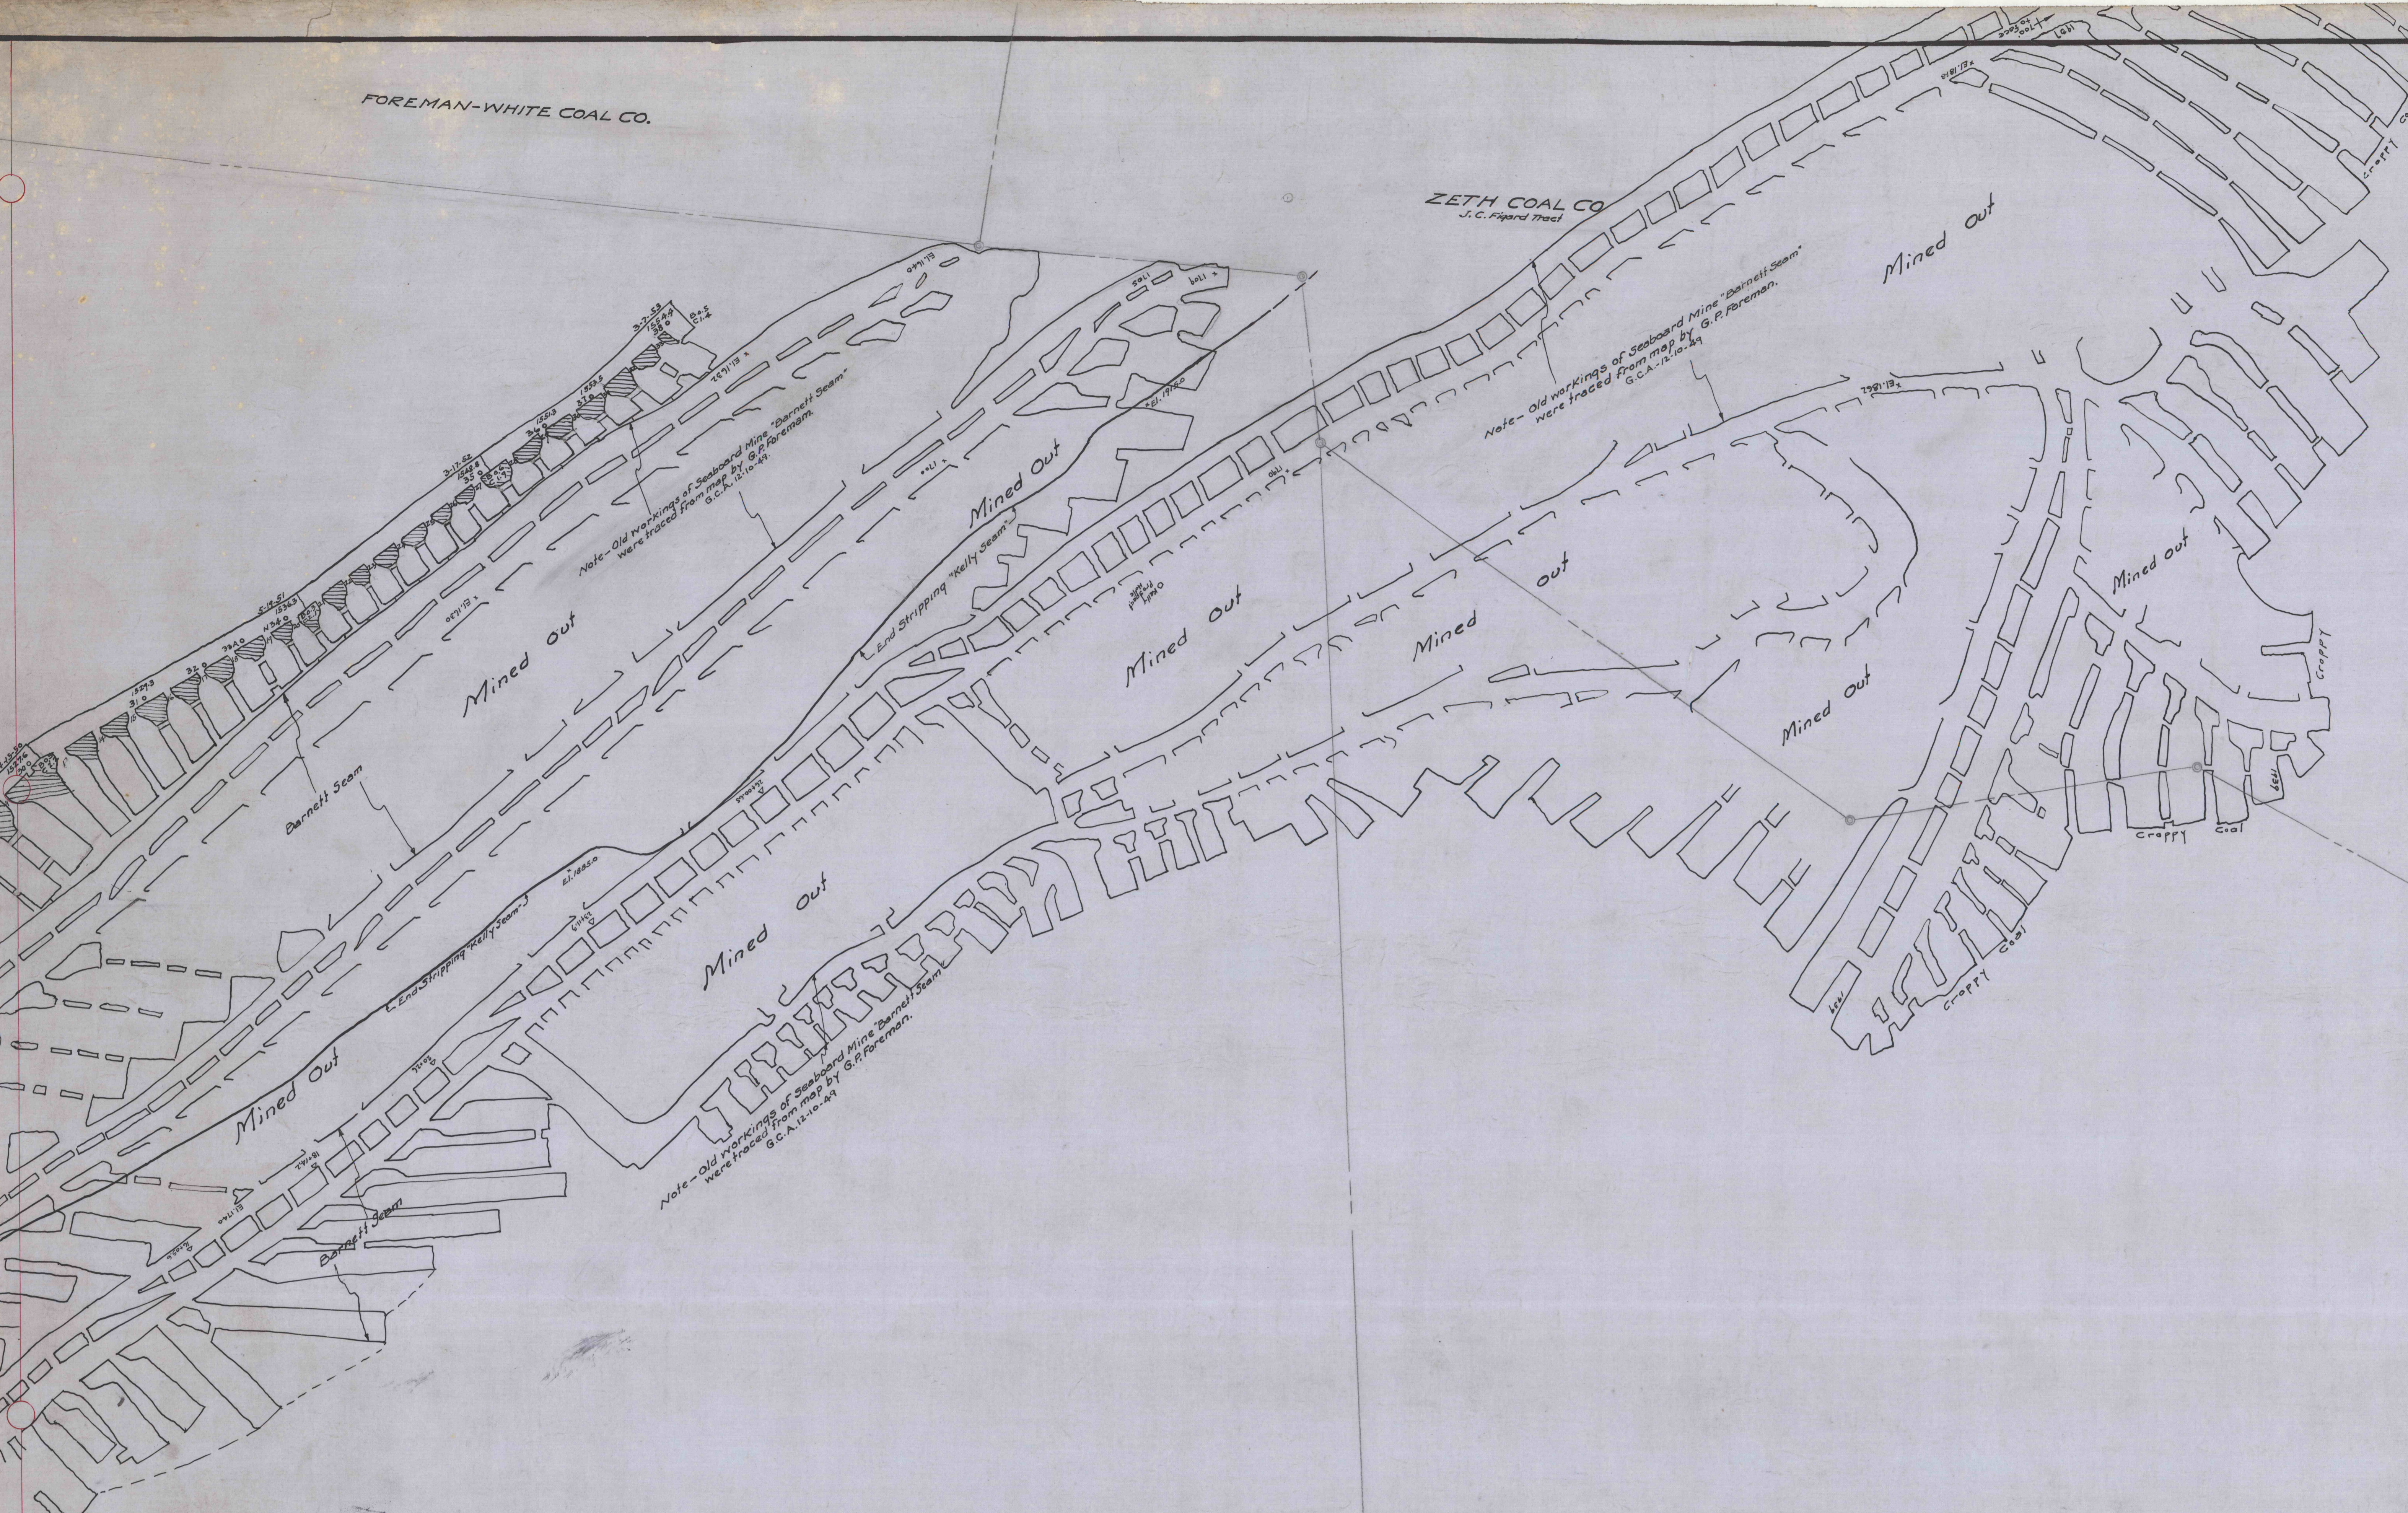

J. H. SIMON & SON
John Ballman tract
Approx. 170 Acres

J. H. SIMON & SON
John Bell tract
Approx. 300 Acres

JOHN LANGDON EST.