


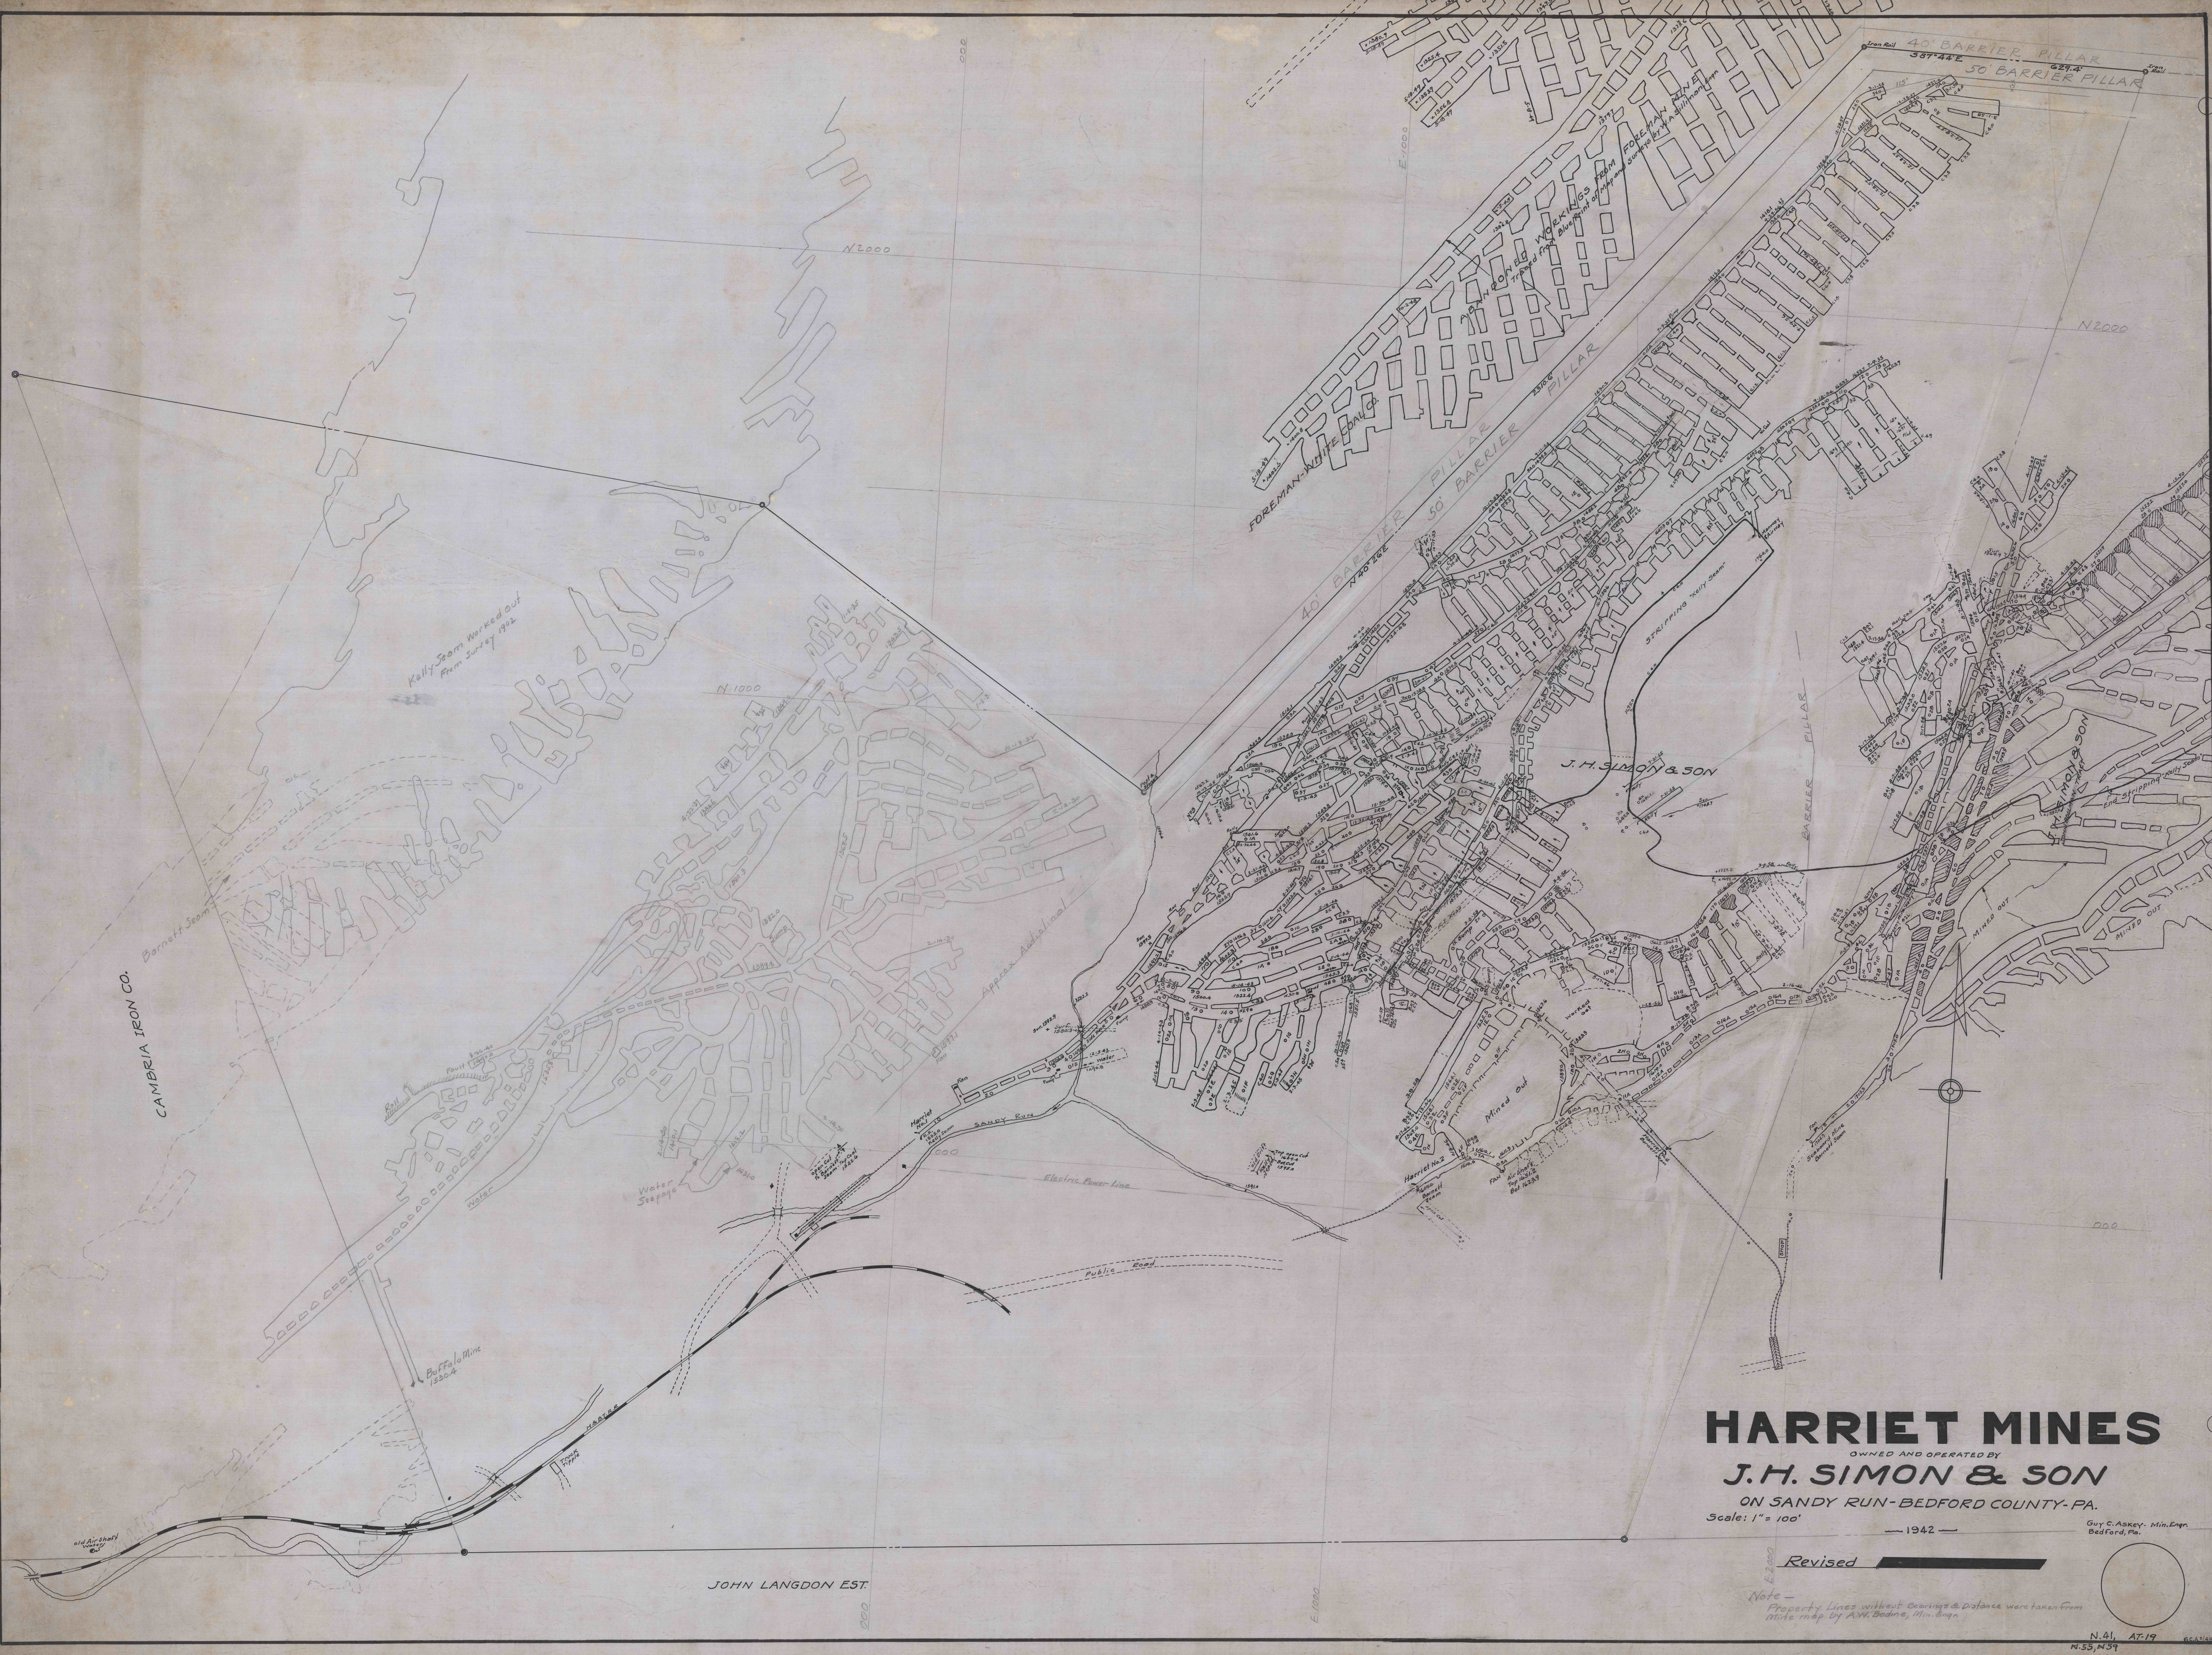

HARRIET MINES

OWNED AND OPERATED BY
J.H. SIMON & SON

ON SANDY RUN-BEDFORD COUNTY-PA.

Scale: 1" = 100'

1942

Guy C. Askey, Min. Engr.
Bedford, Pa.

Revised

Note -
Property Lines without Bearings & Distance were taken from
this map by A.W. Bedno, Min. Engr.

N. 41, AT-19
N. 55, N. 39