



GUM

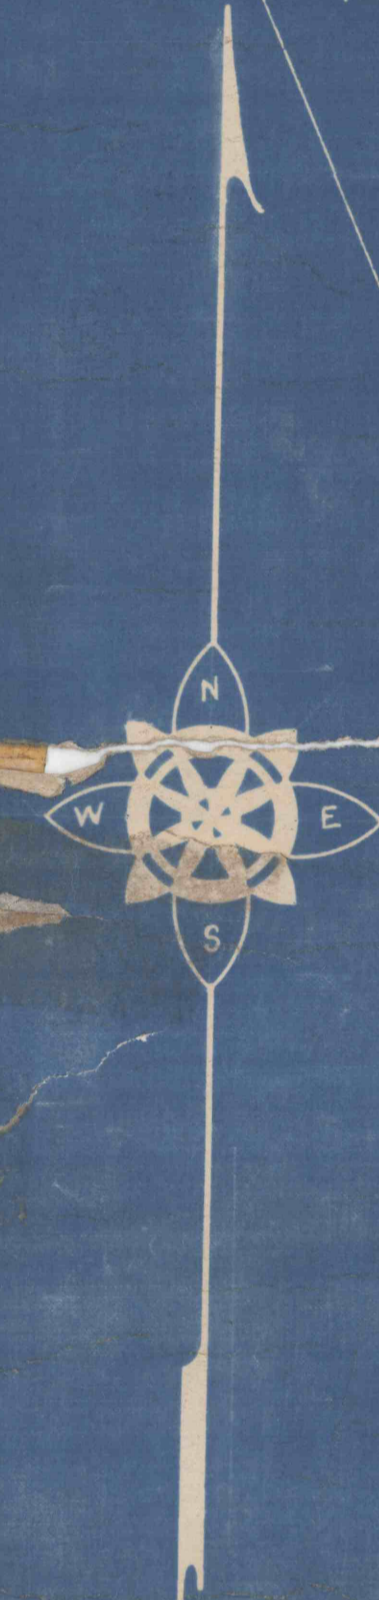

J. H. SIMON'S  
PART of JOHN BOLLMAN TRACT.  
190 ACRES

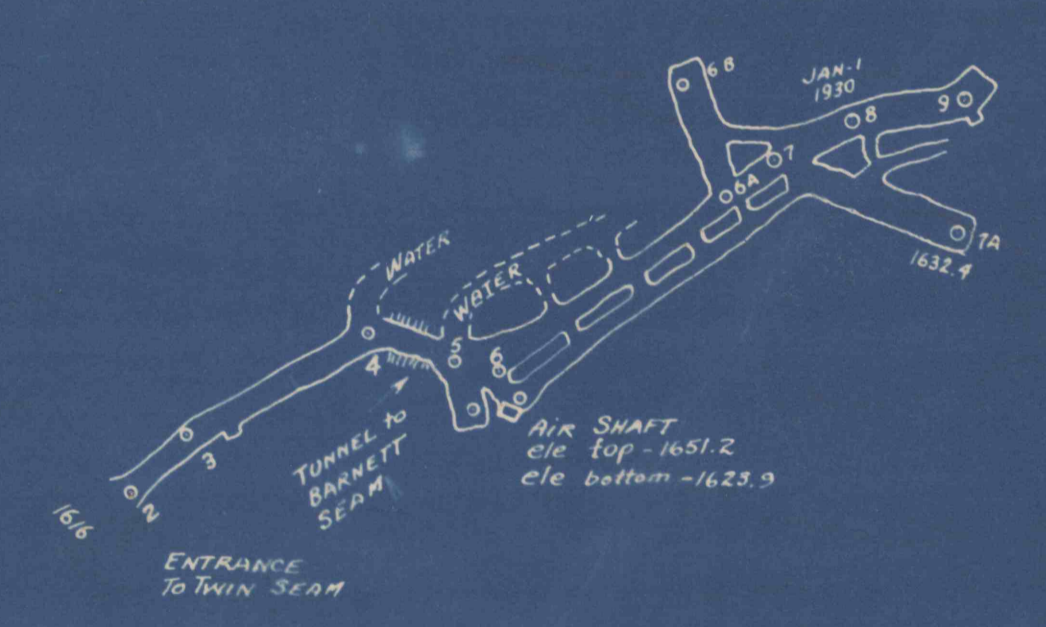

### PROPERTY AND MINE MAP

OF  
J. H. SIMONS  
LOCATED ON SANDY RUN - BROAD TOP TOWNSHIP  
BEDFORD COUNTY, PENNA.,  
SCALE 1" = 100' TRACED 5-5-37.

A. W. BODINE Reg. Eng'r No 1523  
AND  
ASSOCIATES  
HUNTINGDON PA.

NOTE  
OLD MINE WORKINGS AND PROPERTY LINES COMPILED FROM MAPS OF  
OTHER ENGRS. CORRECTIONS MADE ON COURSE OF CREEK & OUTCROP  
LINES ALSO CORRECTED PLOTTING ERROR IN BACK HEADING OF  
BUFFALO MINE BETWEEN STAS 5-6 & 1.