



NEW ENTERPRISE STONE & LIME CO.

NEW ENTERPRISE STONE & LIME CO.

CLAIR BAKER  
(Surface only)

JOHN MELIUS  
(14 A. Surface only)

KAY COAL MINING CO.

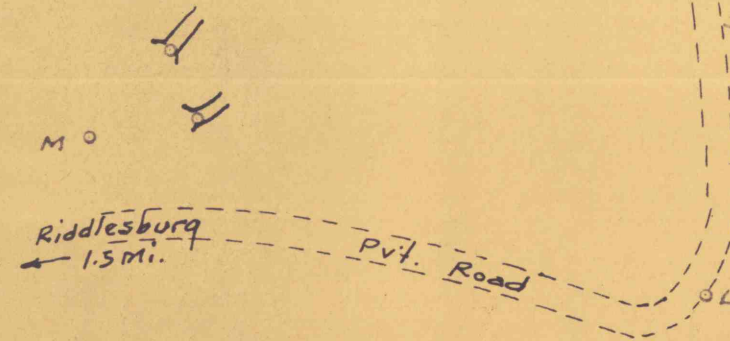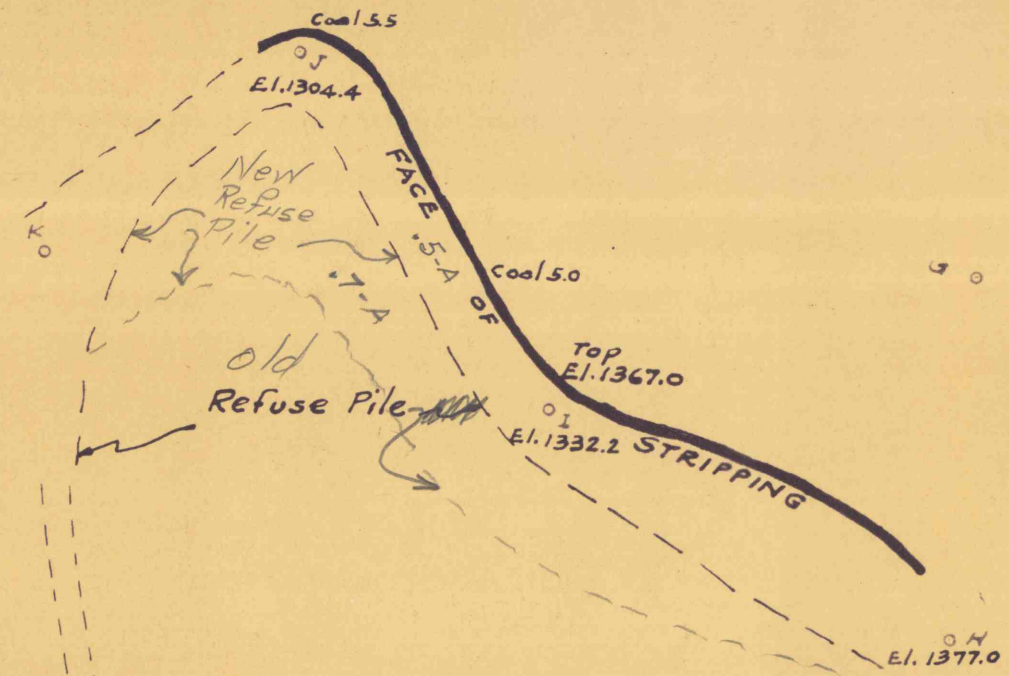

**STRIPPING OPERATION BY  
NEW ENTERPRISE STONE & LIME CO.**

Broad Top Township — Bedford County

Scale 1" = 100'

Guy C. Askey, P.E.  
Bedford, Pa.

Nov. 1957