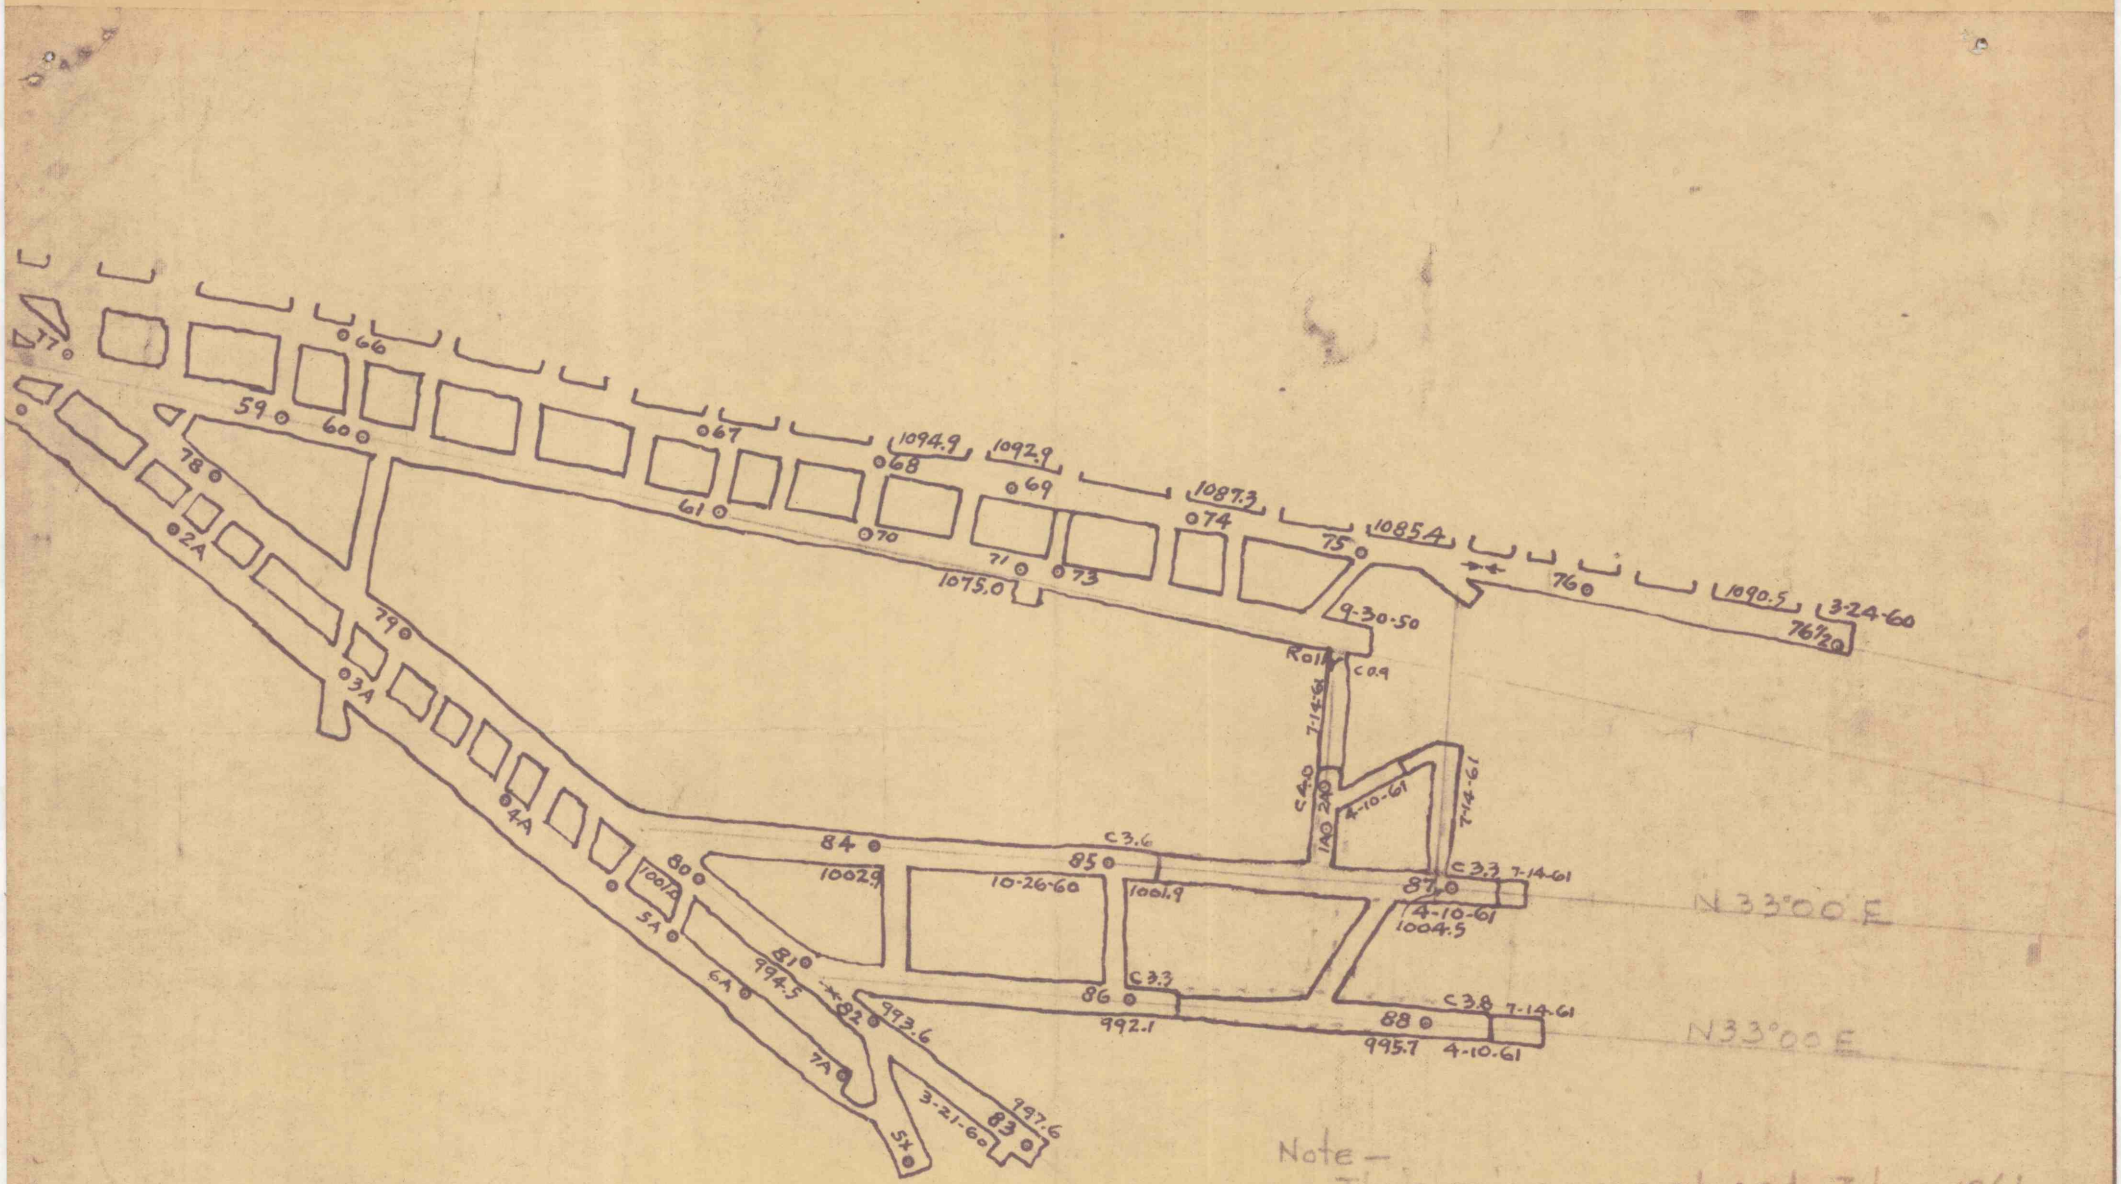

Note—
This mine was closed July 1-1961.
The last information shown on July 14-1961
was furnished by Wm Johnson, Supt. and
Robert George, Mine Foreman.
G.C.A.

No. 10 MINE
DETWEILER INDUSTRIES INC.

GUY C. ASKEY
MINING ENGINEER
BEDFORD, PA.