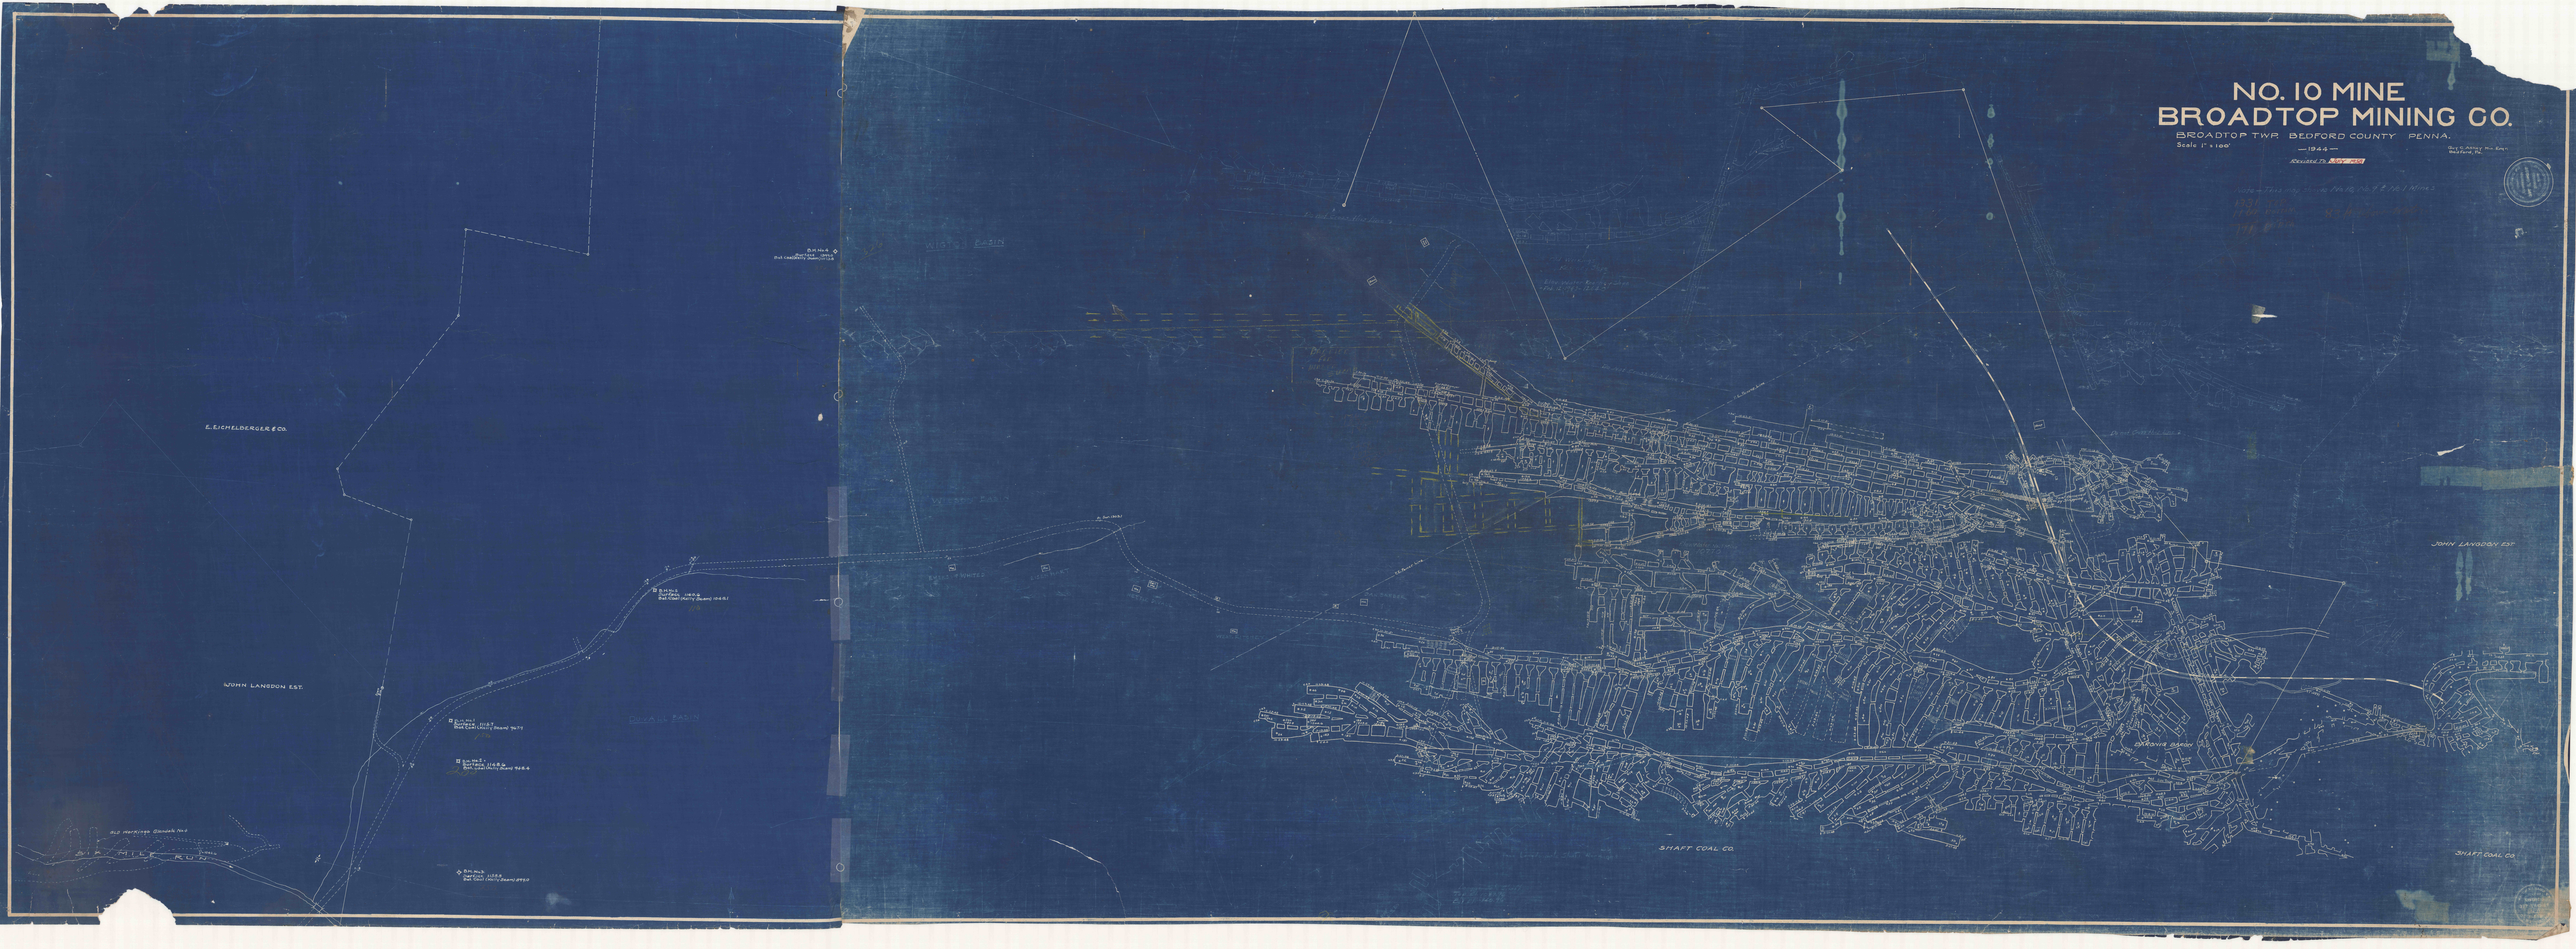
NO. 10 MINE
BROADTOP MINING CO.
BROADTOP TWP. BEDFORD COUNTY. PENNA.
Scale 1" = 100'
— 1944 —
E. EICHELBERGER & CO.
JOHN LANGDON EST.
SHAFT COAL CO.
JOHN LANGDON EST.
SHAFT COAL CO.