


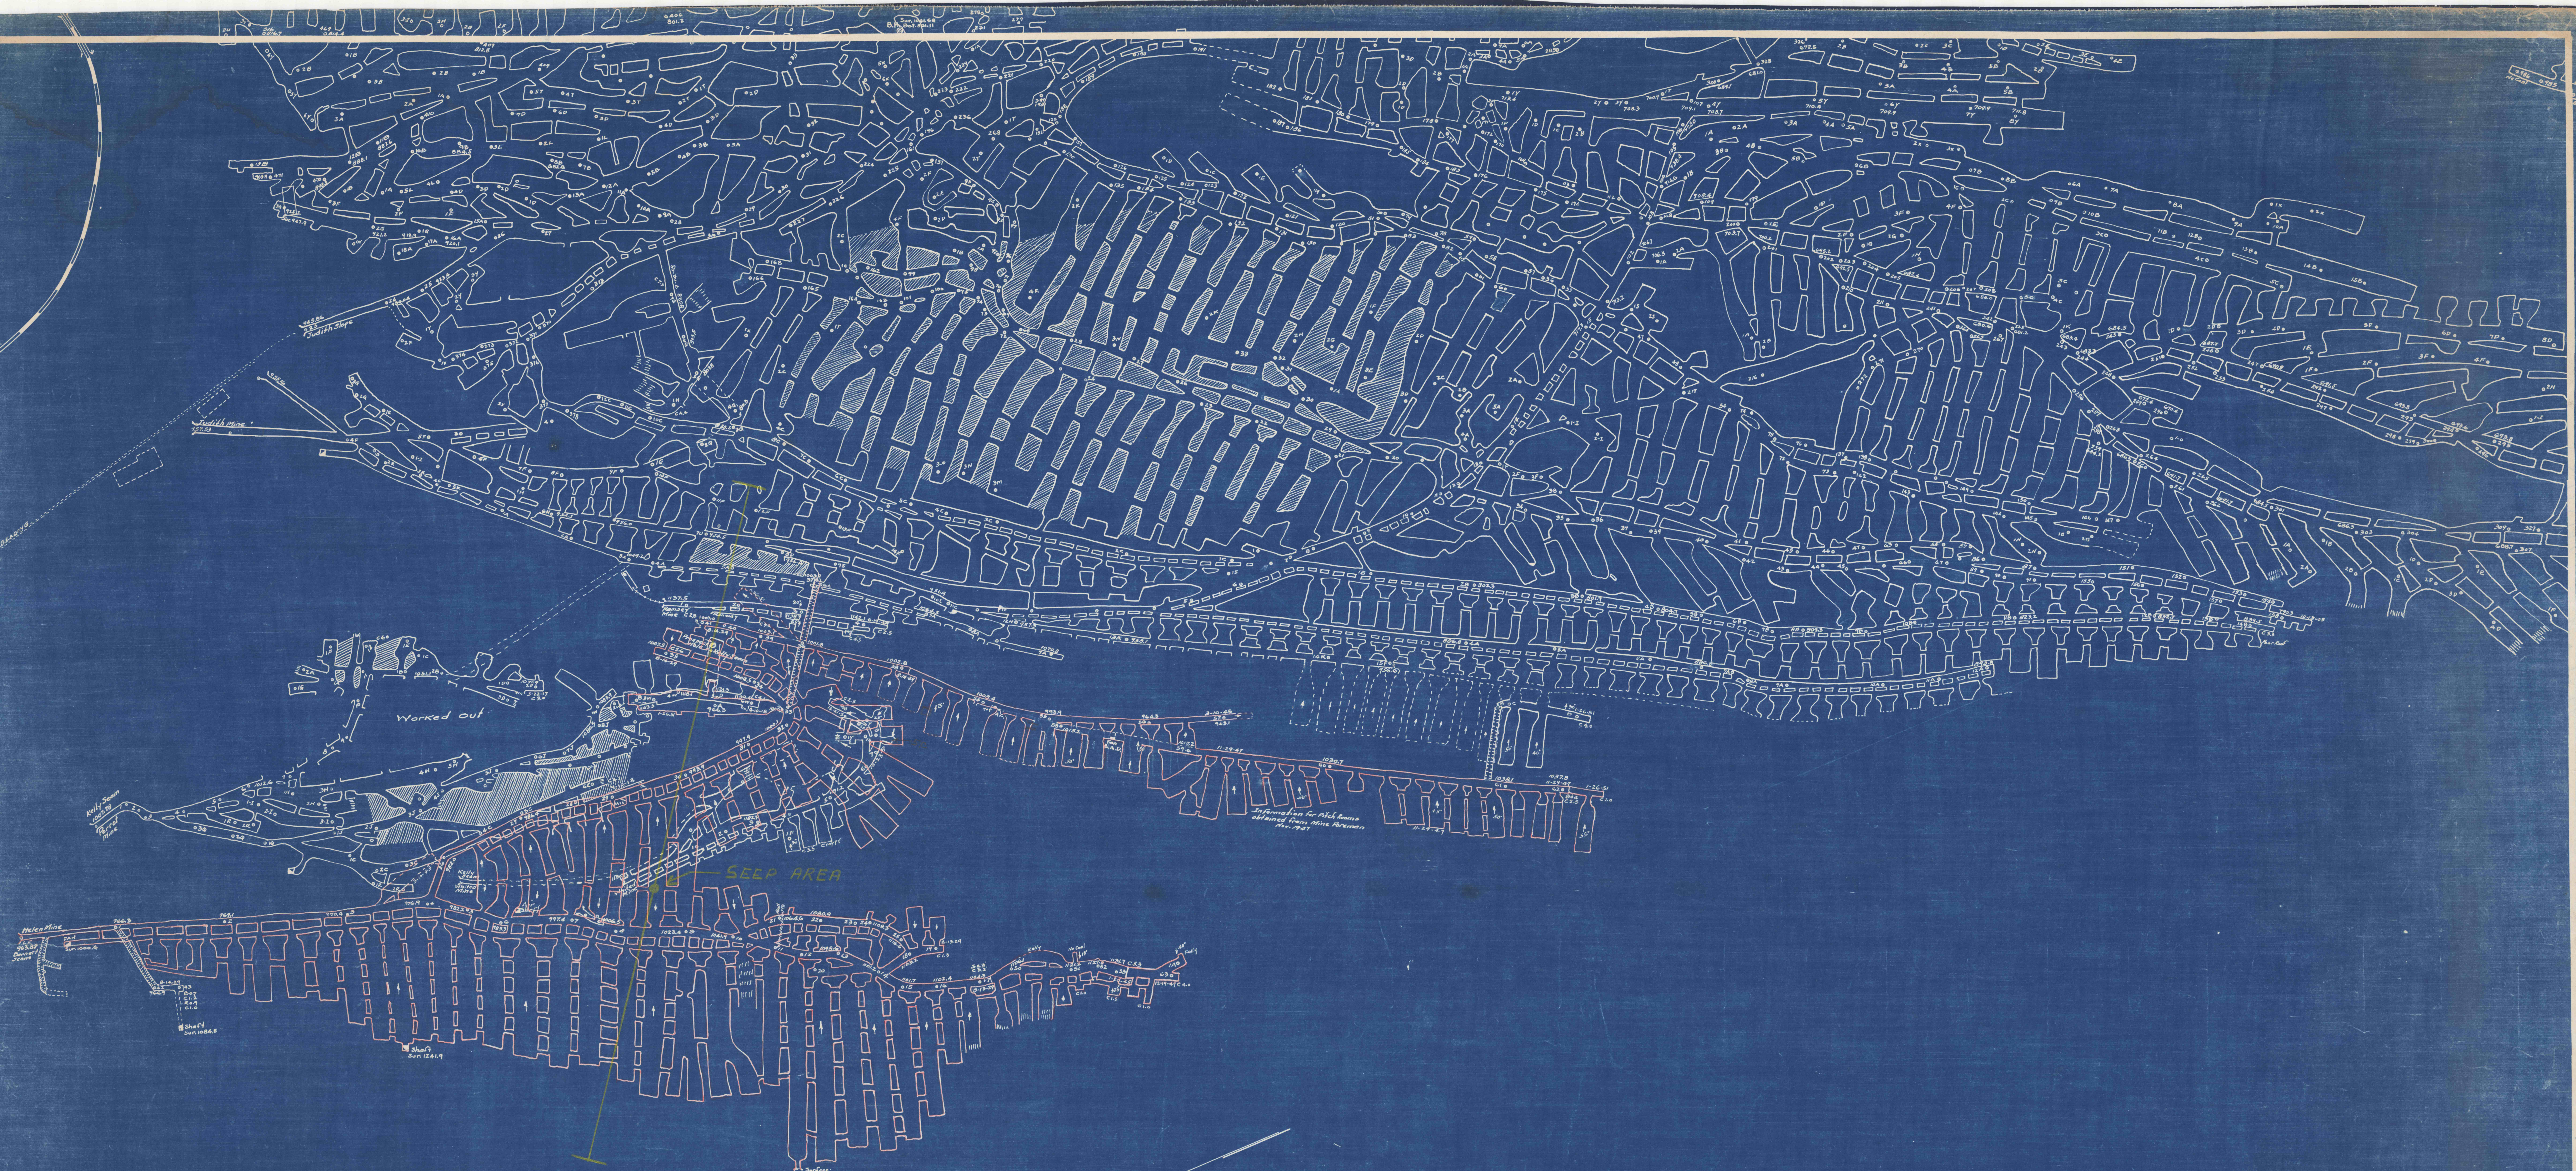

MAP OF
HELEN & JUDITH MINES
BARONIG BARON

RIDDLESBURG — BEDFORD COUNTY — PENNA.

Scale - 1" = 100'

- 1945 -

Guy C. Askey, Min. Engr.
Bedford, Pa.

REVISED TO 1-26-51

HELEN MINE - Barnett Seam
JUDITH MINE - Kelly Seam

