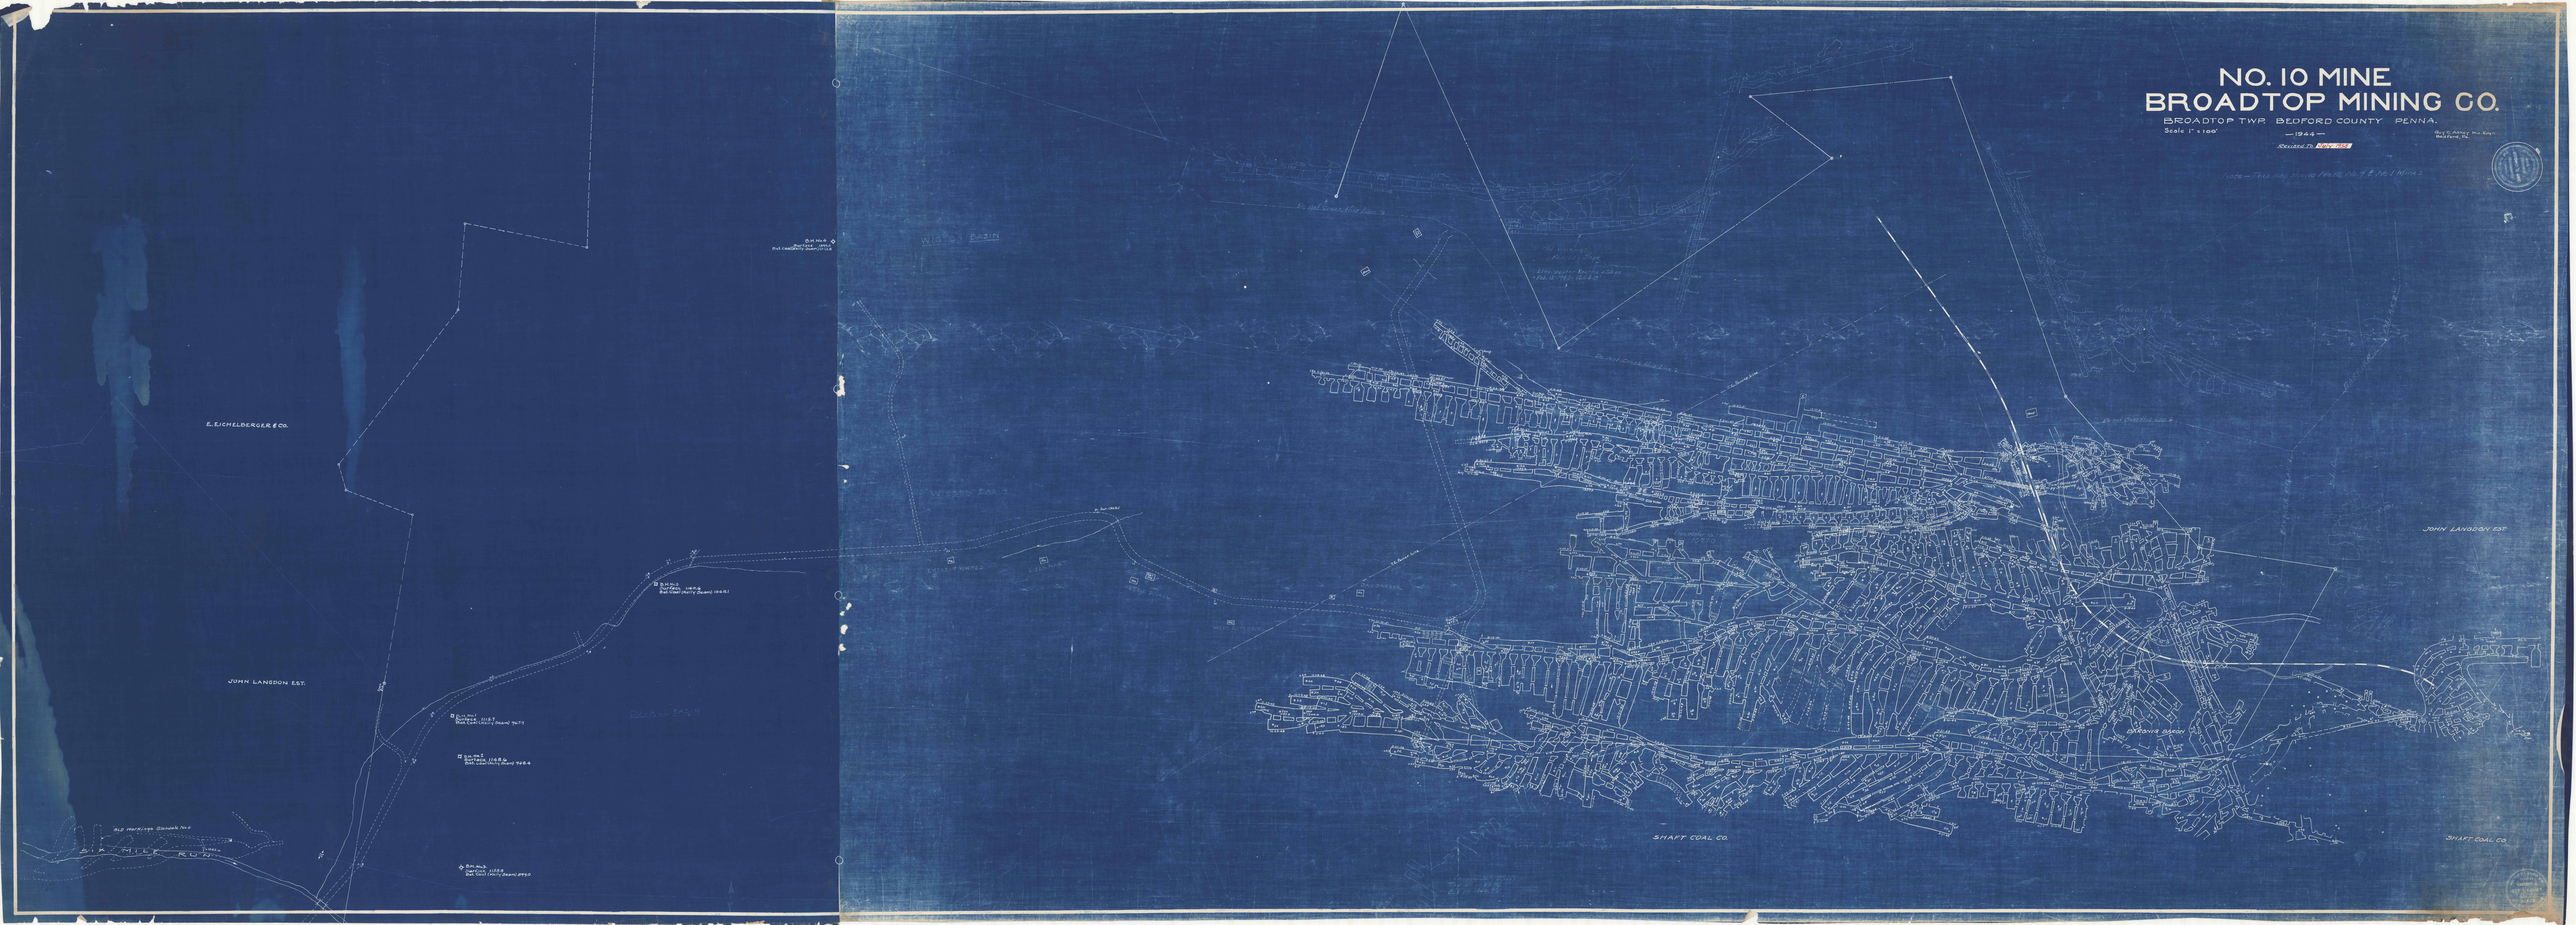
NO. 10 MINE
BROADTOP MINING CO.
BROADTOP TWP BEDFORD COUNTY PENNA.
Scale 1" = 100'
—1944—
Revised To
E. EICHELBERGER & CO.
JOHN LANGDON EST.
JOHN LANGDON EST.
SHAFT COAL CO.
SHAFT COAL CO.
MILL RUN
NEW BASIN
OLD BASIN
D.H. No. 6
D.H. No. 5
D.H. No. 4
D.H. No. 3
D.H. No. 2