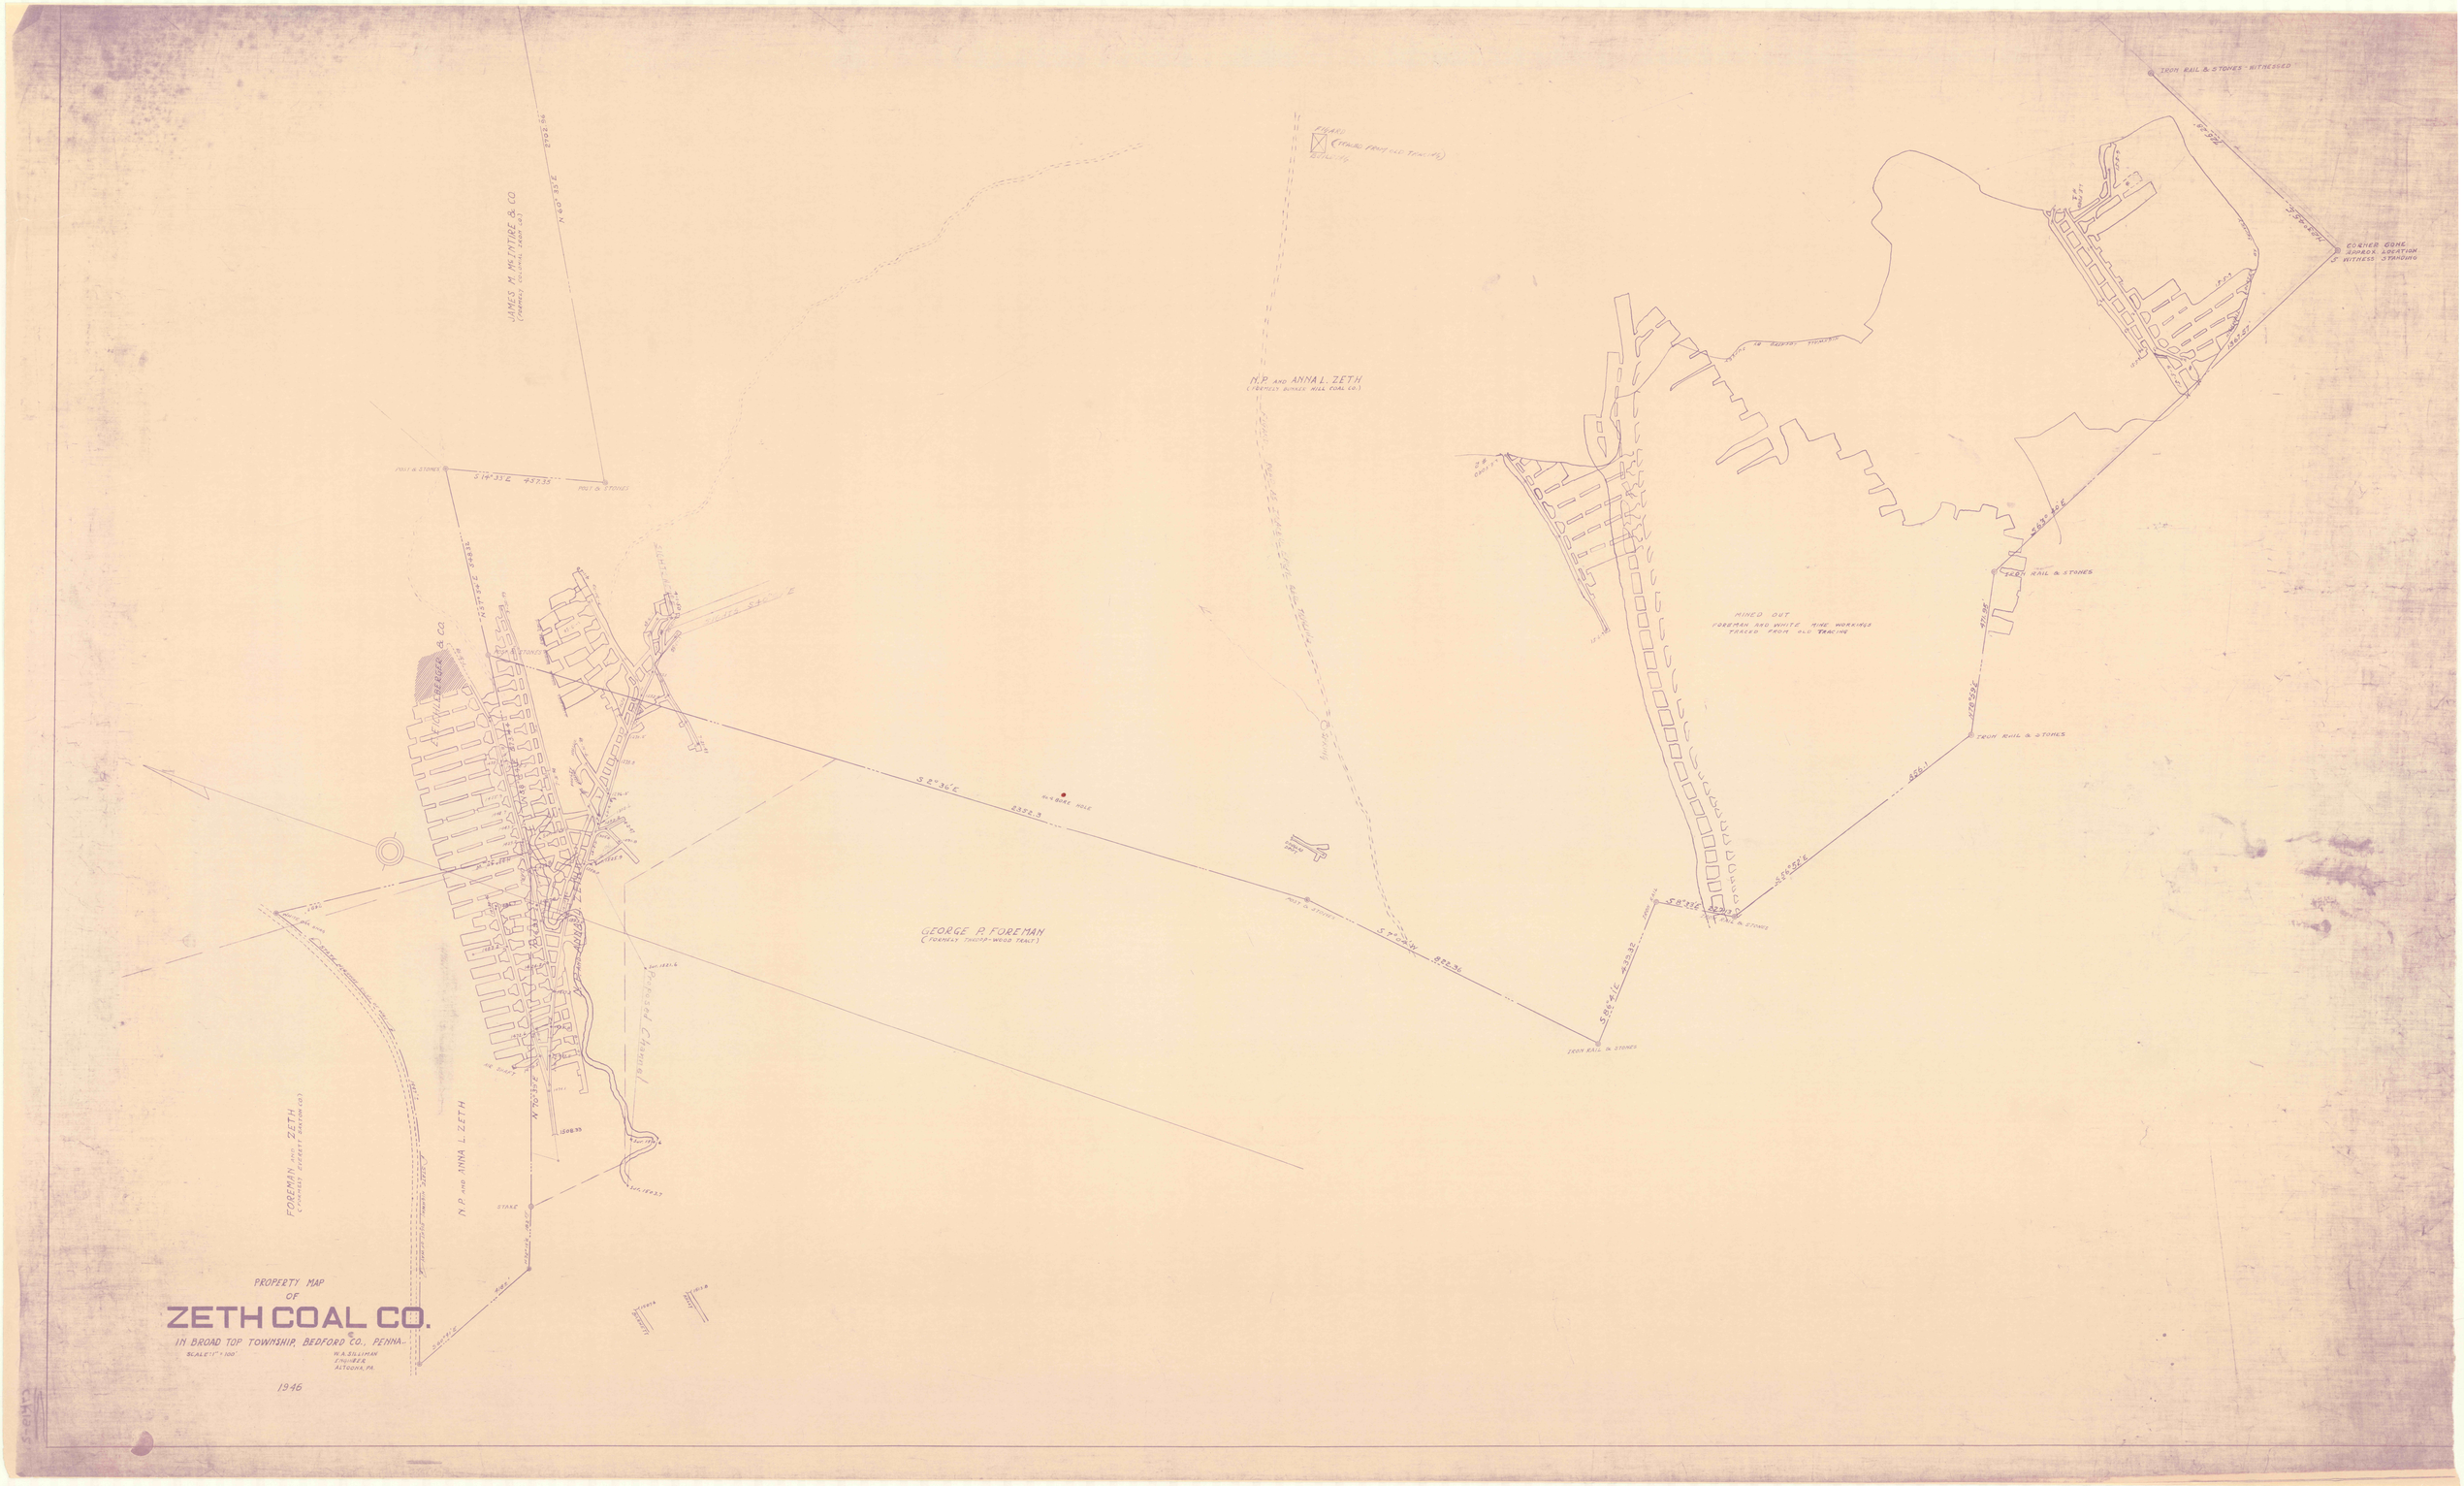
JAMES M. McINTIRE & CO.
(FORMERLY CLEVELAND & BROAD TOP)
N.P. AND ANNA L. ZETH
(FORMERLY BUNKER HILL COAL CO.)
GEORGE P. FOREMAN
(FORMERLY THROP-WOOD TRACT)
FOREMAN AND ZETH
(FORMERLY EVERETT SALTON CO.)
N.P. AND ANNA L. ZETH
A. F. GILLEBERGER & CO.
MINED OUT
FOREMAN AND WHITE MINE WORKINGS
TRACED FROM OLD TRACING
IRON RAIL & STONES - WITNESSED
CORNER GONE
APPROX. LOCATION
WITNESS STANDING
IRON RAIL & STONES
IRON RAIL & STONES
IRON RAIL & STONES
IRON RAIL & STONES
IRON RAIL & STONES
PIPE & STONES
PIPE & STONES
PIPE & STONES
PIPE & STONES
S 16° 35' E 432.35'
S 8° 36' E
835.3
S 8° 36' E
N 60° 35' E
N 76° 15' E
S 56° 41' E 423.32'
S 56° 52' E
S 56° 52' E
S 8° 36' E
S 8° 36' E
S 8° 36