


EDWIN HUMPHREY

751051

1/4 Sec 10 - 2nd 1922 W. 1/2 E. 1/4 10048

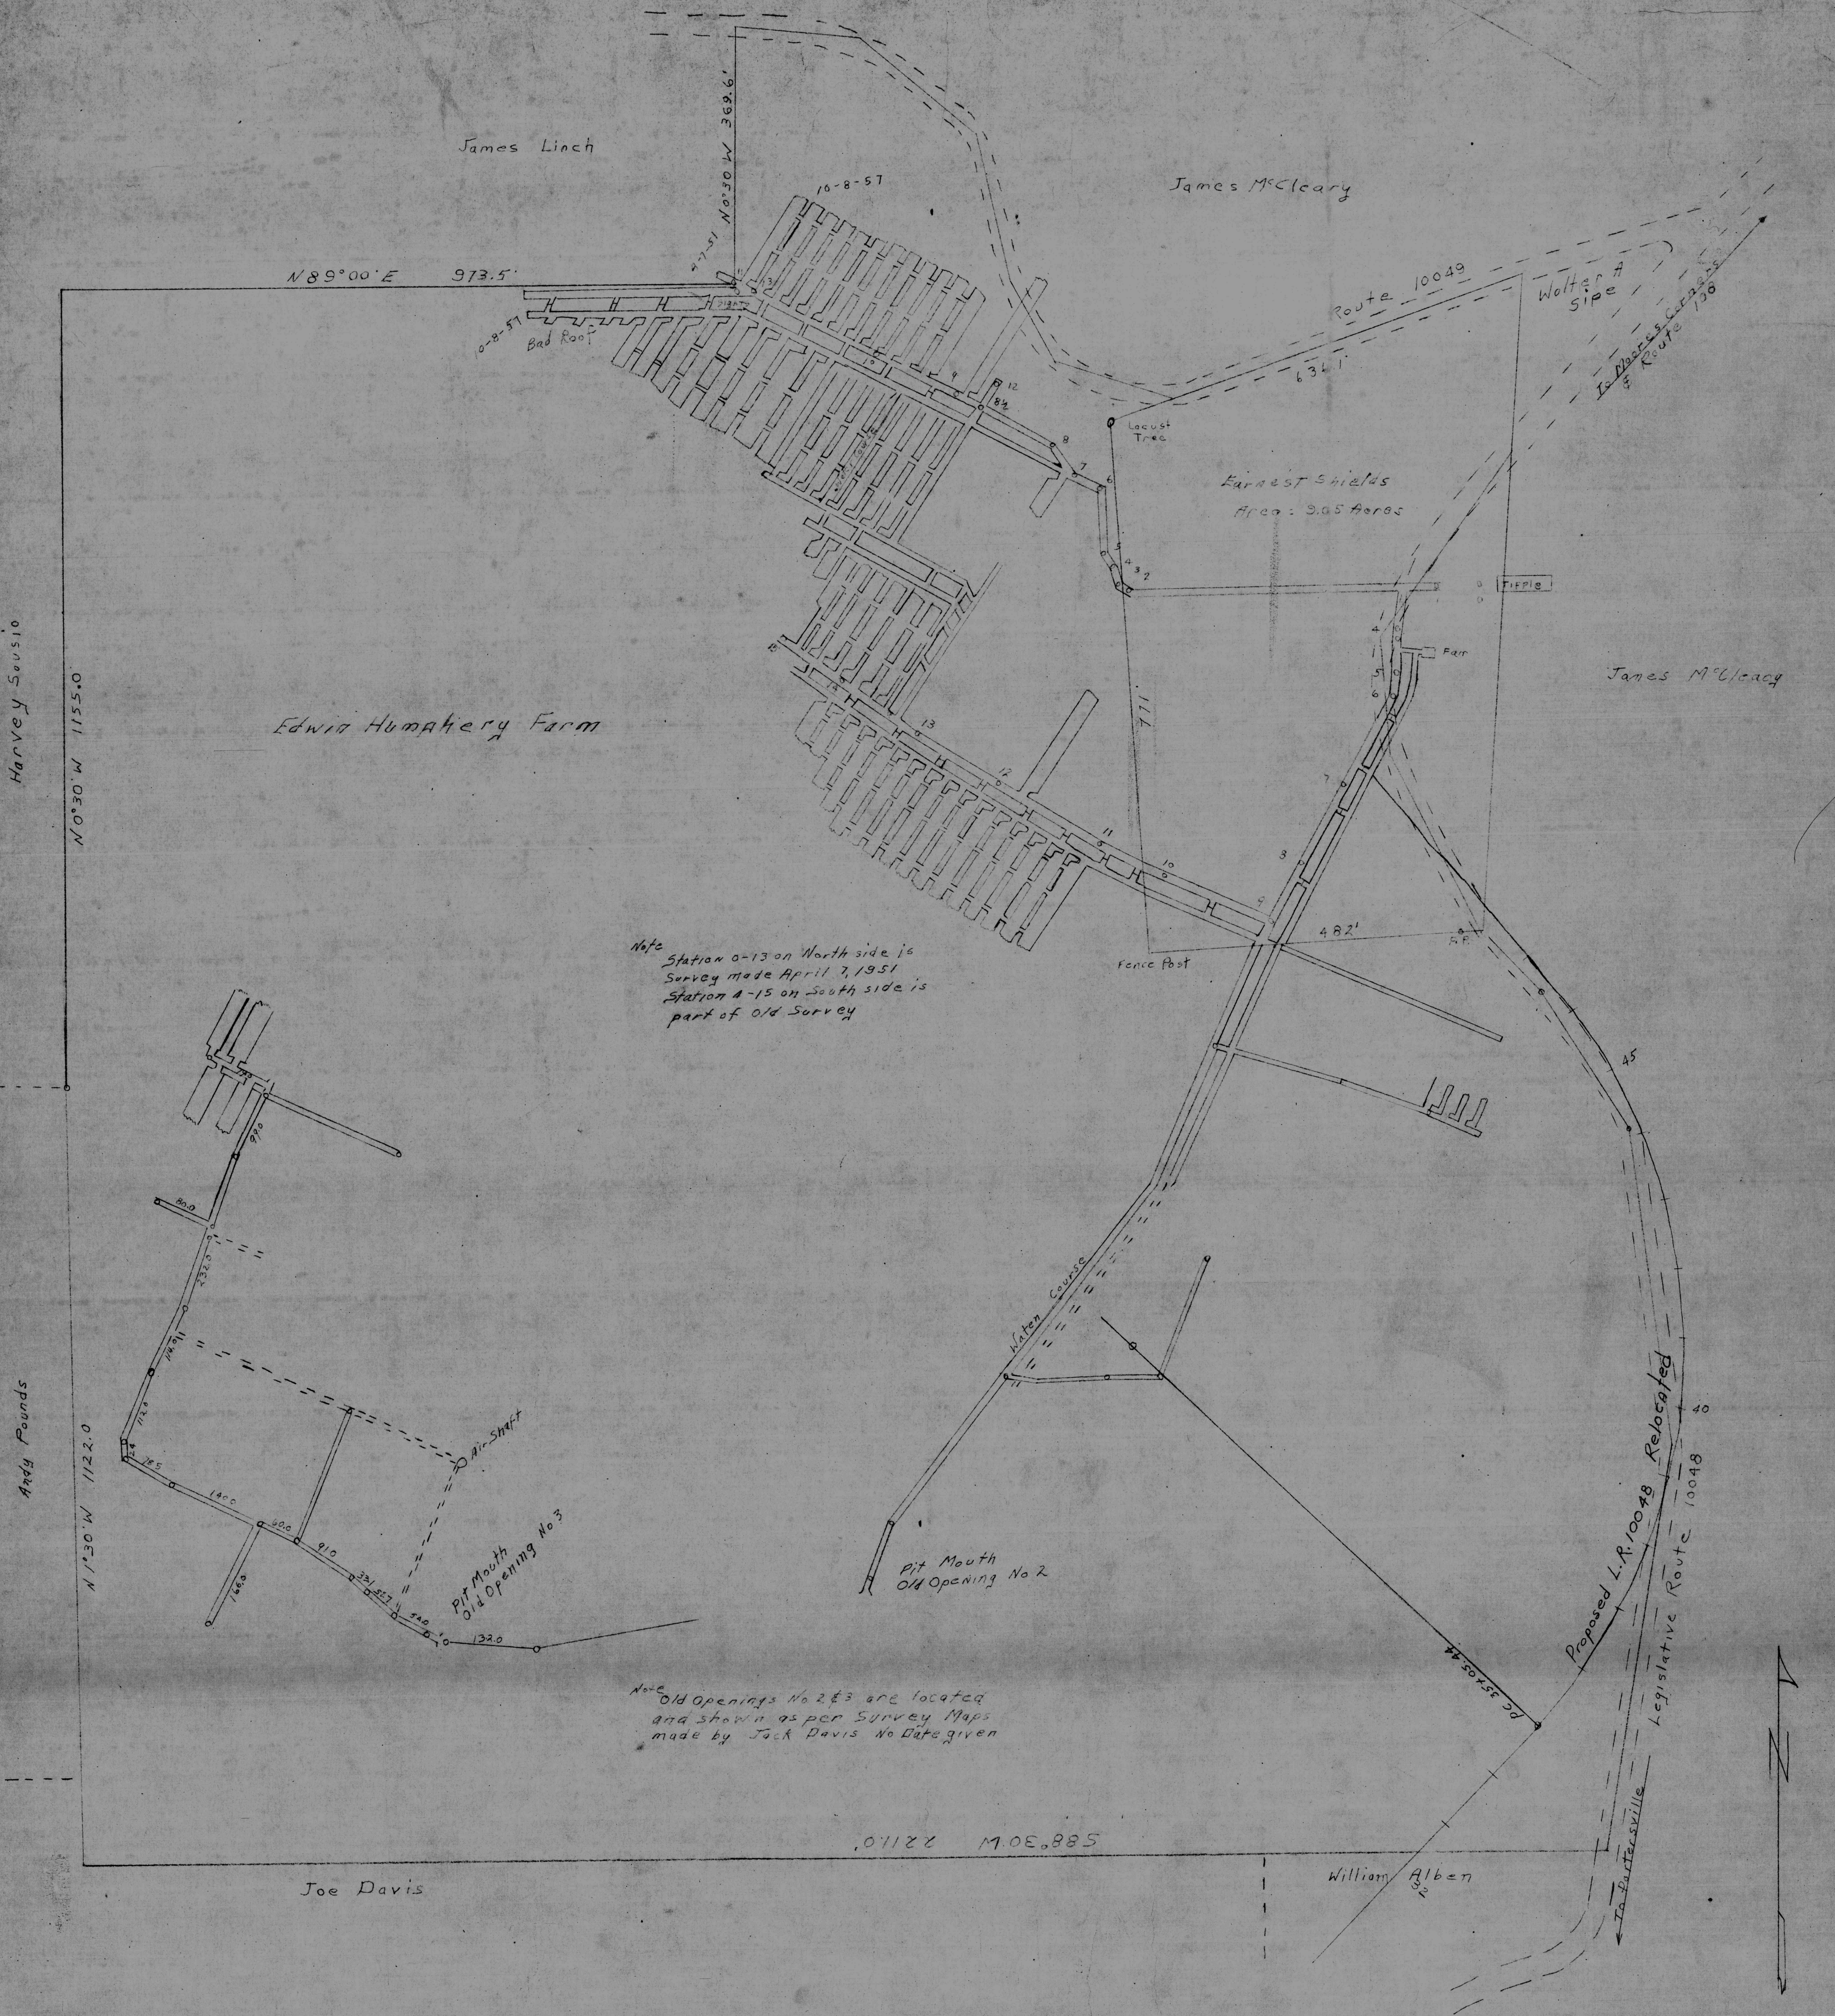

Note
 Station 0-13 on North side is
 Survey made April 7, 1951
 Station A-15 on South side is
 part of Old Survey

Note
 Old Openings No 2 & 3 are located
 and shown as per Survey Maps
 made by Jack Davis No Date given

EARNEST SHIELDS
 MINE MAP

WORTH TWP BUTLER CO PENNA
 SCALE 1" = 100' APRIL 7 1951

W. S. Hines, R.S.
 8477