


DIG

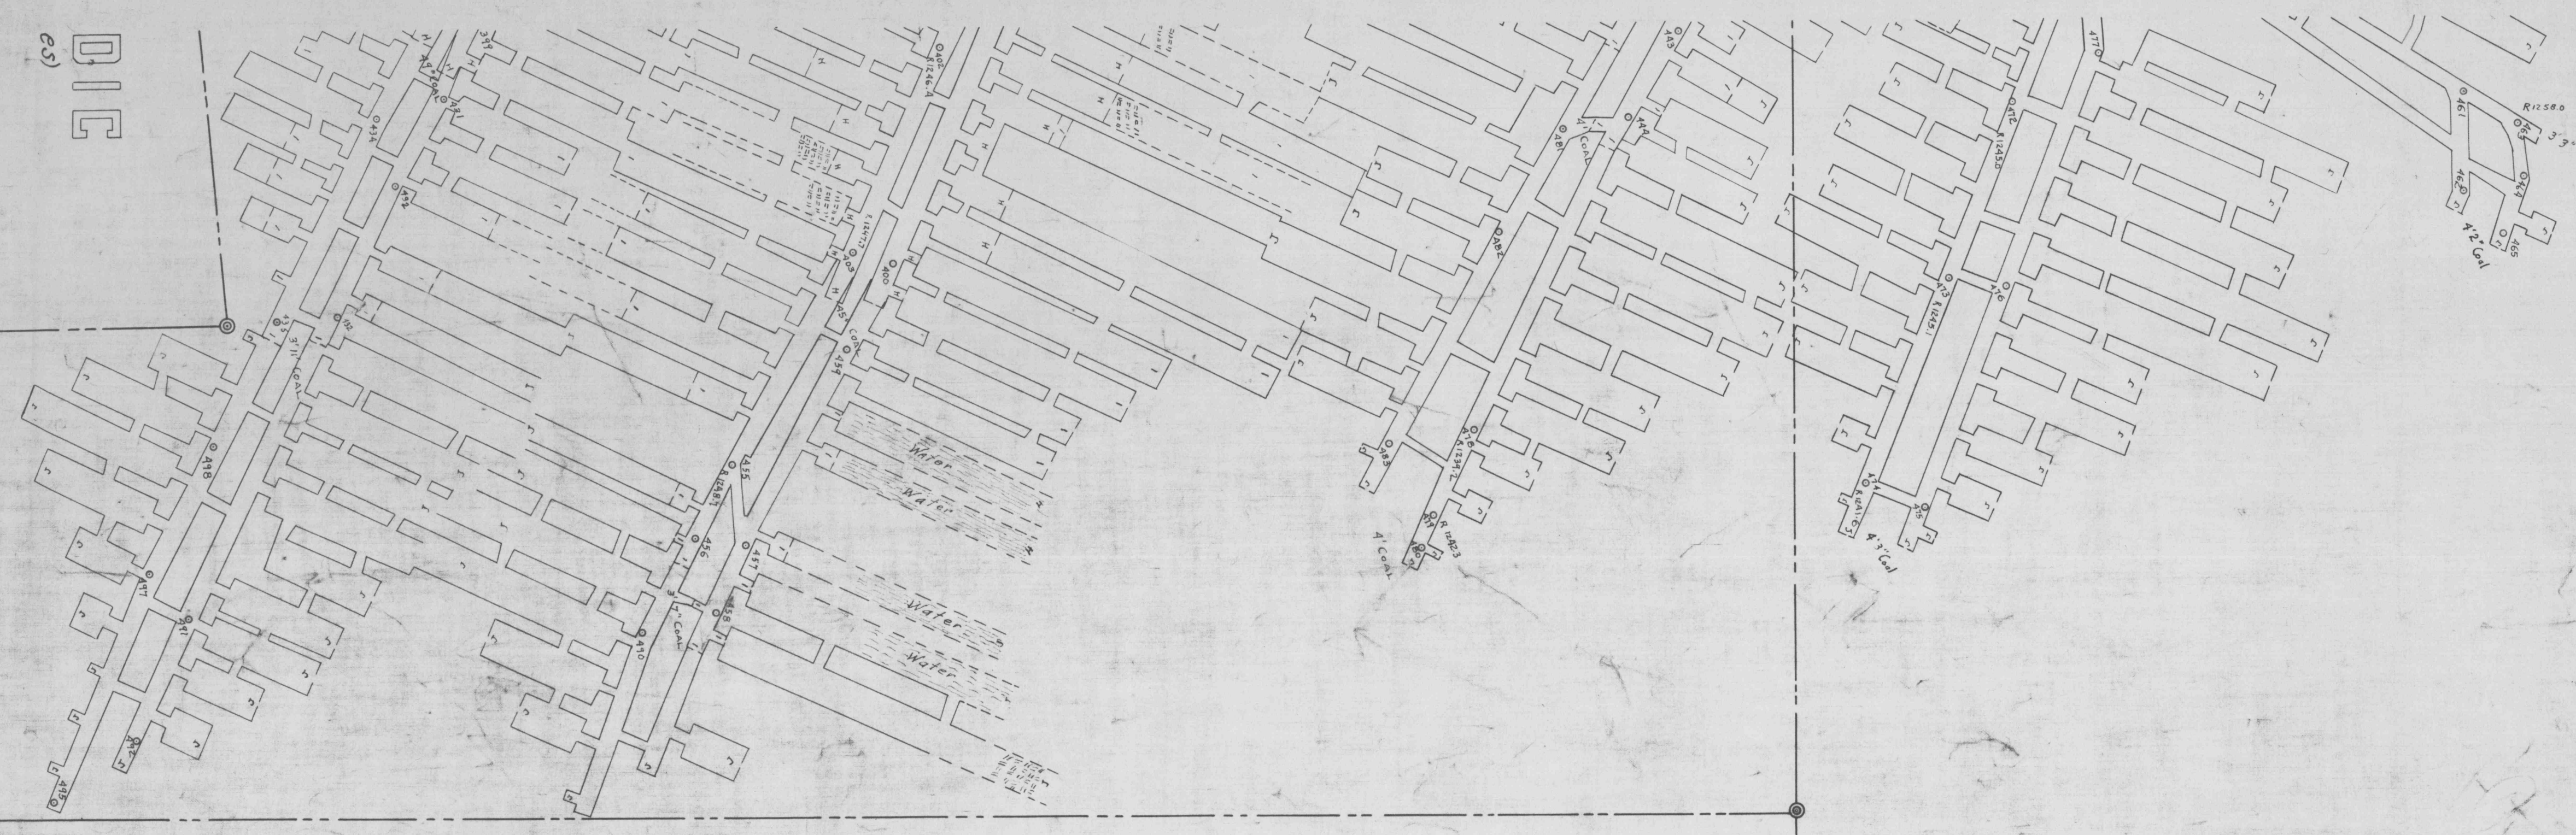

REDDIC HEIRS
7884 Acres

T. HILLIARD
6438 Acres

ARGENTINE COAL Co.
 SHOWN
 ON #12
 1"=100'