


83.16 ACRES

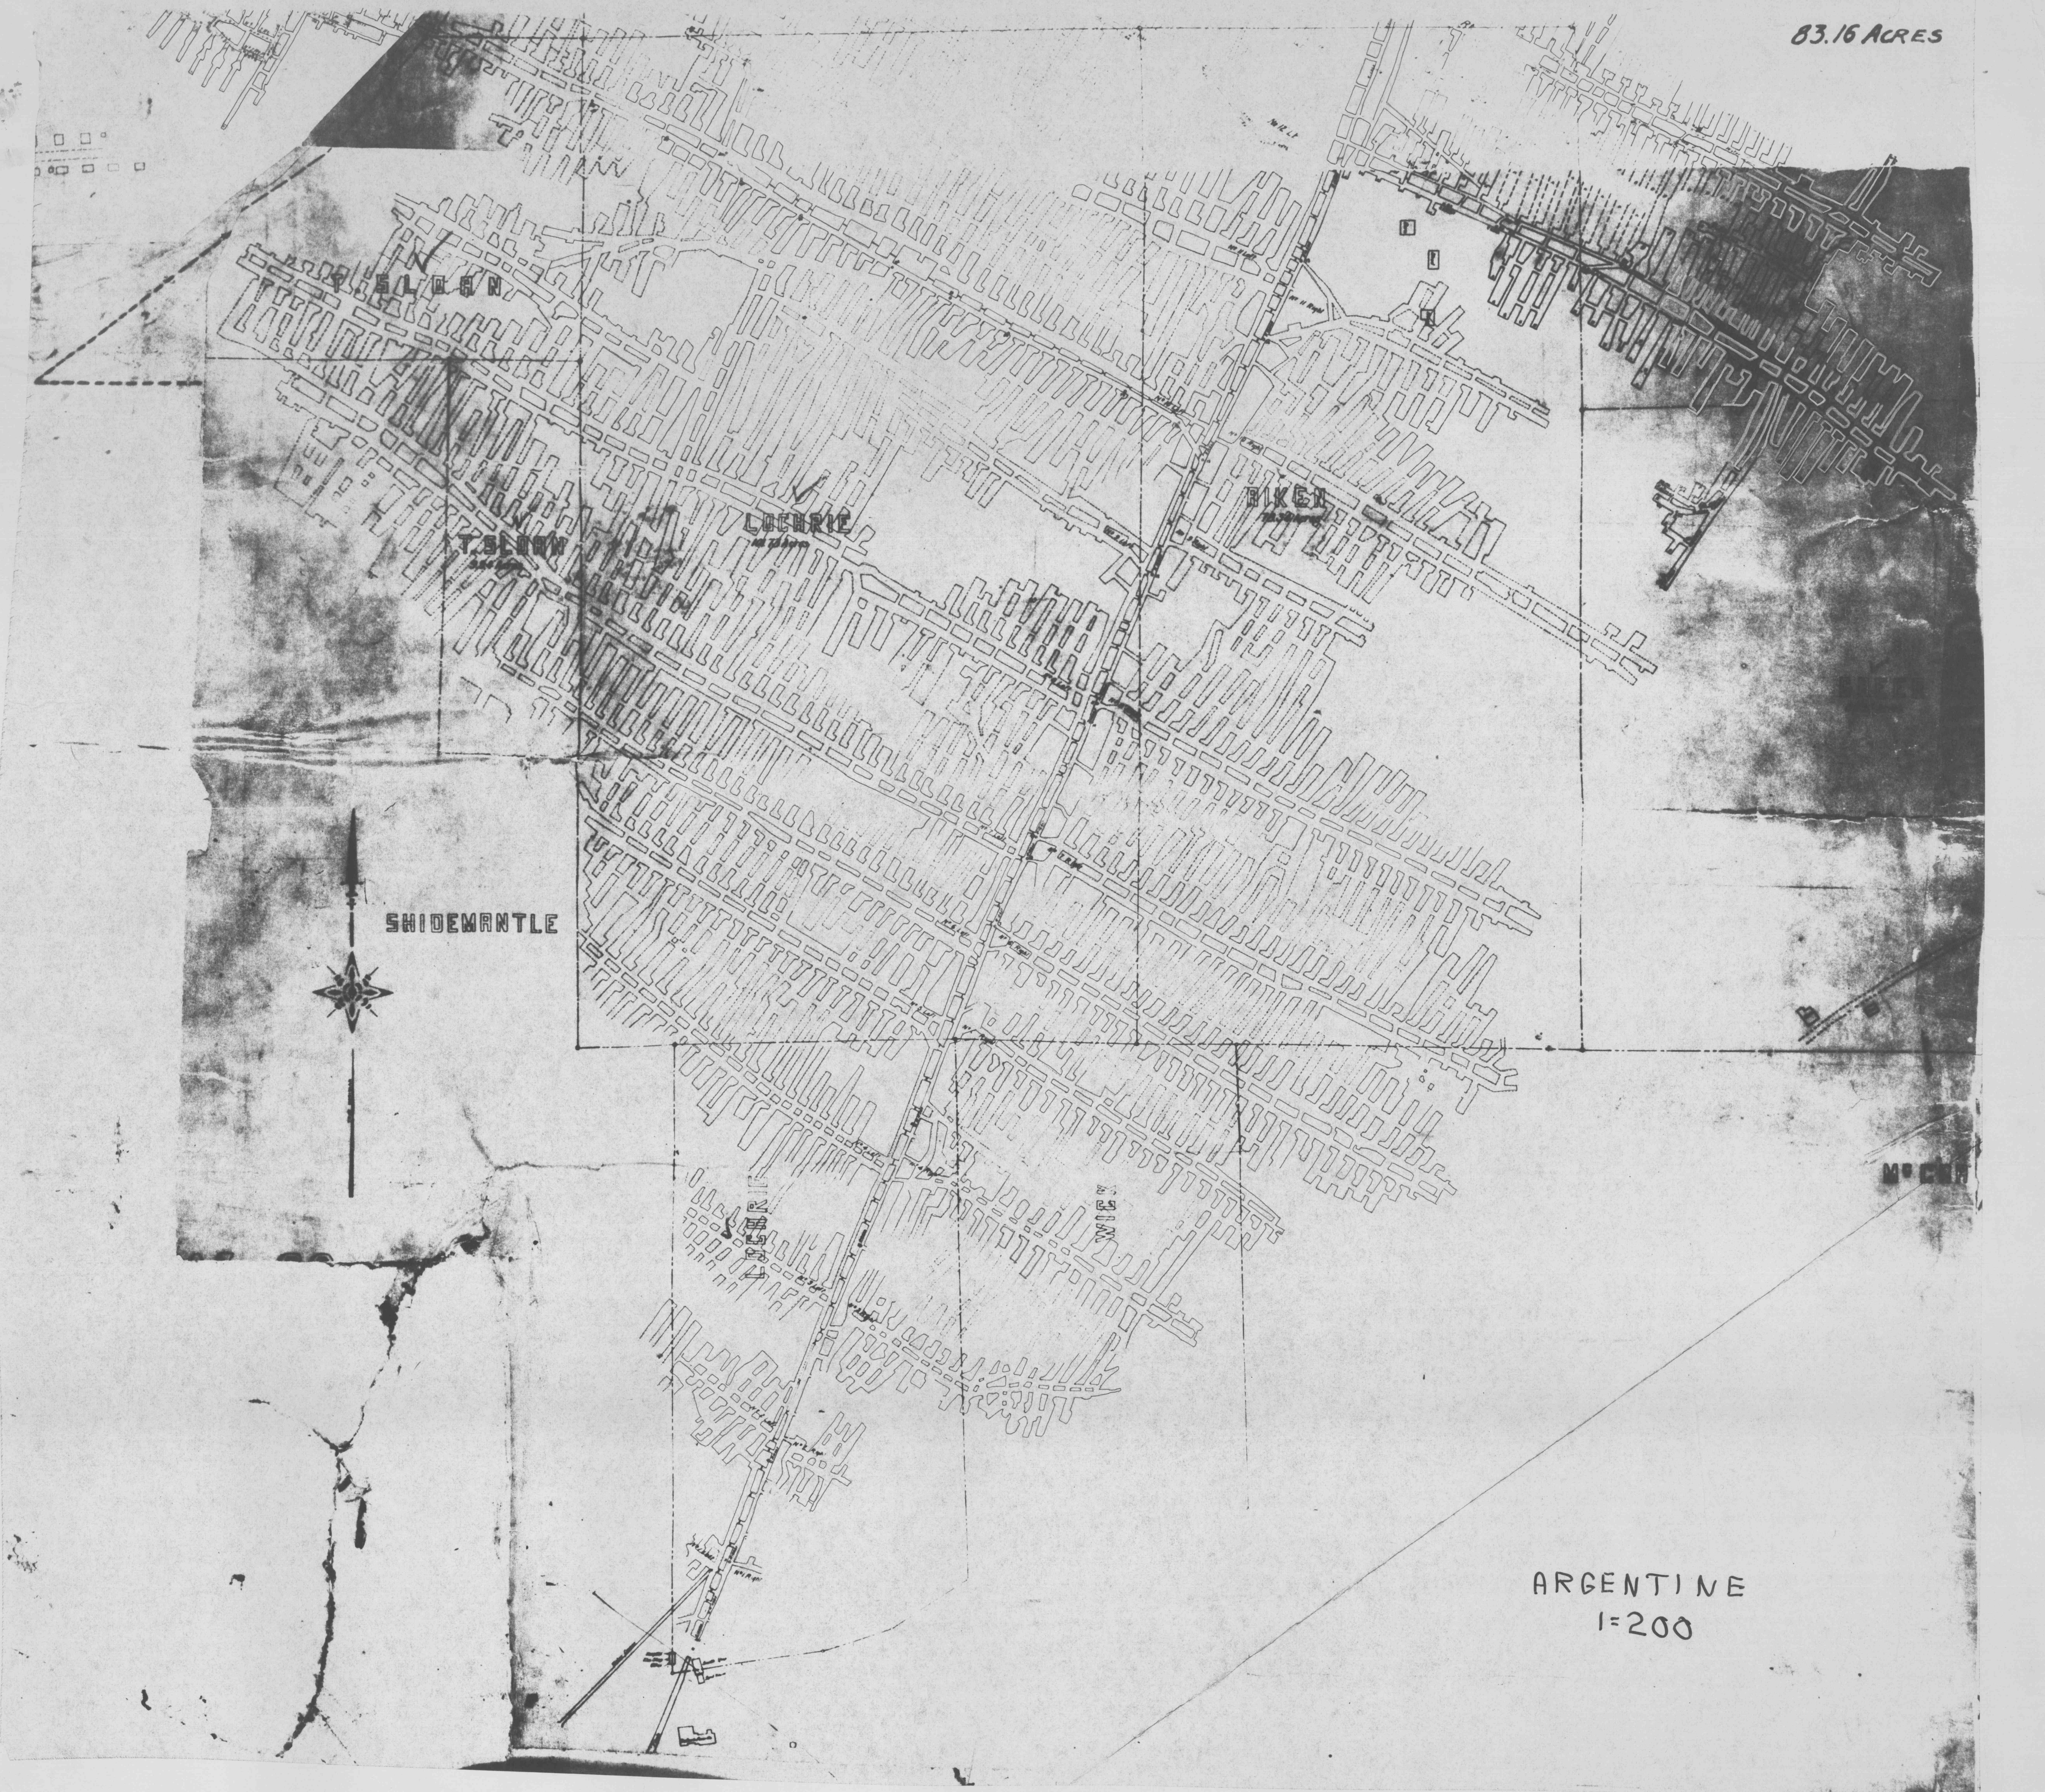

SHIDEMANTLE

ARGENTINE
1=200