



(BUTLER) 1:25000

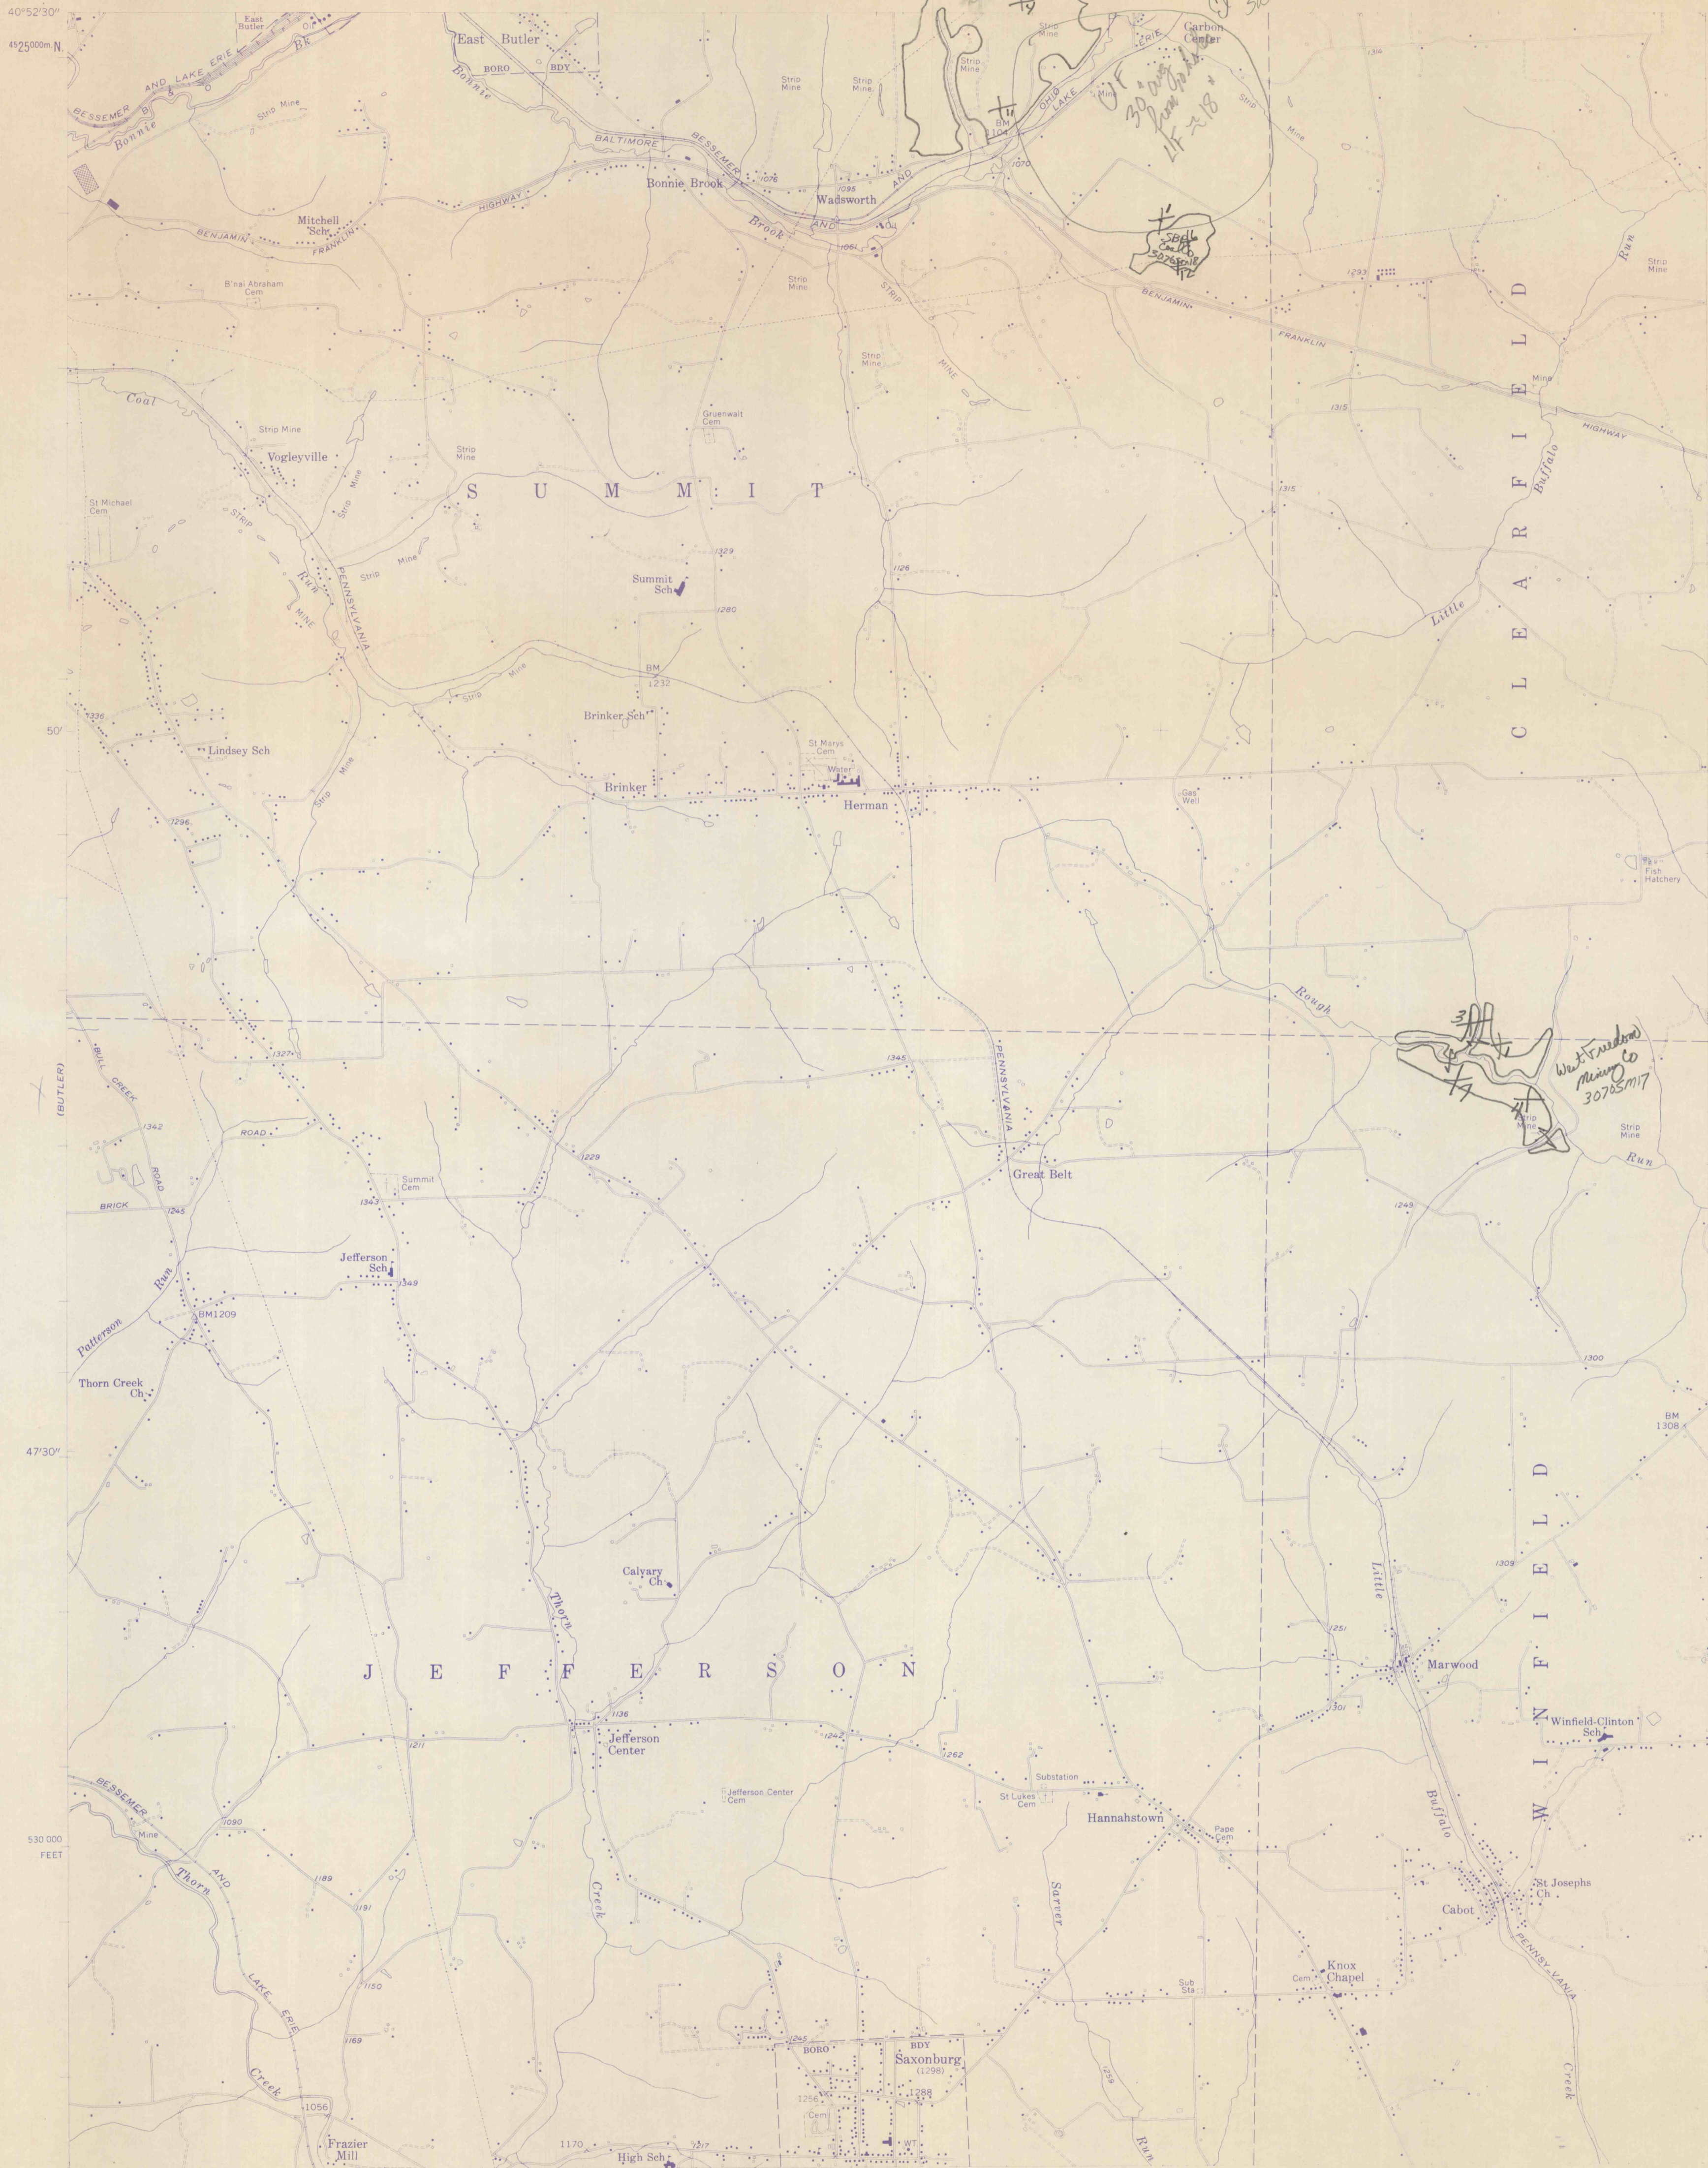

10,000-foot grid based on Pennsylvania coordinate system, south zone
 1000-meter Universal Transverse Mercator grid ticks, zone 17, shown in blue
 Fine red dashed lines indicate selected fence and field lines visible on aerial photographs. This information is unchecked
 Unlabelled wells are oil wells
 Unchecked elevations are shown in brown

APPROXIMATE MEAN DECLINATION, 1958

DATUM IS MEAN SEA LEVEL
 THIS MAP COMPLIES WITH NATIONAL MAP ACCURACY STANDARDS
 FOR SALE BY U. S. GEOLOGICAL SURVEY, WASHINGTON 25, D. C.
 A FOLDER DESCRIBING TOPOGRAPHIC MAPS AND SYMBOLS IS AVAILABLE ON REQUEST

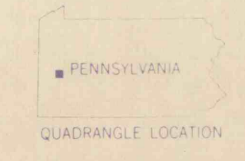

SAXONBURG, PA.
 SE 1/4 BUTLER 15' QUADRANGLE
 N 40 45' W 79 45' 7.5

1958