


# FORGE COAL MINING CO. NO. 1 SLOPE.

SCALE 1"=100'

W. SILLIMAN,  
ENGINEER.

WORKINGS SHOWN BY DASHED LINES COPIED FROM MAP BY A. B. CRICHTON.

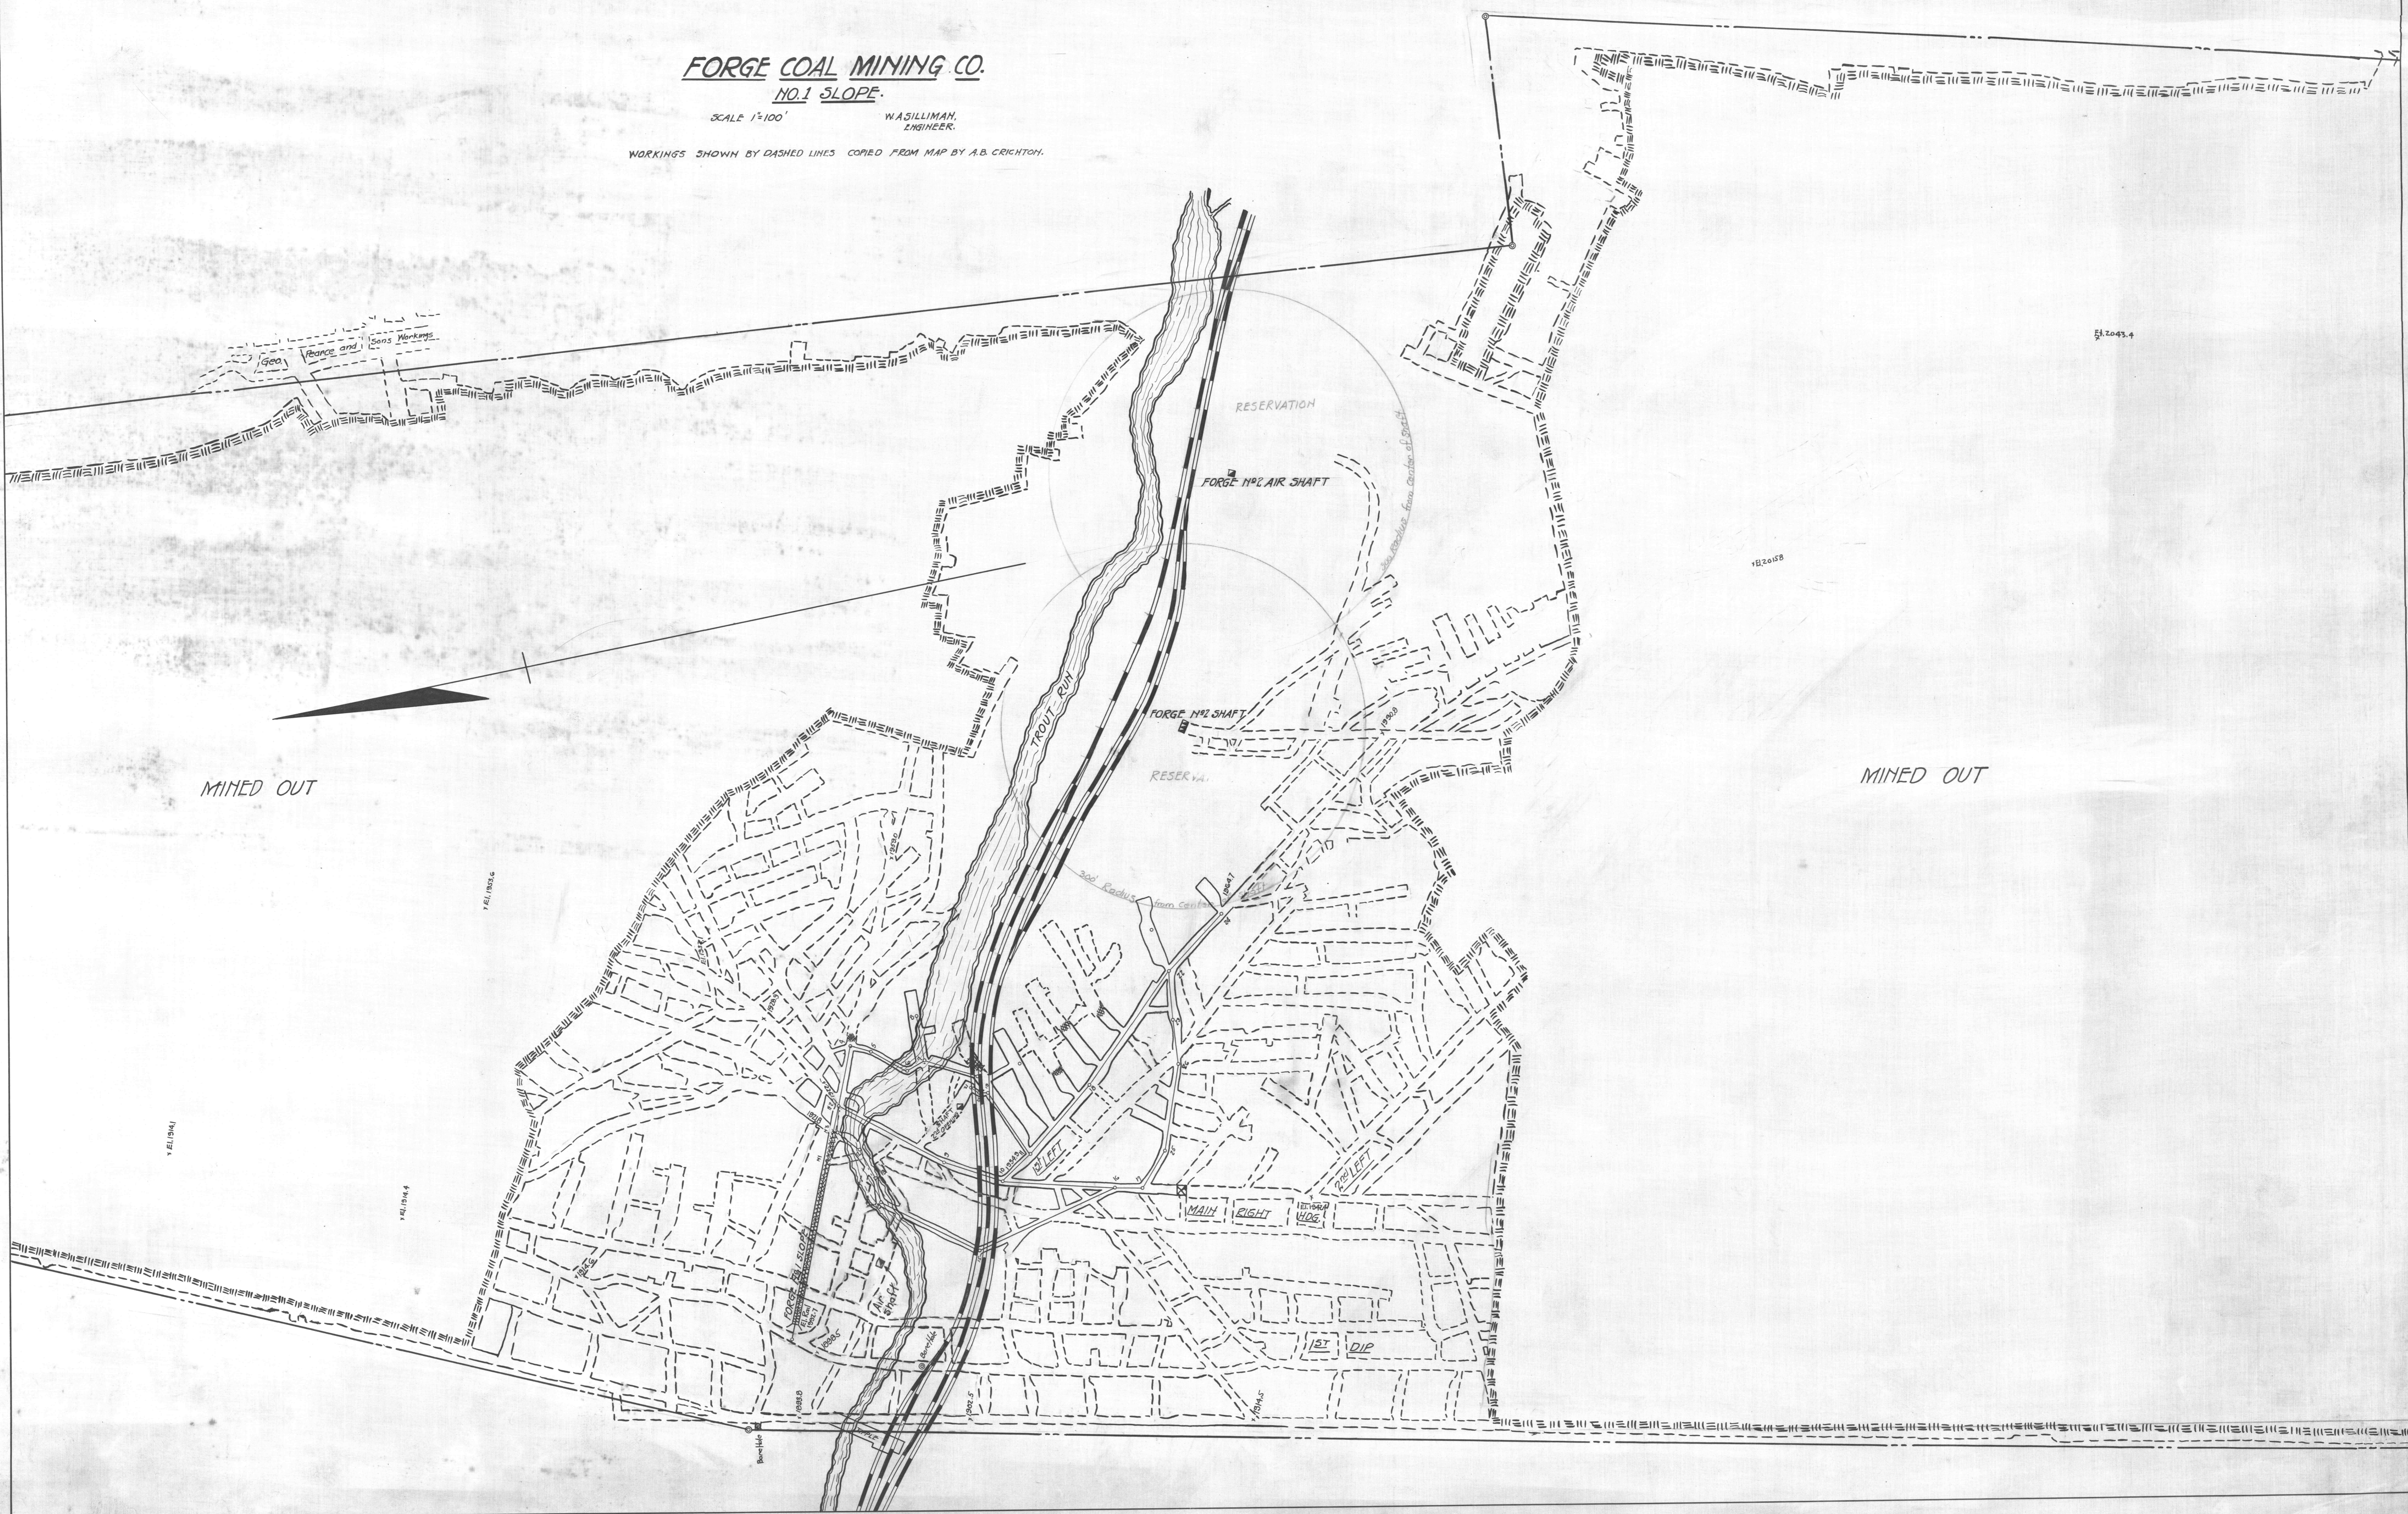

MINED OUT

MINED OUT